

BRITISH RAILWAYS DIAGRAMS OF PRIVATE OWNERS STOCK (P)

PART 2

© COPYRIGHT NOTICE

This PDF file has been created from the original book with permission of BRB Residuary Ltd who, retain copyright in the original document.

This PDF version is by David Faulkner, 2010.

Individuals may: use, retain and print out this PDF version for their private information or for that of their non-commercial enthusiast society or railway club.


This document and any copies produced from it in any form may not be sold or lent for any payment in any form other than to cover copying or transmission costs. No reproduction permitted in any other form or circumstance without prior permission from the original copyright holder

TANK WAGON

TROO2A

EXCESS LENGTH	H	M	L	E
tonnes	22	22	8	8
VB				
AB				
RA	I	I	I	I
MAX. SPEED	45	45	45	45

TOPS CODE					
CARKND	AARKND		OPERATING PANEL No.		
T	R	Ø	T	R	Ø
			A	7	8
				8	

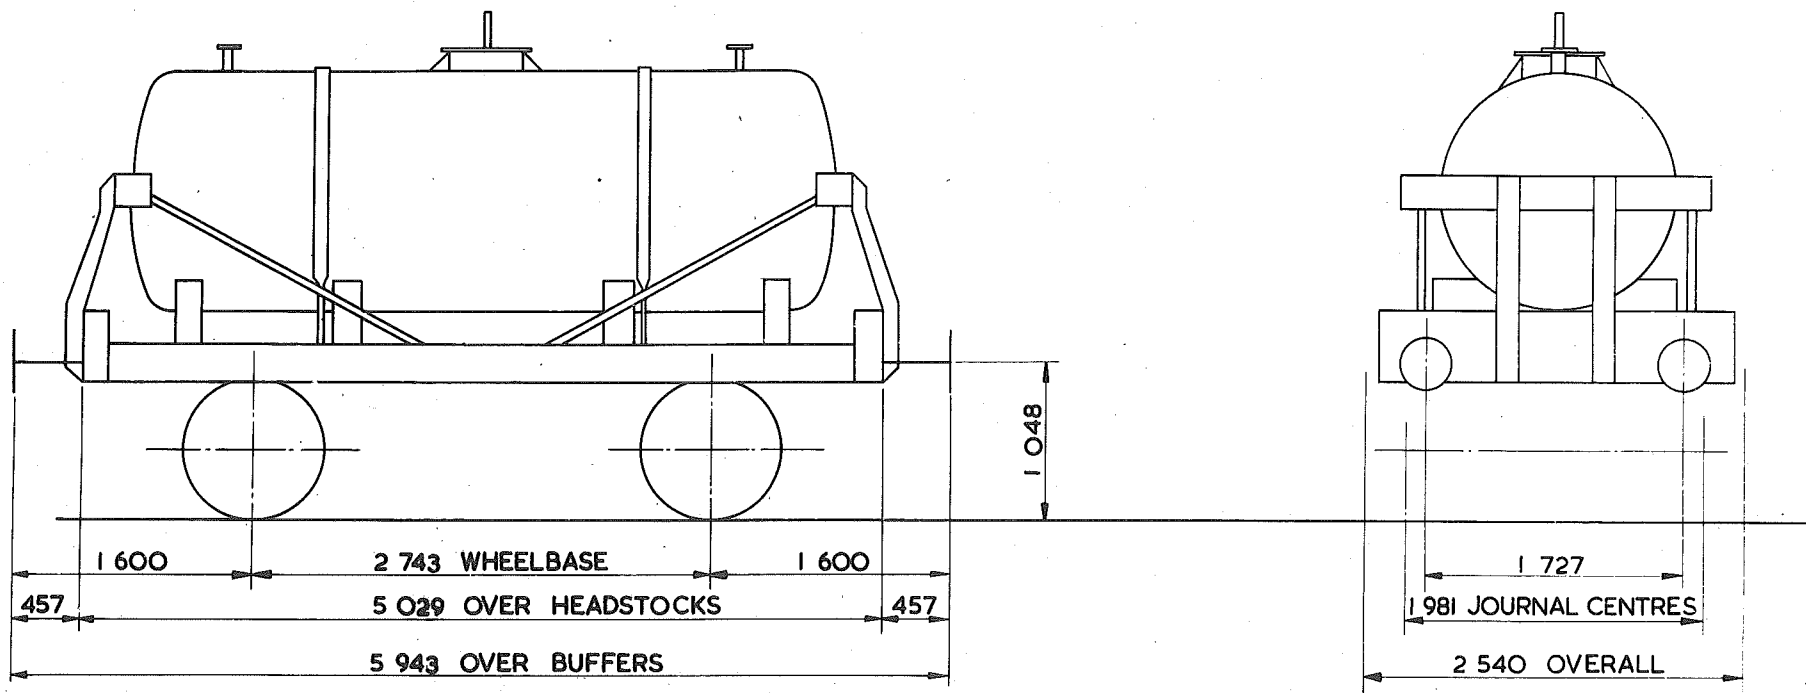

TARE -	8850 kg
CARRYING CAPACITY -	14000 kg
CAPACITY -	
MAX. SPEED -	45 mile/h.
WHEELS -	952 DIA.
JOURNALS -	228 x 114 PLAIN BEARINGS

BUFFERS -	SPINDLE 330 DIA. HEADS
COUPLINGS -	INSTANTER
MIN. CURVE -	21m
GEN. ARRGT. DRG. No. -	
BRAKE -	HAND LEVER
SUSPENSION -	SHOE


BUILDER -	HURST NELSON
OWNER -	M.O.D.A.
REGISTERED BY -	C.M. & E.E. (B.R.B.) DERBY
YEAR BUILT -	1941
REGISTRATION Nos. -	40273 A0282
OWNERS Nos. -	14

TANK WAGON

TROO3A

EXCESS LENGTH	H	M	L	E
tonnes	22	22	8	8
VB				
AB				
RA	I	I	I	I
MAX. SPEED	45	45	45	45

TOPS CODE					
CARKND		AARKND		OPERATING PANFL No.	
T	R	Ø	T	R	Ø
A				7	8 8

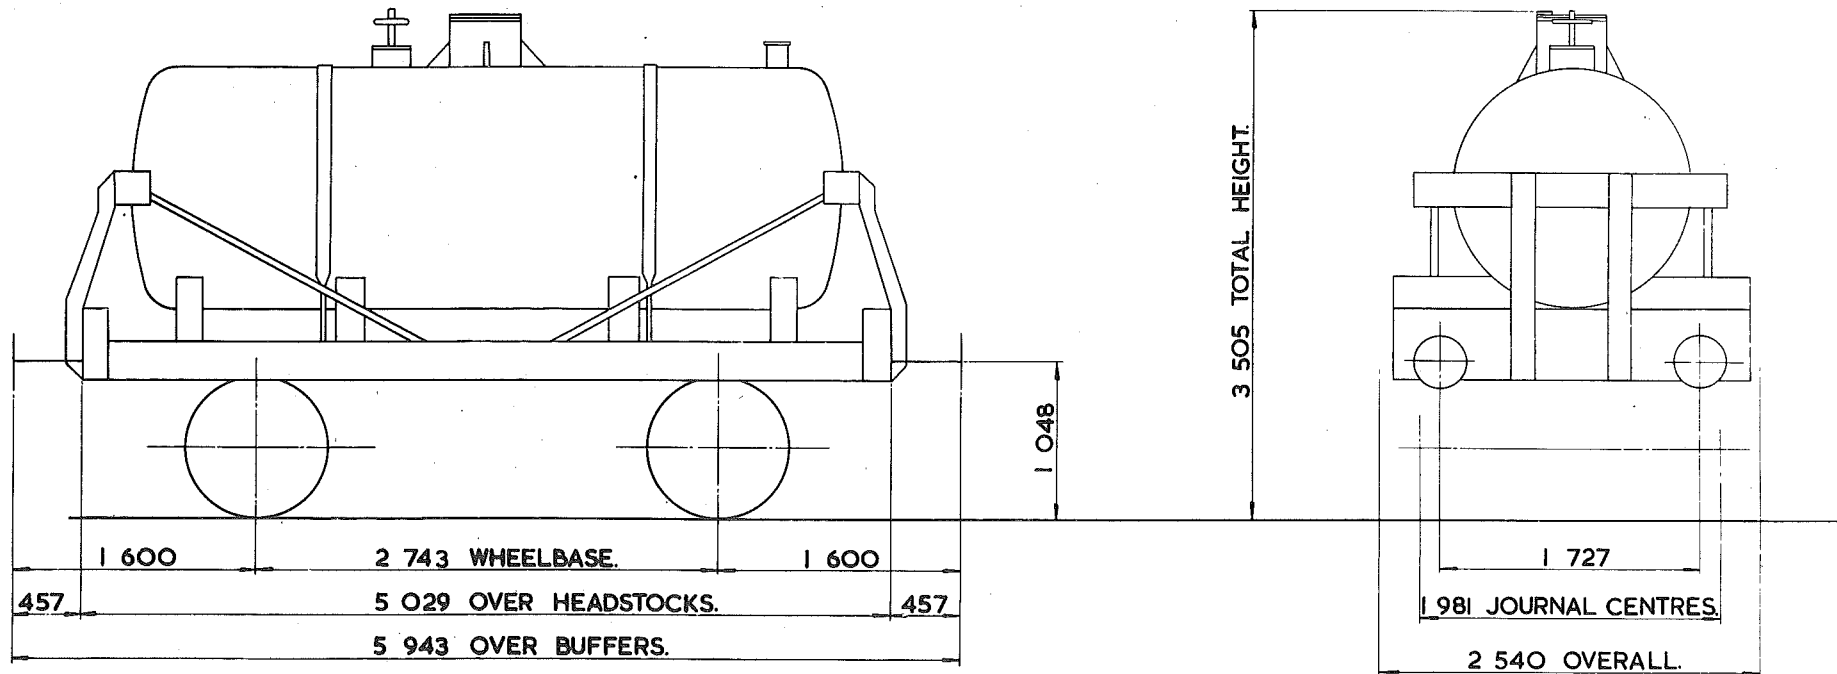

TARE—	8500 kg.
CARRYING CAPACITY—	14000 kg.
CAPACITY—	
MAX. SPEED—	45 mile/h
WHEELS—	952 DIA.
JOURNALS—	228x114 PLAIN BEARINGS.

BUFFERS—	SPINDLE 330 DIA. HEADS.
COUPLINGS—	INSTANTER.
MIN. CURVE—	21m.
GEN. ARRGT. DRG. No.—	
BRAKE—	HANDLEVER
SUSPENSION—	SHOE


BUILDER—	CHARLES ROBERTS.
OWNER—	M. O. D. A.
REGISTERED BY—	C. M. & E. E. (B. R. B.) DERBY.
YEAR BUILT—	1940
REGISTRATION Nos.—	40270 40279
OWNERS Nos.—	7

TANK WAGON

TROO3B

EXCESS LENGTH	H	M	L	E
tonnes	22	22	8	8
VB				
AB				
RA	I	I	I	I
MAX. SPEED	45	45	45	45

TOPS CODE		
CARKND	AARKND	OPERATING PANEL No
T R Ø	T R Ø A	7 8 8

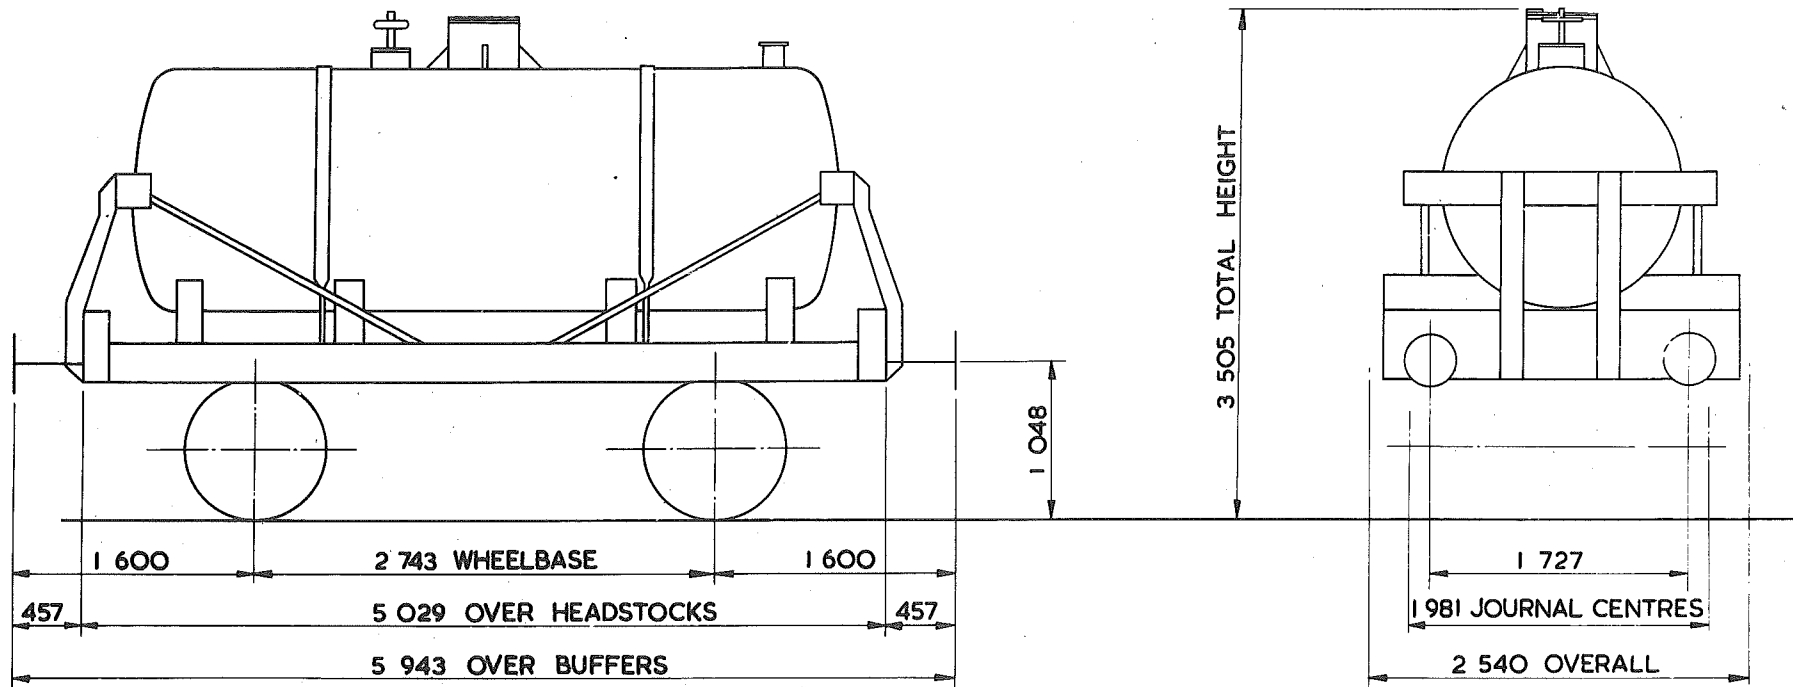

TARE -	8450 kg
CARRYING CAPACITY -	14000 kg
CAPACITY -	
MAX. SPEED -	45 mile/h
WHEELS -	952 DIA.
JOURNALS -	228x114 PLAIN BEARINGS

BUFFERS -	SPINDLE 330 DIA. HEADS
COUPLINGS -	INSTANTER
MIN. CURVE -	21m
GEN. ARRGT. DRG. No. -	
BRAKE -	HAND LEVER
SUSPENSION -	SHOE


BUILDER -	CHARLES ROBERTS
OWNER -	M.O.D.A.
REGISTERED BY -	C.M. & E.E. (B.R.B.) DERBY
YEAR BUILT -	1941
REGISTRATION Nos. -	40271 40280
OWNERS Nos. -	12

TANK WAGON

TR003C

EXCESS LENGTH	H	M	L	E
tonnes	22	22	22	8
VB				
AB				
RA	I	I	I	I
MAX SPEED	45	45	45	45

TOPS CODE					
CARKND	AARKND		OPERATING PANEL No		
T	R	Ø	T	R	Ø
A			7	8	8

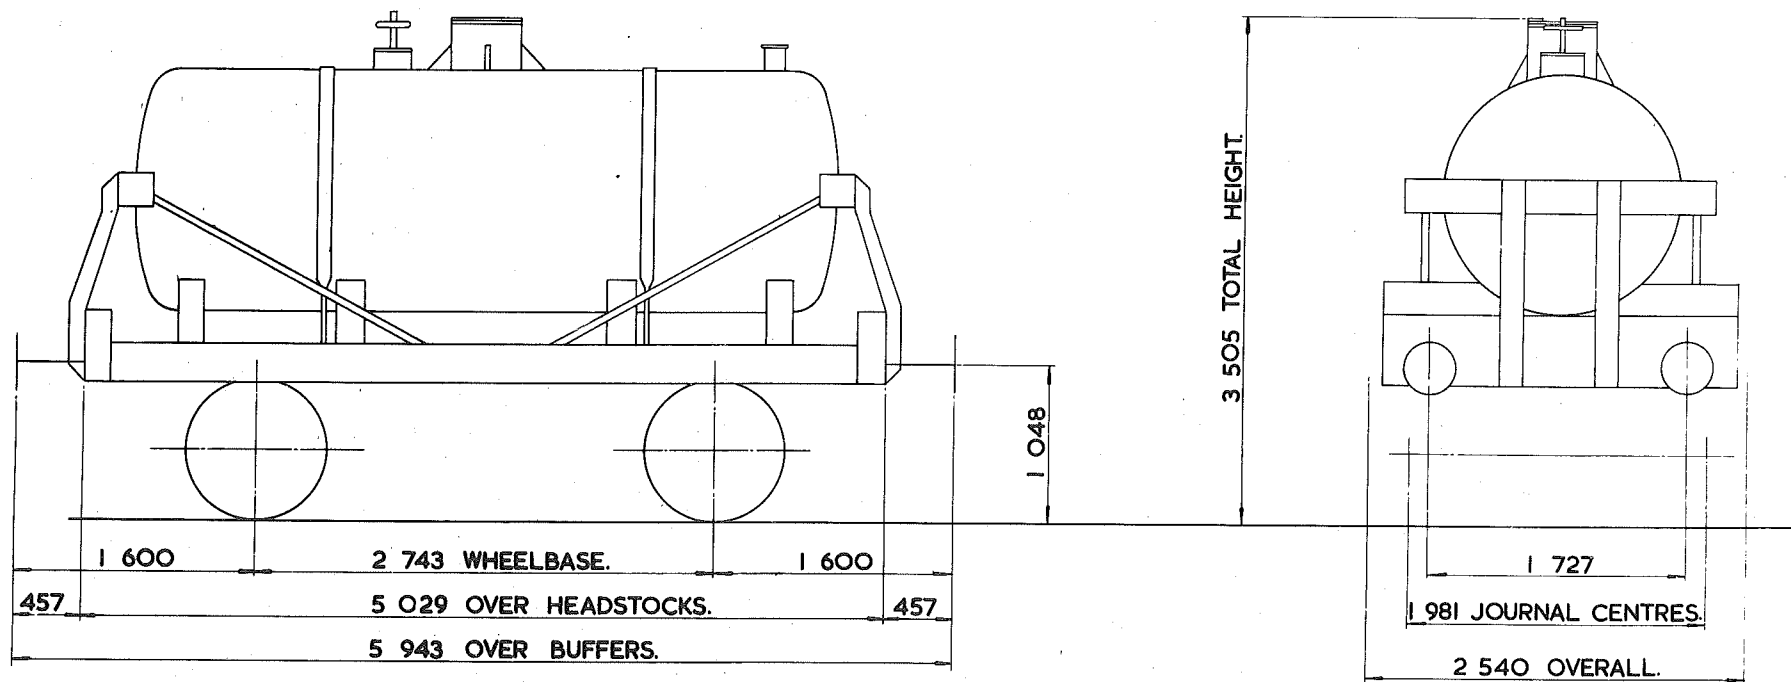

TARE -	8400 kg.
CARRYING CAPACITY -	14000 kg.
CAPACITY -	
MAX. SPEED -	45 mile/h.
WHEELS -	952 DIA.
JOURNALS -	228x114 PLAIN BEARINGS.

BUFFERS -	SPINDLE 330 DIA. HEADS.
COUPLINGS -	INSTANTER.
MIN. CURVE -	21m.
GEN. ARRGT. DRG. No. -	
BRAKE -	HANDLEVER.
SUSPENSION -	SHOE.


BUILDER -	CHARLES ROBERTS.
OWNER -	M.O. D.A.
REGISTERED BY -	C. M. & E. E. (BR.B.) DERBY.
YEAR BUILT -	1942.
REGISTRATION Nos. -	40272 40281
OWNERS Nos. -	13

TANK WAGON

TROO4A

EXCESS LENGTH	H	M	L	E
tonnes	22	22	8	8
VB				
AB				
RA	1	1	1	1
MAX. SPEED	45	45	45	45

TOPS CODE		
CARKND	AARKND	OPERATING PANEL No
T R Ø	T R Ø A	7 8 8

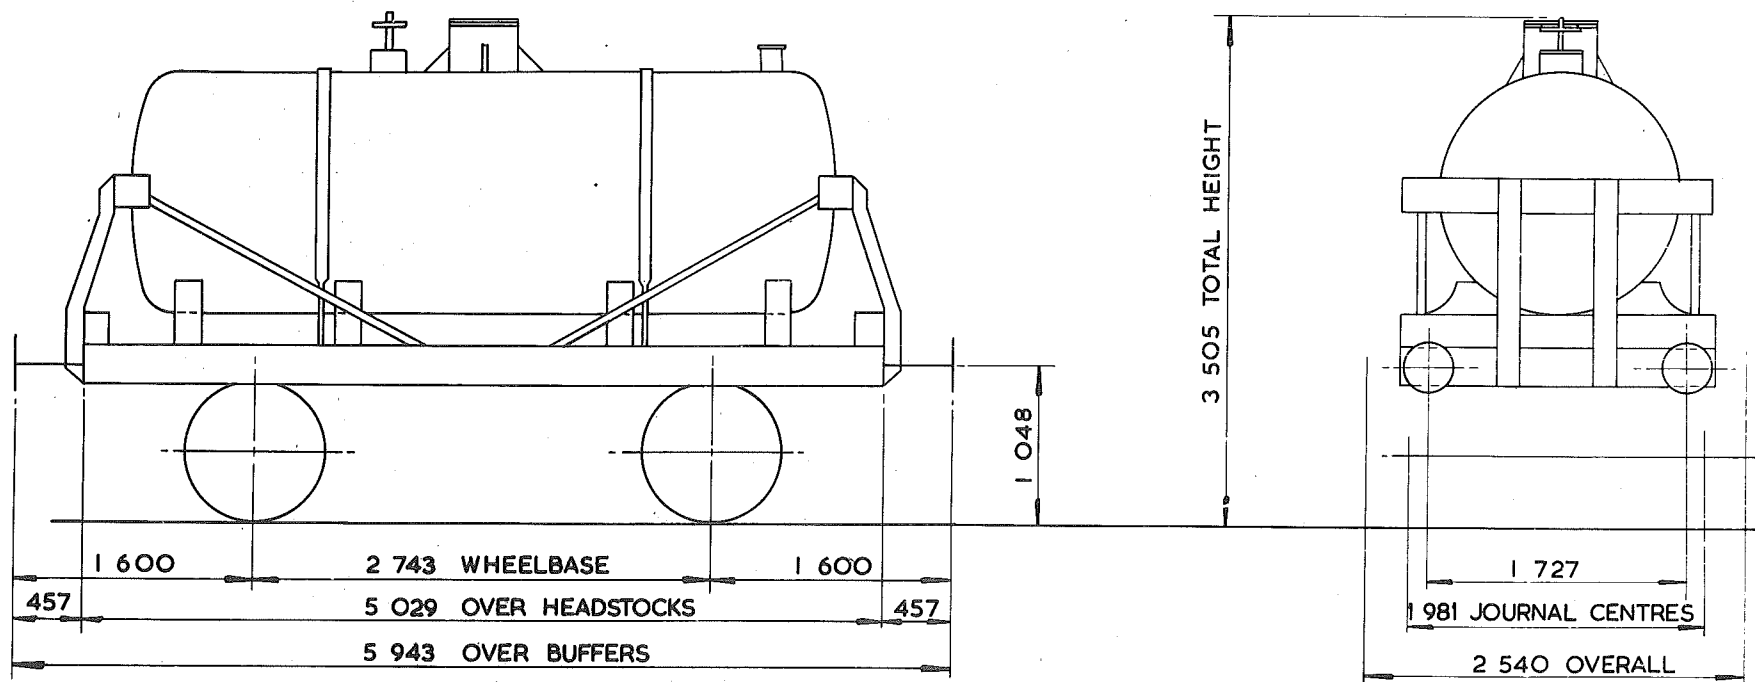

TARE -	8300kg
CARRYING CAPACITY -	14000kg
CAPACITY	
MAX. SPEED -	45 mile/h
WHEELS -	952 DIA
JOURNALS -	228 x 114 PLAIN BEARINGS

BUFFERS -	SPINDLE 330 DIA. HEADS
COUPLINGS -	INSTANTER
MIN. CURVE -	21m
GEN. ARRGT. DRG. No. -	
BRAKE -	HANDLEVER
SUSPENSION -	SHOE


BUILDER -	CAMBRIAN WAGON
OWNER -	M.O.D.A.
REGISTERED BY -	C.M.&E.E.(BRB.)DERBY
YEAR BUILT -	1941
REGISTRATION Nos. -	40290 40291
OWNERS Nos. -	4

TANK WAGON

TROO4B

EXCESS LENGTH	H	M	L	E
tonnes	22	22	8	8
VB				
AB				
RA	I	I	I	I
MAX. SPEED	45	45	45	45

TOPS CODE		
CARKND	AARKND	OPERATING PANEL No.
T R Ø	T R Ø A	7 8 8

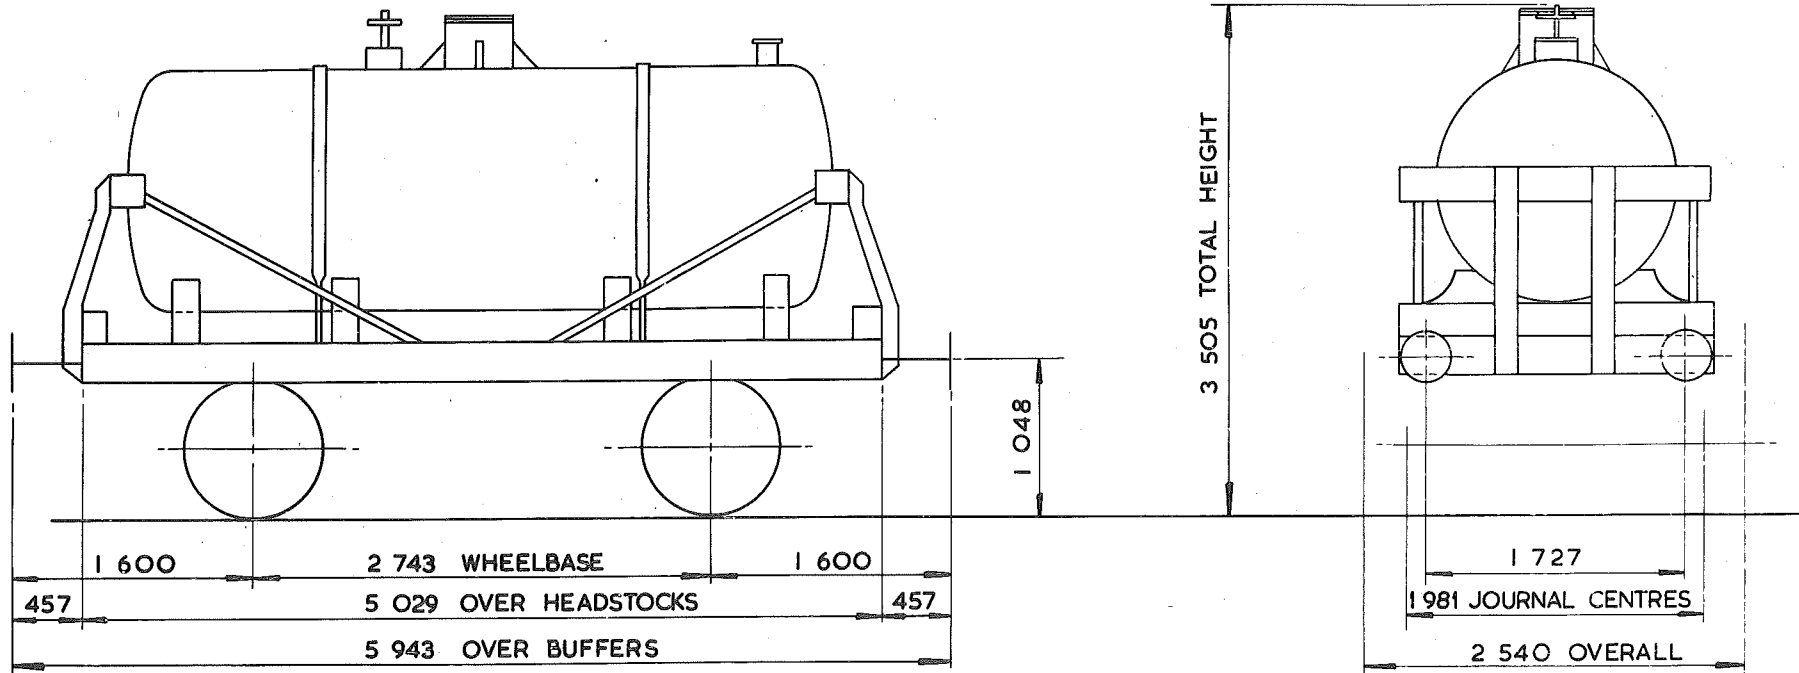

TARE—	8350kg
CARRYING CAPACITY—	14000kg
CAPACITY	
MAX. SPEED—	45mile/h
WHEELS—	952 DIA.
JOURNALS—	228 x 114 PLAIN BEARINGS

BUFFERS—	SPINDLE 330 DIA HEADS
COUPLINGS—	INSTANTER
MIN. CURVE—	21m
GEN. ARRGT. DRG. No.—	
BRAKE—	HAND LEVER.
SUSPENSION—	SHOE.


BUILDER—	G.R. TURNER
OWNER—	M.O.D.A.
REGISTERED BY—	C.M & E.E. (B.R.B.) DERBY
YEAR BUILT—	1944
REGISTRATION Nos.—	40274 40283
OWNERS Nos.—	15

TANK WAGON

TROO4C

EXCESS LENGTH	H	M	L	E
tonnes	22	22	8	8
VB				
AB				
RA	I	I	I	I
MAX SPEED	45	45	45	45

TOPS CODE		
CARKND	AARKND	OPERATING PANFL No
T R Ø	T R Ø A	7 8 8

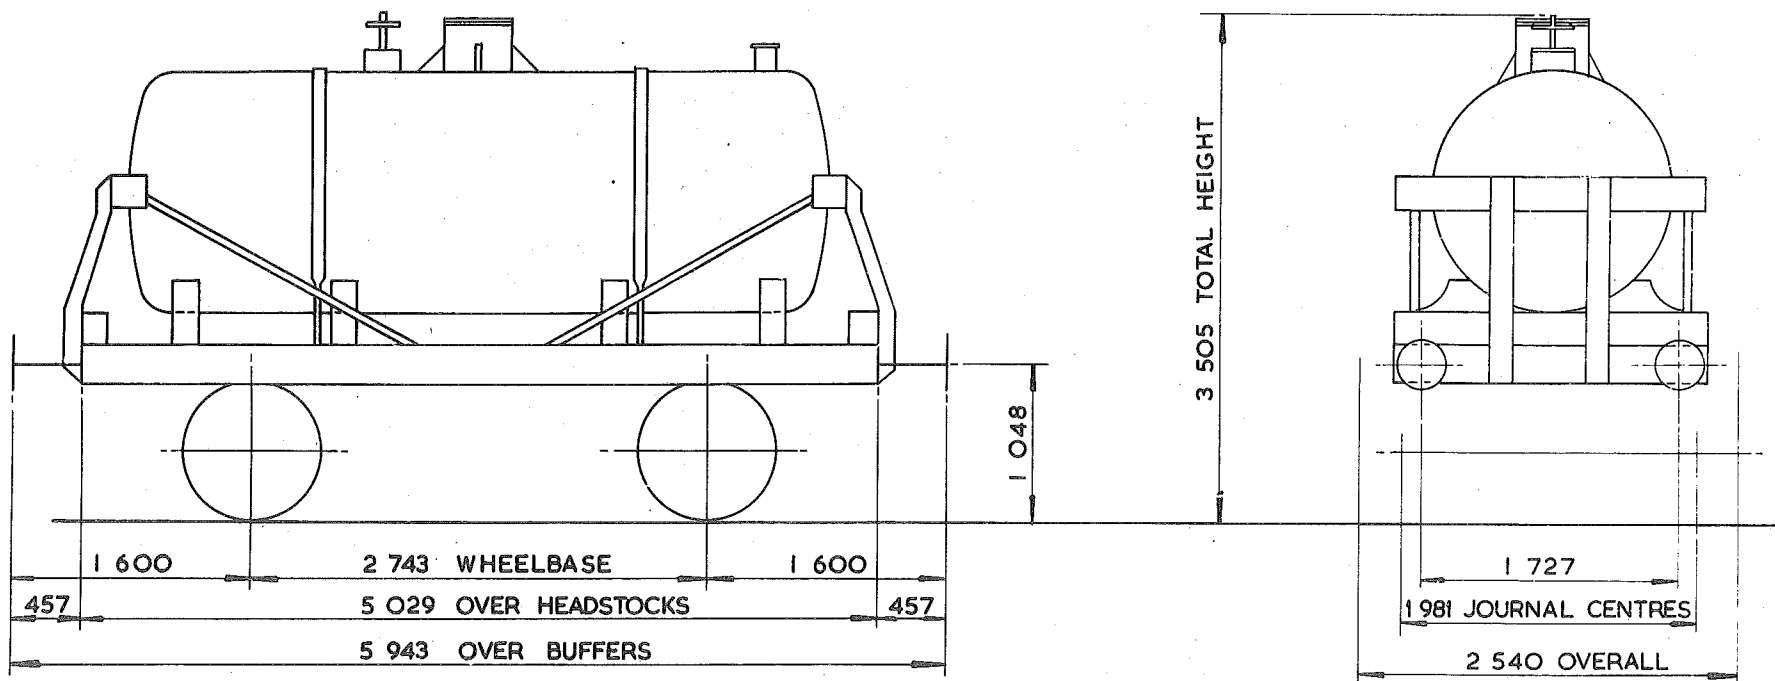

TARE -	8450 kg
CARRYING CAPACITY	14000 kg
CAPACITY	
MAX. SPEED -	45 mile/h
WHEELS -	952 DIA
JOURNALS -	228 x 114 PLAIN BEARINGS

BUFFERS -	SPINDLE 330 DIA HEADS
COUPLINGS -	INSTANTER
MIN. CURVE -	21m
GEN. ARRGT. DRG. No. -	
BRAKE -	HAND LEVER
SUSPENSION -	SHOE


BUILDER -	HURST NELSON
OWNER -	MODA.
REGISTERED BY -	C.M.&E.E. (B.R.B.) DERBY
YEAR BUILT -	1941
REGISTRATION Nos. -	40276 40285
OWNERS Nos. -	17

TANK WAGON

TROO4D

EXCESS LENGTH	H	M	L	E
tonnes	23	23	9	9
VB				
AB				
RA	1	1	1	1
MAX. SPEED	45	45	45	45

TOPS CODE		
CARKND	AARKND	OPERATING PANEL No.
T R Ø T R Ø A	7 8 1	

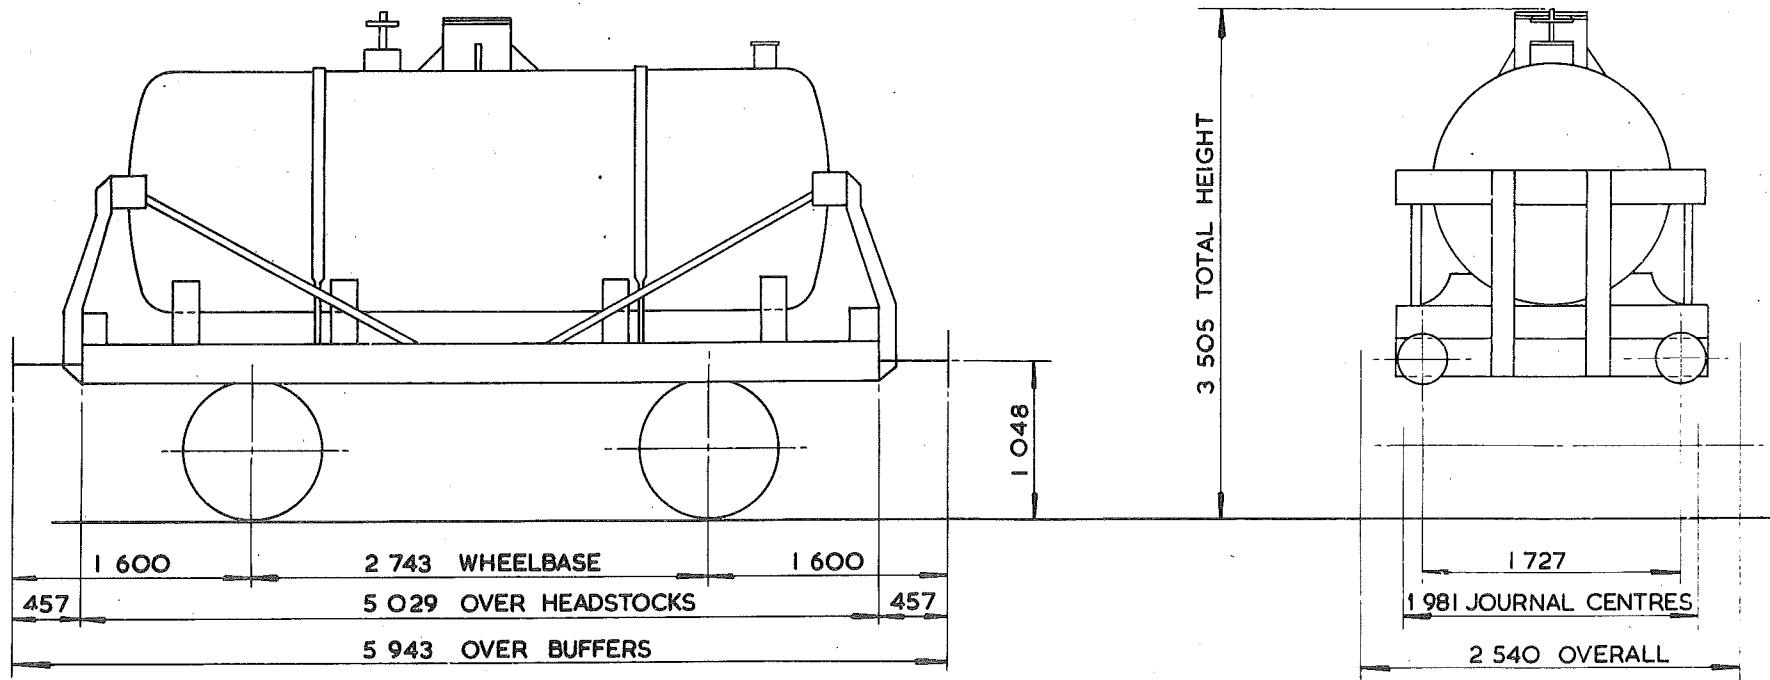

TARE -	9300 kg
CARRYING CAPACITY -	14000 kg.
CAPACITY	
MAX. SPEED -	45 mile/h
WHEELS -	952 DIA.
JOURNALS -	228 x 114 PLAIN BEARINGS

BUFFERS -	SPINDLE 330 DIA. HEADS
COUPLINGS -	INSTANTER
MIN. CURVE -	21 m
GEN. ARRGT. DRG. No. -	
BRAKE -	HAND LEVER
SUSPENSION -	SHOE


BUILDER -	G.R. TURNER
OWNER -	MINISTRY OF DEFENCE (ARMY POOL)
REGISTERED BY -	C.M. & E.E. (B.R.B.) DERBY
YEAR BUILT -	1970-1940
REGISTRATION Nos. -	40277, 40278, 40285-40287, 40294.
OWNERS Nos. -	18, 19, 20, 25, 27, 28, 35, 37, 412.

TANK WAGON

TROO4E

EXCESS LENGTH	H	M	L	E
tonnes	23	23	9	9
VB				
AB				
RA	1	1	1	1
MAX. SPEED	45	45	45	45

TOPS CODE		
CARKND	AARKND	OPERATING PANEL No
T R Ø	T R Ø A	7 8 1

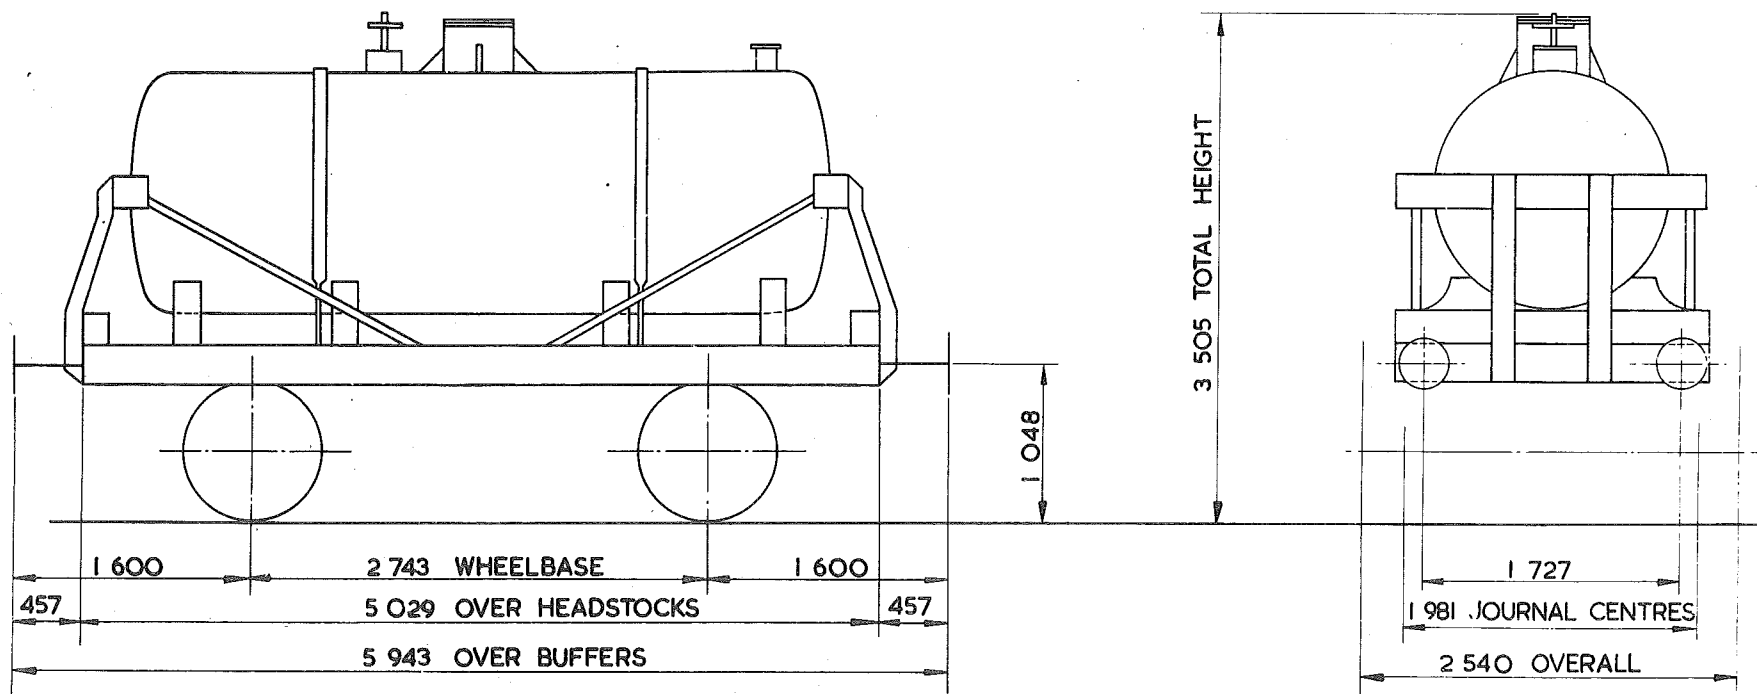

TARE -	9 300 kg
CARRYING CAPACITY -	14 000 kg
CAPACITY -	
MAX. SPEED -	45 mile/h
WHEELS -	952 DIA.
JOURNALS -	228 x 114 PLAIN BEARINGS

BUFFERS -	SPINDLE 330 DIA. HEADS
COUPLINGS -	INSTANTER
MIN. CURVE -	21m
GEN. ARRGT. DRG. No. -	
BRAKE -	HANDLEVER
SUSPENSION -	SHOE


BUILDER -	HURST NELSON
OWNER -	M.O.D.A.
REGISTERED BY -	C.M.&E.E. (B.R.B.) DERBY
YEAR BUILT -	1940
REGISTRATION Nos. -	4029
OWNERS Nos. -	94

TANK WAGON

TROO4F

EXCESS LENGTH	H	M	L	E
tonnes	22	22	8	8
VB				
AB				
RA	I	I	I	I
MAX SPEED	45	45	45	45

TOPS CODE		
CARKND	AARKND	OPERATING PANEL No
T R Ø	T R Ø A	7 8 8

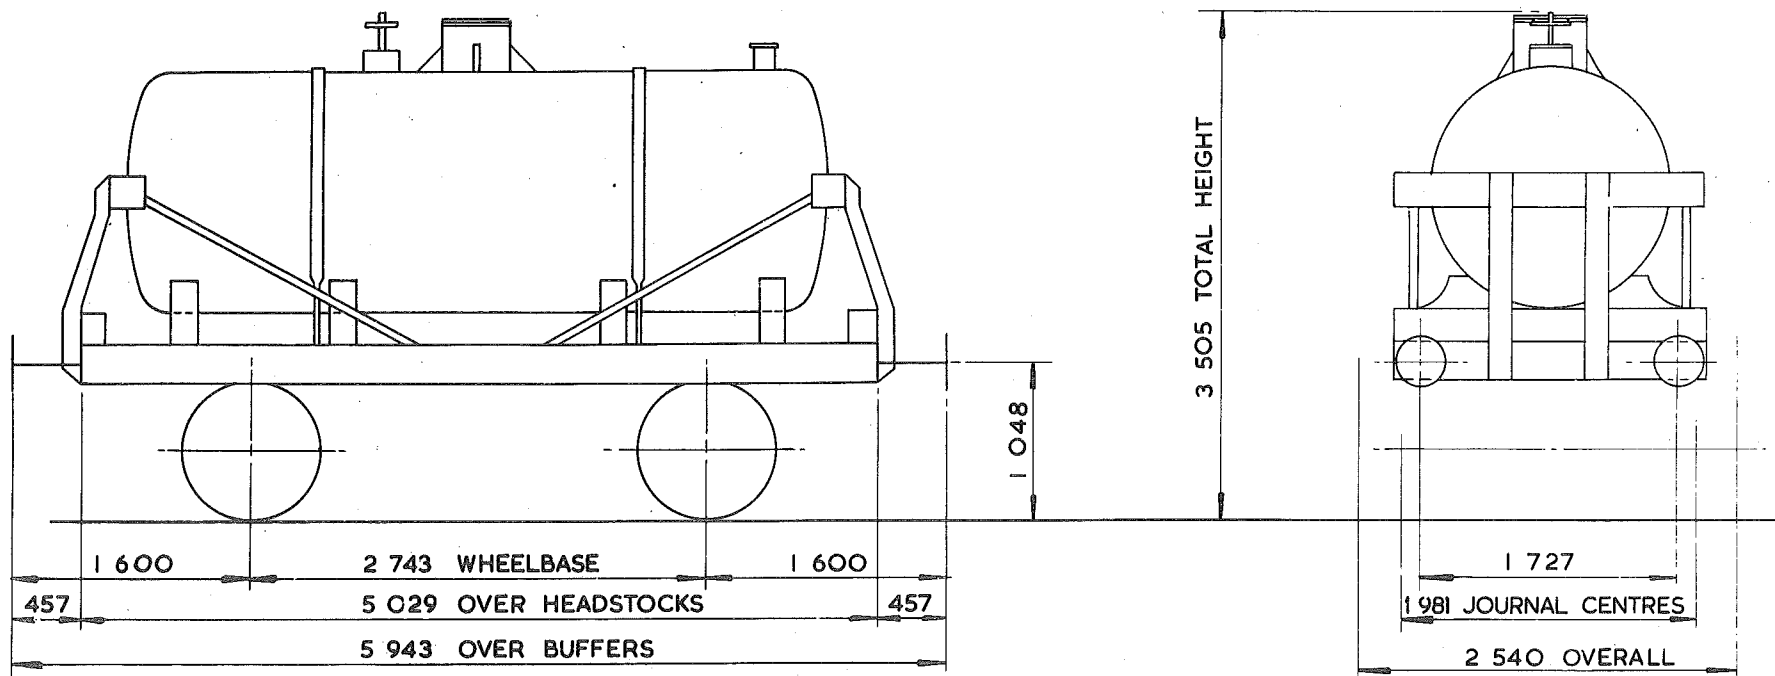

TARE -	8350kg
CARRYING CAPACITY -	14000kg
CAPACITY -	
MAX. SPEED -	45 mile/h
WHEELS -	952 DIA
JOURNALS -	228 x 114 PLAIN BEARINGS

BUFFERS -	SPINDLE 330 DIA. HEADS
COUPLINGS -	INSTANTER
MIN. CURVE -	21m
GEN. ARRG. DRG. No. -	
BRAKE -	HAND LEVER.
SUSPENSION -	SHOE


BUILDER -	CHARLES ROBERTS
OWNER -	M.O.D.A.
REGISTERED BY -	C.M.&E.E. (B.R.B.) DERBY
YEAR BUILT -	1940
REGISTRATION Nos. -	40296
OWNERS Nos. -	440

TANK WAGON

TROO5A

EXCESS LENGTH	H	M	L	E
tonnes	22	22	8	8
VB				
AB				
RA	I	I	I	I
MAX. SPEED	45	45	45	45

TOPS CODE									
CARKND		AARKND		OPERATING PANEL No					
T	R	Ø	T	R	Ø	A	7	8	8

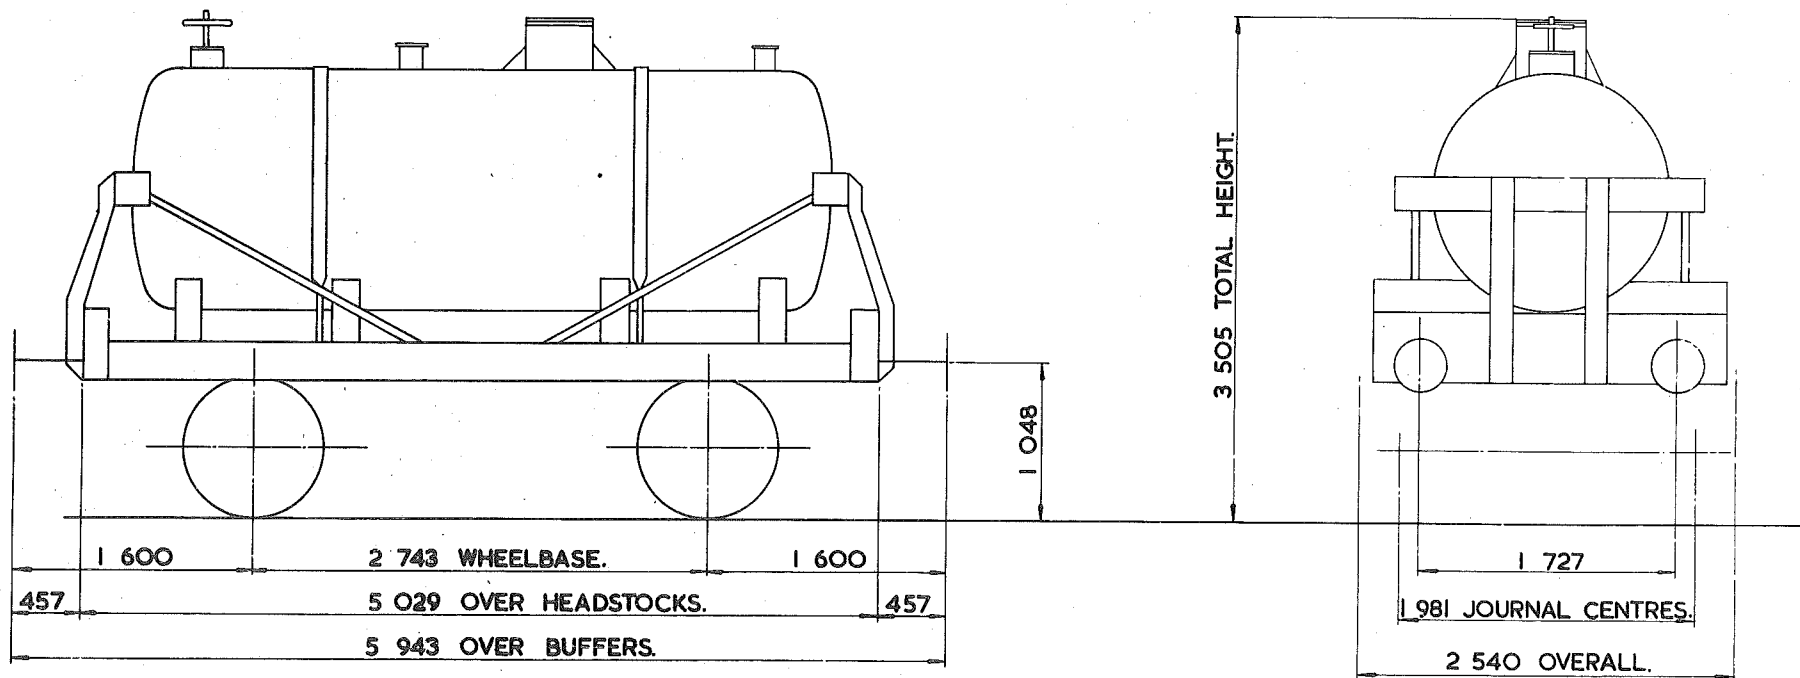

TARE -	8 300kg.
CARRYING CAPACITY -	14 000kg.
CAPACITY -	
MAX. SPEED -	45 mile/h.
WHEELS -	952 DIA.
JOURNALS -	228x114 PLAIN BEARINGS.

BUFFERS -	SPINDLE 330 DIA. HEADS.
COUPLINGS -	INSTANTER.
MIN. CURVE -	21m.
GEN. ARRGT. DRG. No. -	
BRAKE -	HAND LEVER.
SUSPENSION -	SHOE.


BUILDER -	CHARLES ROBERTS.
OWNER -	M. O. D. A.
REGISTERED BY -	C. M. & E. E. (B. R. B.) DERBY.
YEAR BUILT -	1942.
REGISTRATION Nos. -	40288.
OWNERS Nos. -	2A.

TANK WAGON

TRO05B

EXCESS LENGTH	H	M	L	E
tonnes	22	22	8	8
VB				
AB				
RA	I	I	I	I
MAX. SPEED	45	45	45	45

TOPS CODE		
CARKND	AARKND	OPERATING PANEL No.
T R Ø	T R Ø A	7 8 8

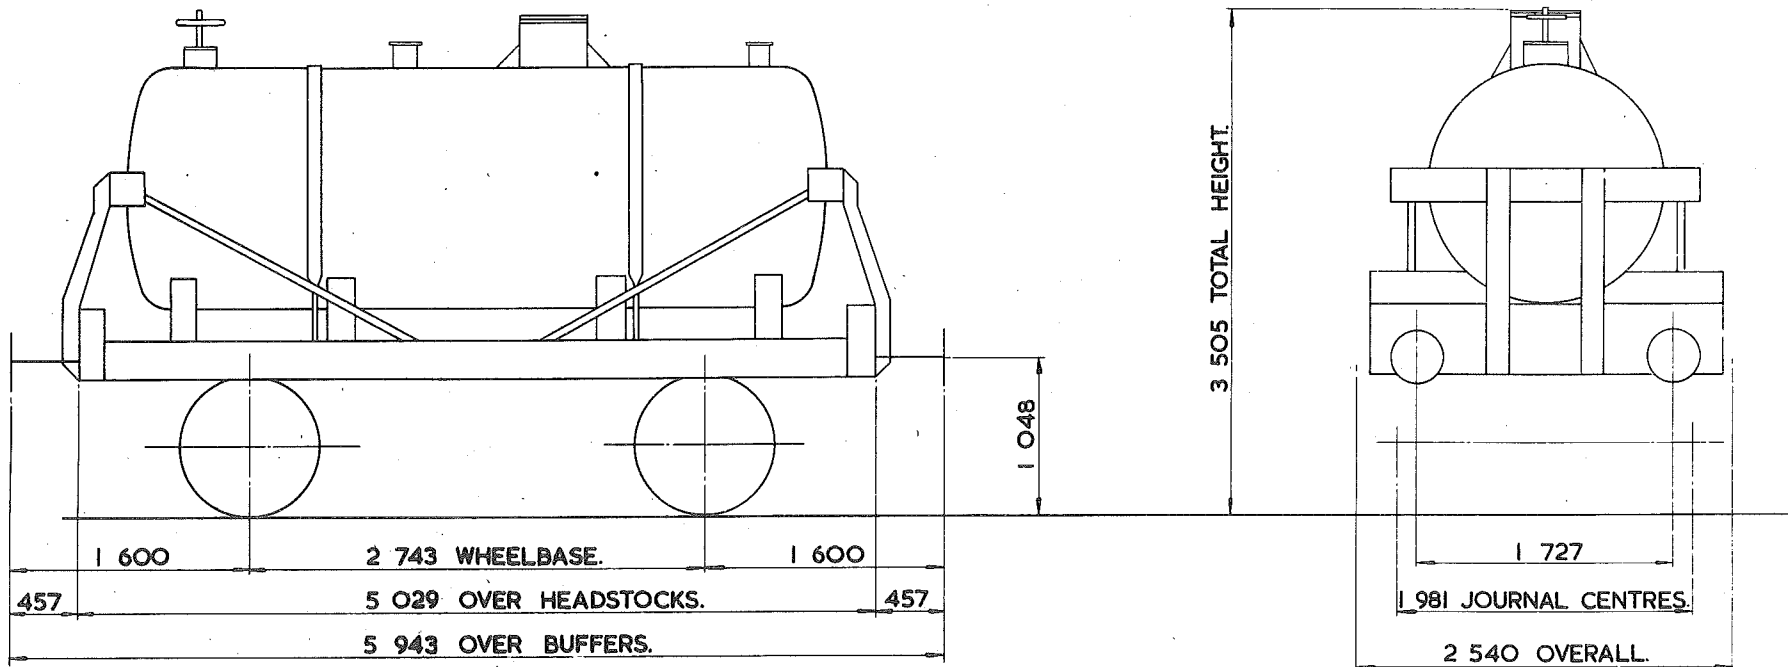

TARE -	8700 kg.
CARRYING CAPACITY -	14000 kg.
CAPACITY -	
MAX. SPEED -	45 mile/h.
WHEELS -	952 DIA.
JOURNALS -	228x114 PLAIN BEARINGS.

BUFFERS -	SPINDLE 330 DIA. HEADS.
COUPLINGS -	INSTANTER.
MIN. CURVE -	21m.
GEN. ARRGT. DRG. No. -	
BRAKE -	HAND LEVER.
SUSPENSION -	SHOE.


BUILDER -	CHARLES ROBERTS.
OWNER -	M.O.D.A.
REGISTERED BY -	C.M.&E.E. (B.R.B.) DERBY.
YEAR BUILT -	1942.
REGISTRATION Nos. -	40268, 40286, 40287.
OWNERS Nos. -	2, 21, 24

TANK WAGON.

TROO5C

EXCESS LENGTH	H	M	L	E
tonnes	22	22	8	8
VB				
AB				
RA	1	1	1	1
MAX. SPEED	45	45	45	45

TOPS CODE		
CARKND	AARKND	OPERATING PANEL No.
T R Ø	T R Ø A	7 8 8

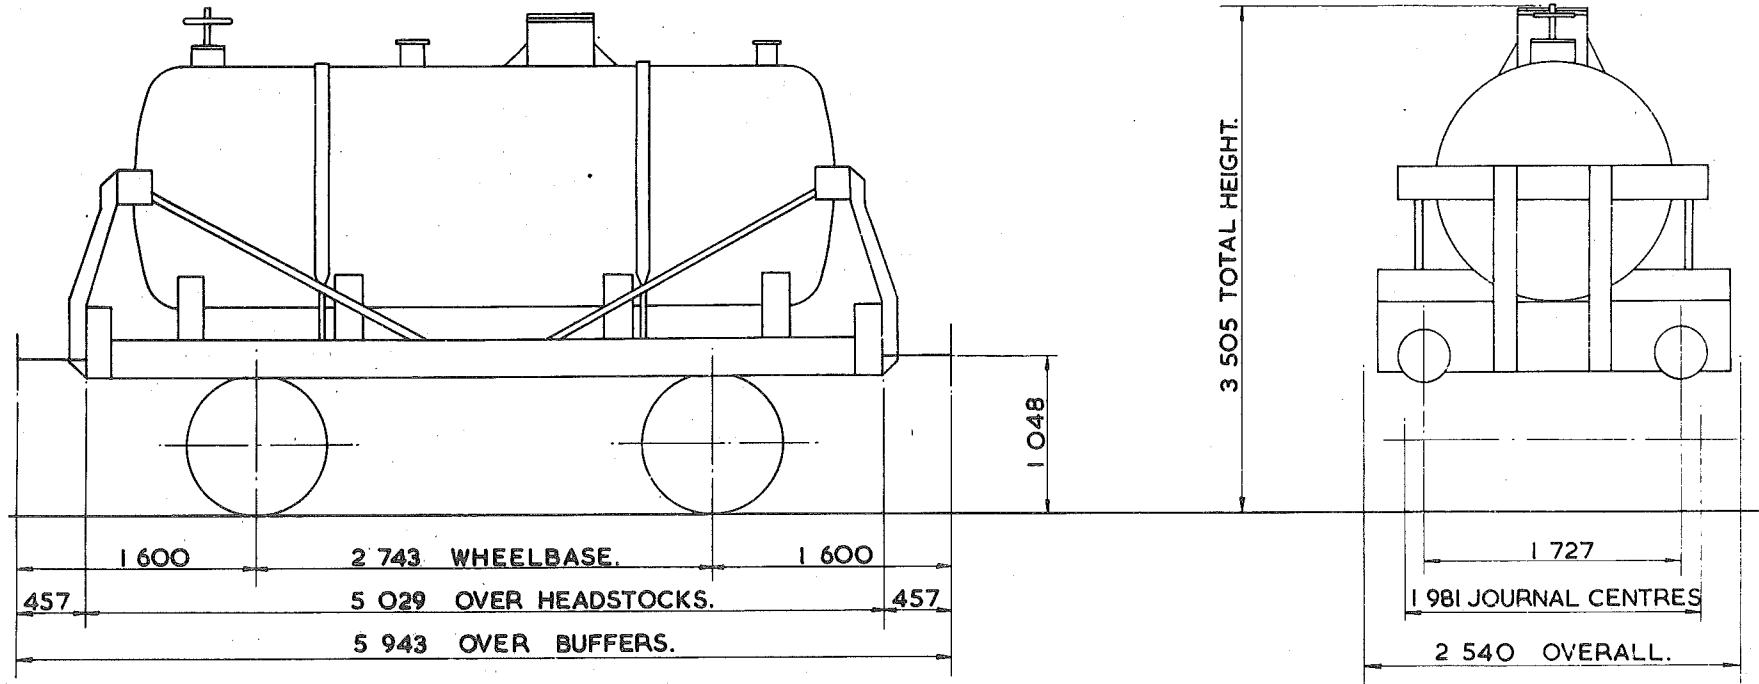

TARE -	8300kg.
CARRYING CAPACITY -	14000kg.
CAPACITY -	
MAX. SPEED -	45 mile/h.
WHEELS -	952 DIA.
JOURNALS -	228x114 PLAIN BEARINGS.

BUFFERS -	SPINDLE 330 DIA. HEADS.
COUPLINGS -	INSTANTER.
MIN. CURVE -	21m.
GEN. ARRGT. DRG. No. -	
BRAKE -	HAND LEVER.
SUSPENSION -	SHOE.


BUILDER -	HURST NELSON
OWNER -	M.O.D.A.
REGISTERED BY -	C.M.&E.E. (B.R.B.) DERBY.
YEAR BUILT -	1940.
REGISTRATION Nos. -	4029 ¹⁶
OWNERS Nos. -	437

TANK WAGON

TROO6A

EXCESS LENGTH	H	M	L	E
tonnes	22	22	8	8
VB				
AB				
RA	1	1	1	1
MAX. SPEED	45	45	45	45

TOPS CODE		
CARKND	AARKND	OPERATING PANFI No.
T R Ø	T R Ø A	7 8 8

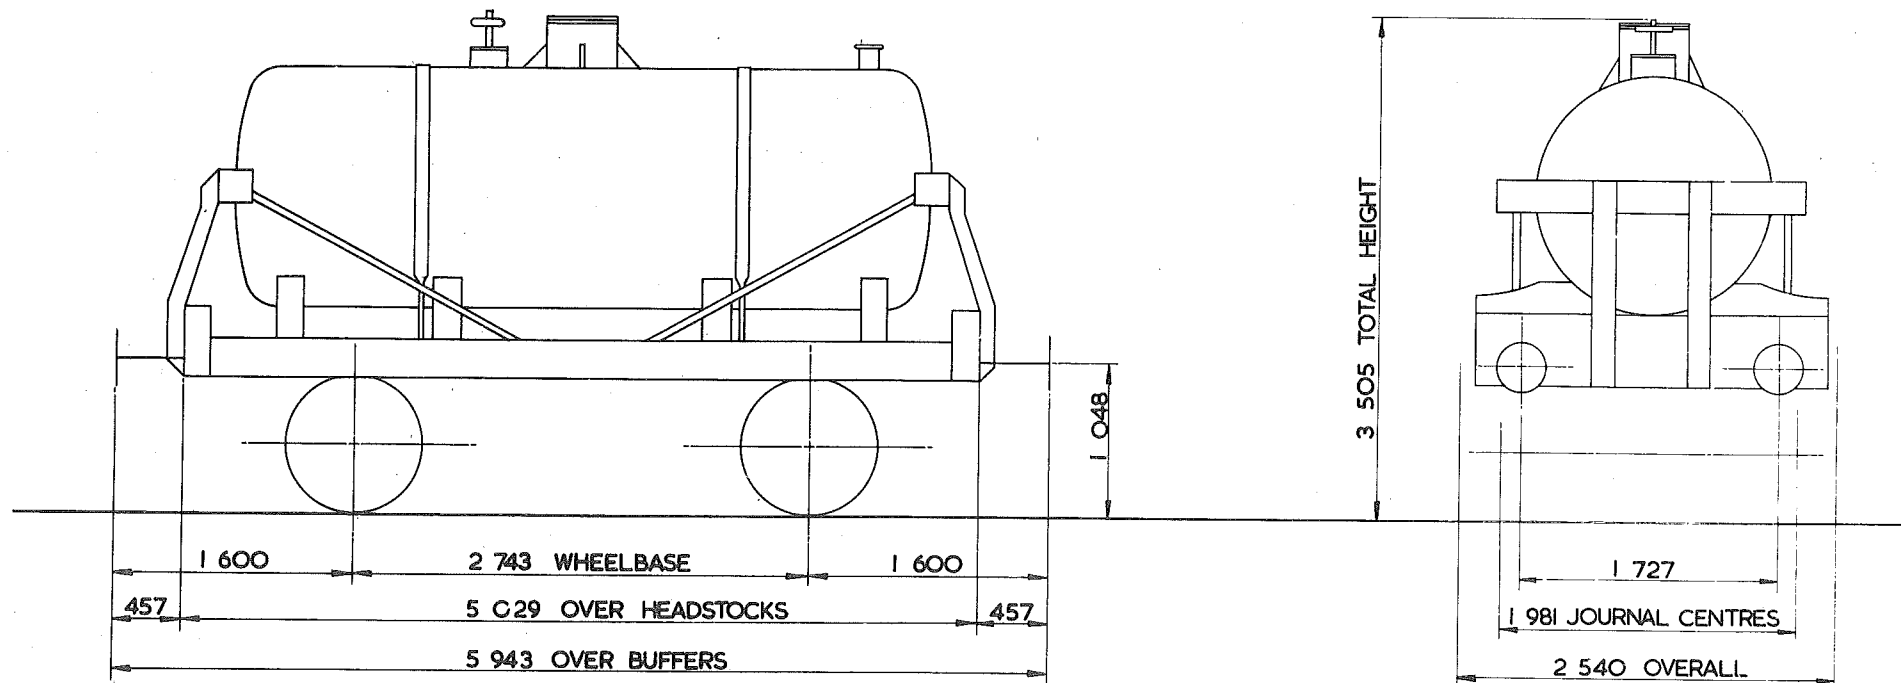

TARE -	8400 kg
CARRYING CAPACITY -	14000 kg
CAPACITY -	
MAX. SPEED -	45 mile/h
WHEELS -	952 DIA
JOURNALS -	228 x 114 PLAIN BEARINGS.

BUFFERS -	SPINDLE 330 DIA HEADS
COUPLINGS -	INSTANTER
MIN. CURVE -	21 m
GEN. ARRGT. DRG. No. -	
BRAKE -	HAND LEVER
SUSPENSION -	SHOE


BUILDER -	CHARLES ROBERTS
OWNER -	MINISTRY OF DEFENCE (ARMY POOL)
REGISTERED BY -	C.M. & E.E. (B.R.B) DERBY
YEAR BUILT -	1940
REGISTRATION Nos. -	40289
OWNERS Nos. -	3

TANK WAGON

TRO06B

EXCESS LENGTH	H	M	L	E
tonnes	22	22	8	8
VB				
AB				
RA	I	I	I	I
MAX SPEED	45	45	45	45

TOPS CODE		
CARKND	AARKND	OPERATING PANFL No
T R Ø	T R Ø A	7 8 8

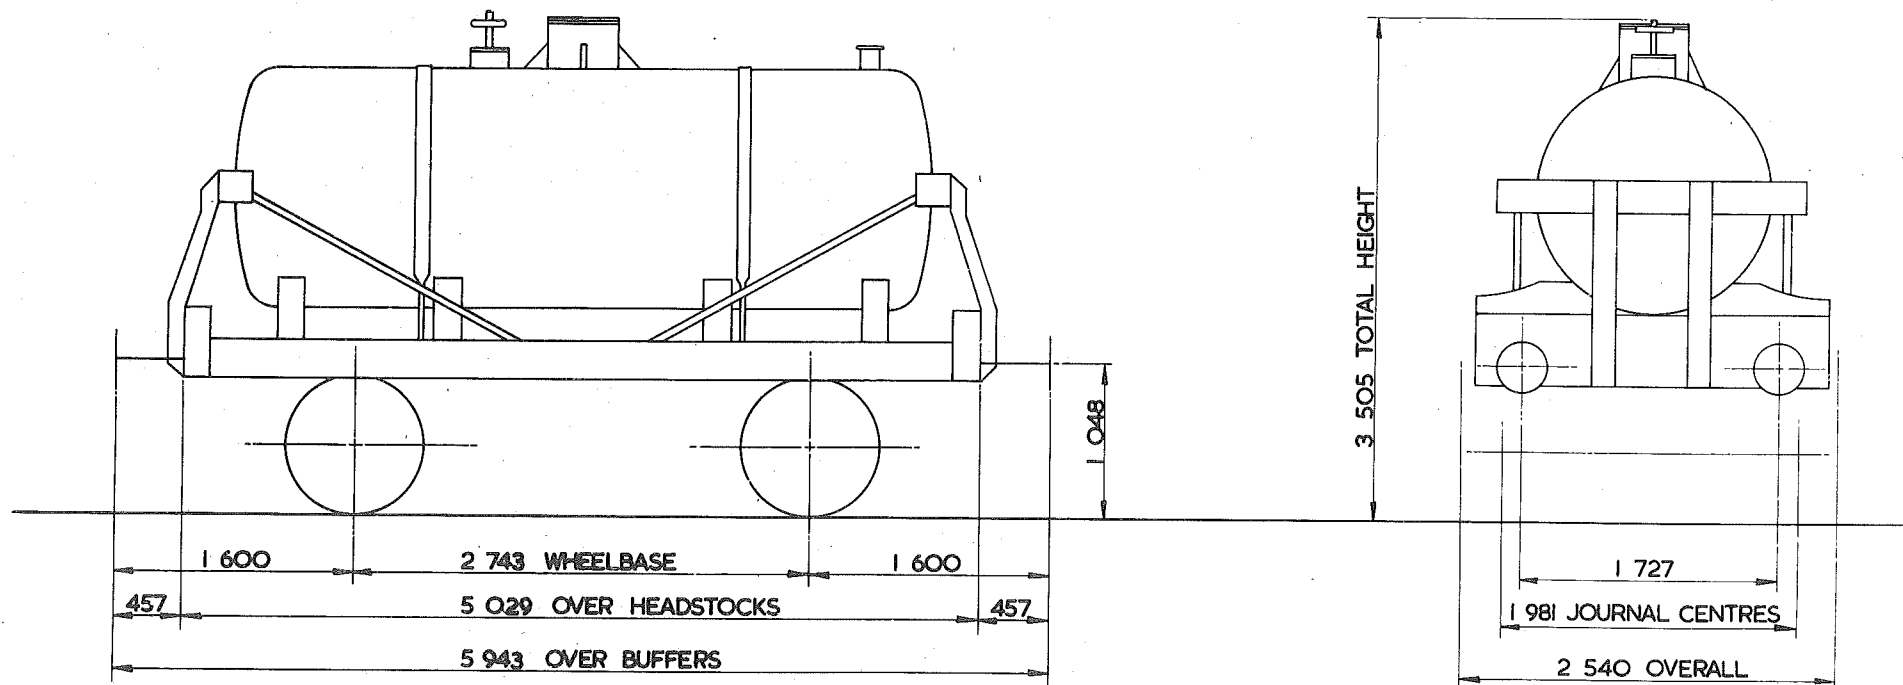

TARE -	8650 kg
CARRYING CAPACITY -	14000 kg
CAPACITY -	
MAX. SPEED -	45 mile/h
WHEELS -	952 DIA
JOURNALS -	228x114 PLAIN BEARINGS

BUFFERS -	SPINDLE 330 DIA HEADS
COUPLINGS -	INSTANTER
MIN. CURVE -	21 m
GEN. ARRGT. DRG. No. -	
BRAKE -	HAND LEVER
SUSPENSION -	SHOE


BUILDER -	CHARLES ROBERTS
OWNER -	MINISTRY OF DEFENCE (ARMY POOL)
REGISTERED BY -	C.M. & E.E. (B.R.B.) DERBY
YEAR BUILT -	1940
REGISTRATION Nos. -	40291 40289
OWNERS Nos. -	91

TANK WAGON

TROO6C

EXCESS LENGTH	H	M	L	E
tonnes	22	22	8	8
VB				
AB				
RA	1	1	1	1
MAX. SPEED	45	45	45	45

TOPS CODE		
CARKND	AARKND	OPERATING PANEL No
T R Ø	T R Ø A	7 8 8

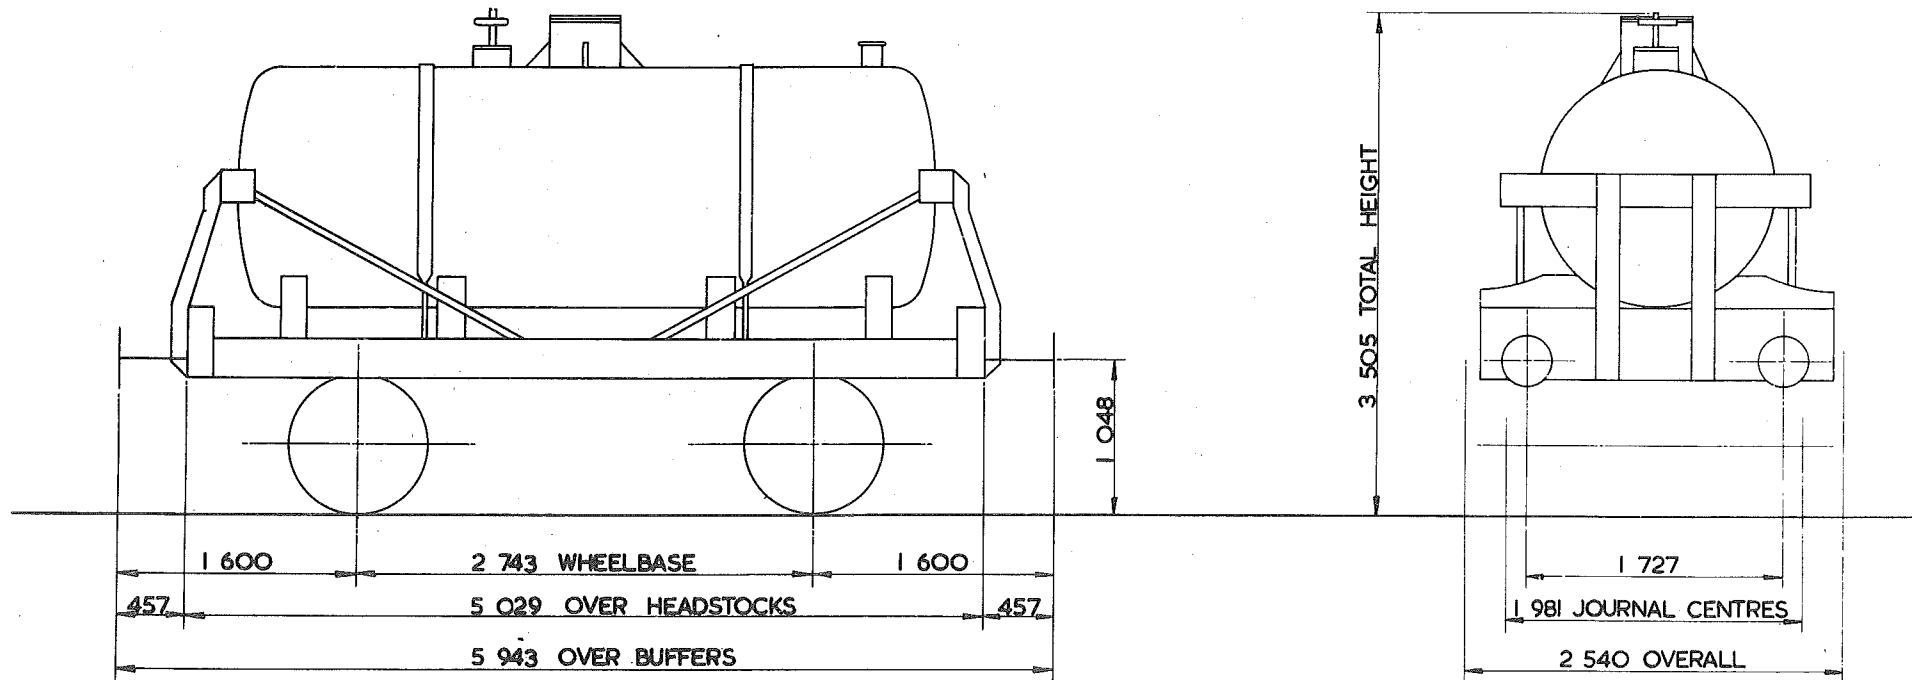

TARE -	8300 kg
CARRYING CAPACITY -	14000 kg
CAPACITY -	
MAX. SPEED -	45 mile/h
WHEELS -	952 DIA
JOURNALS -	228x114 PLAIN BEARINGS

BUFFERS -	SPINDLE 330 DIA HEADS
COUPLINGS -	INSTANTER
MIN. CURVE -	21m
GEN. ARRGT. DRG. No. -	
BRAKE -	HAND LEVER
SUSPENSION -	SHOE


BUILDER -	CAMBRIAN WAGON
OWNER -	MINISTRY OF DEFENCE (ARMY POOL)
REGISTERED BY -	C.M. & E.E. (B.R.B.) DERBY.
YEAR BUILT -	1941
REGISTRATION Nos. -	40292
OWNERS Nos. -	93

TANK WAGON

TROO7A

EXCESS LENGTH	H	M	L	E
tonnes	23	23	9	9
VB				
AB				
RA	I	I	I	I
MAX. SPEED	45	45	45	45

TOPS CODE		
CARKND	AARKND	OPERATING PANEL No.
T R Ø	T R Ø A	7 8 I

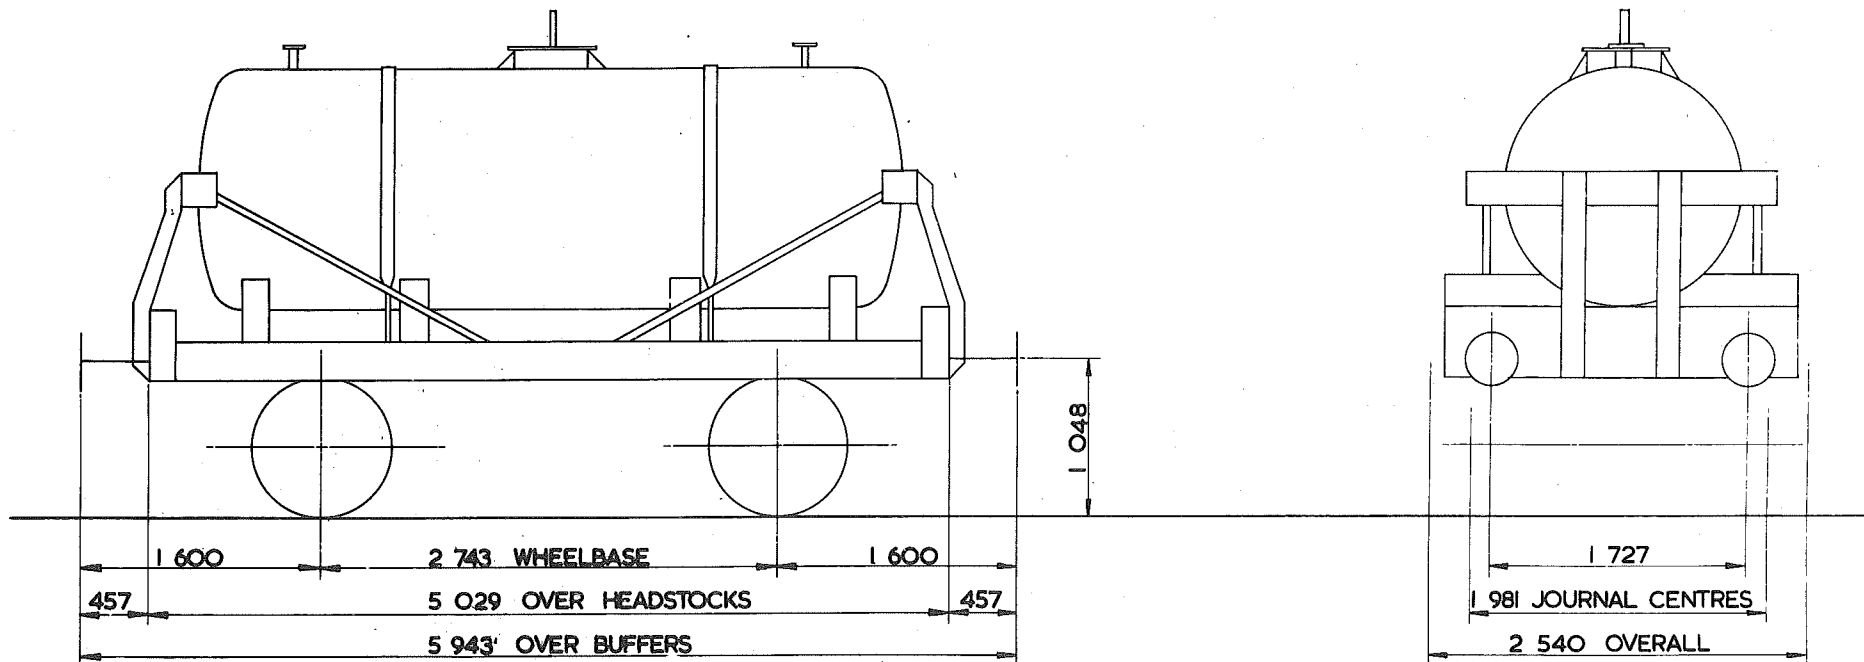

TARE -	9150 kg
CARRYING CAPACITY -	14000 kg
CAPACITY -	
MAX. SPEED -	45 mile/h
WHEELS -	952 DIA
JOURNALS -	228 x 114 PLAIN BEARINGS

BUFFERS -	SPINDLE 330 DIA HEADS
COUPLINGS -	INSTANTER
MIN. CURVE -	21 m
GEN. ARRGT. DRG. No. -	
BRAKE -	HAND LEVER
SUSPENSION -	SHOE


BUILDER -	CHARLES ROBERTS
OWNER -	M.O.D.A.
REGISTERED BY -	C.M. & E.E. (B.R.B.) DERBY
YEAR BUILT -	1942
REGISTRATION Nos. -	40267 40271
OWNERS Nos. -	1

TANK WAGON

TRO07B

EXCESS LENGTH	H	M	L	E
tonnes	23	23	9	9
VB				
AB				
RA	1	1	1	1
MAX. SPEED	45	45	45	45

TOPS CODE			
CARKND	AARKND	OPERATING PATTERN	
T R Ø	T R Ø A	7	8 1

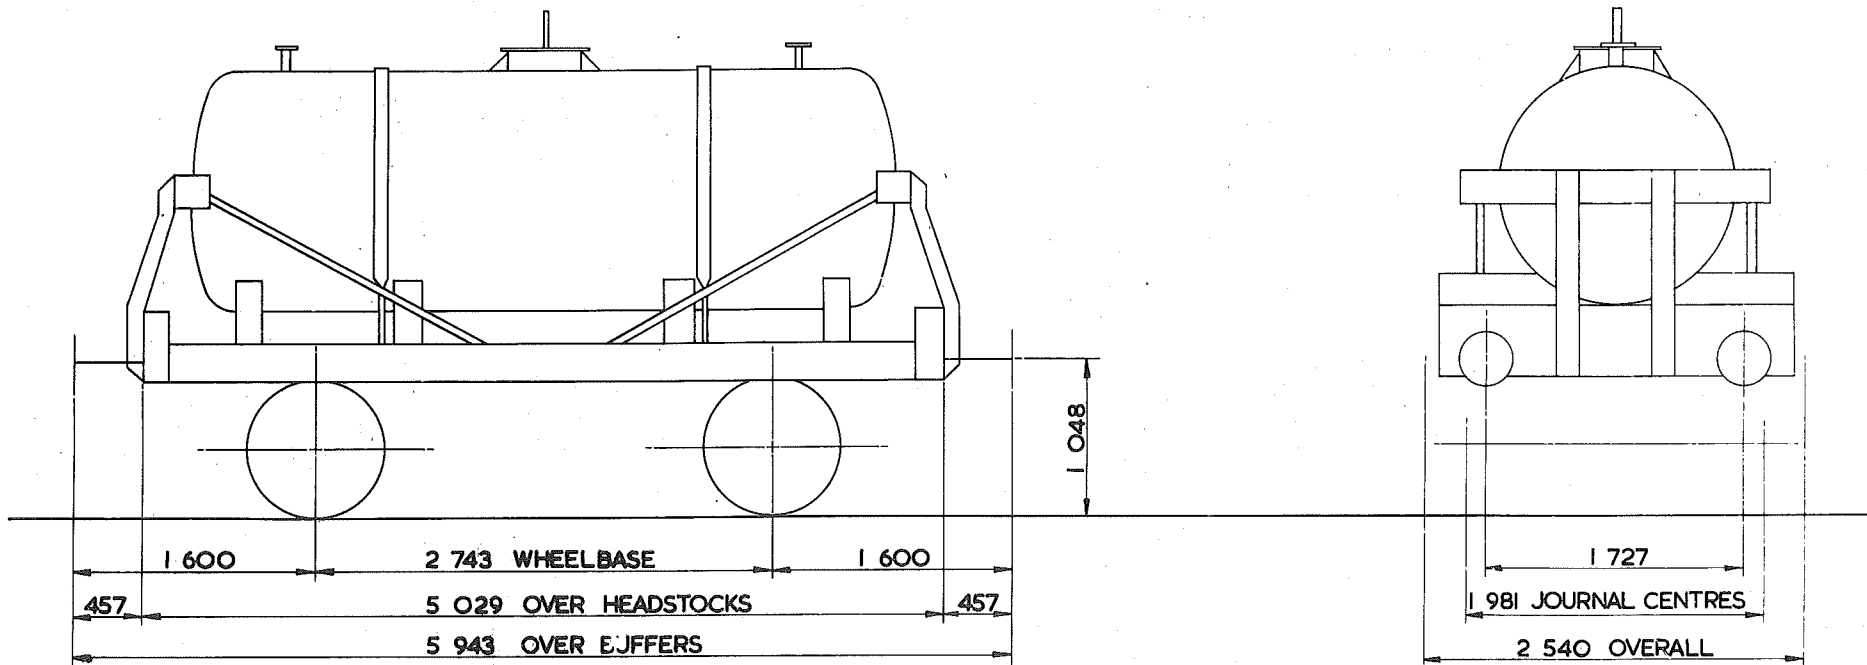

TARE -	9350 kg
CARRYING CAPACITY -	14000 kg
CAPACITY -	
MAX. SPEED -	45 m/c/h
WHEELS -	952 DIA
JOURNALS -	228 x 114 PLAIN BEARINGS

BUFFERS -	SPINDLE 330 DIA HEADS
COUPLINGS -	INSTANTER
MIN. CURVE -	21m
GEN. ARRG. DRG. No. -	
BRAKE -	HAND LEVER
SUSPENSION -	SHOE


BUILDER -	HURST NELSON
OWNER -	MINISTRY OF DEFENCE (ARMY POOL)
REGISTERED BY -	C.M. & E.E. (B.R.B.) DERBY.
YEAR BUILT -	1940
REGISTRATION Nos. -	40269
OWNERS Nos. -	4A

TANK WAGON

TROO7C

EXCESS LENGTH	H	M	L	E
tonnes	22	22	8	8
VB				
AB				
RA	I	I	I	I
MAX. SPEED	45	45	45	45

TOPS CODE		
CARKND	AARKND	OPERATING PANEL No.
T R Ø	T R Ø A	7 8 8

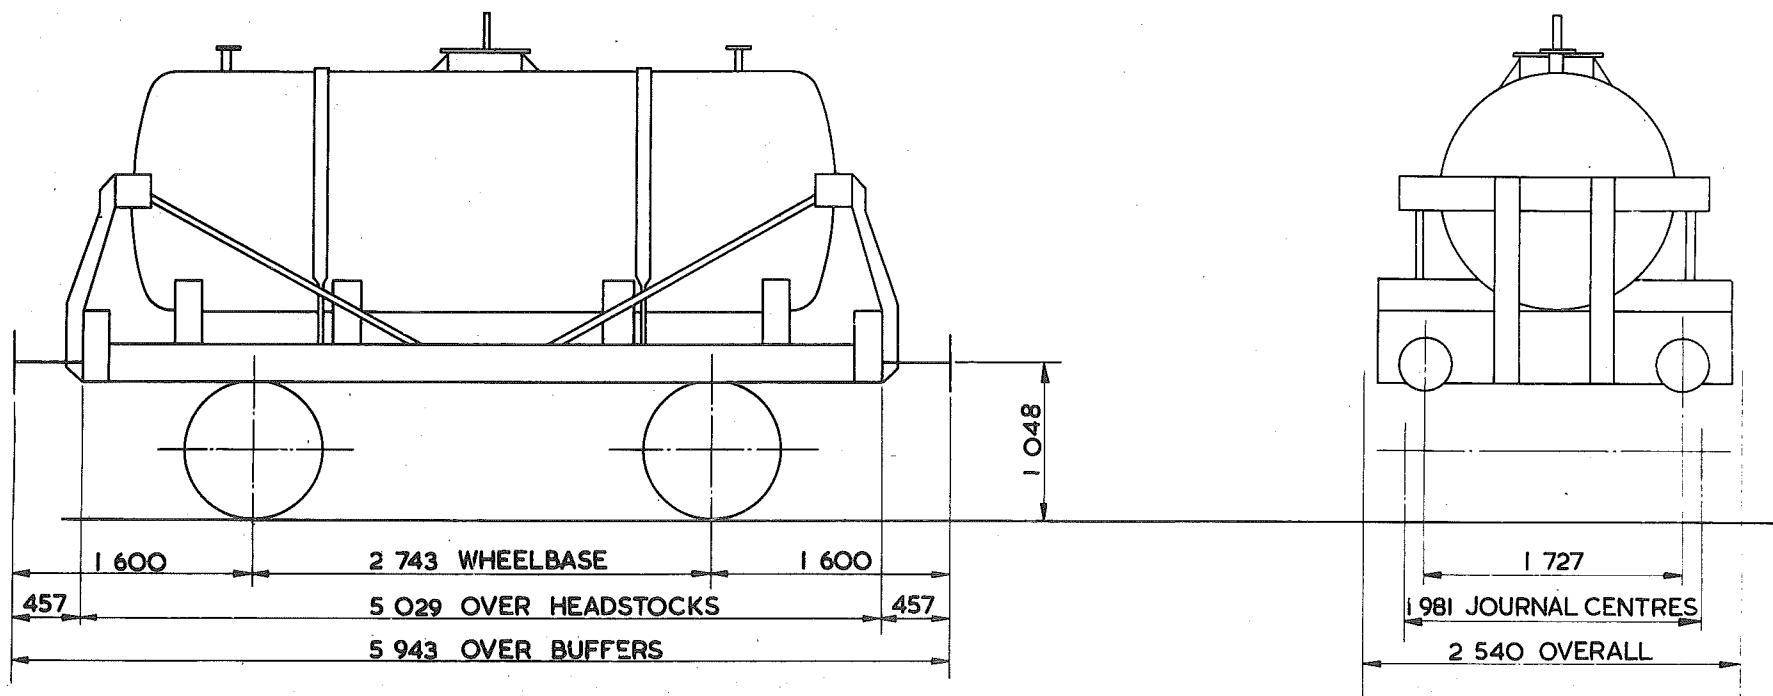

TARE -	8 650 kg
CARRYING CAPACITY -	14 000 kg
CAPACITY -	
MAX. SPEED -	45 mile/h
WHEELS -	952 DIA.
JOURNALS -	228 x 114 PLAIN BEARINGS

BUFFERS -	SPINDLE 330 DIA. HEADS
COUPLINGS -	INSTANTER
MIN. CURVE -	21m
GEN. ARRGT. DRG. No. -	
BRAKE -	HAND LEVER
SUSPENSION -	SHOE


BUILDER -	HURST NELSON
OWNER -	M.O.D.A.
REGISTERED BY -	C.M.&E.E. (B.R.B.) DERBY
YEAR BUILT -	1942
REGISTRATION Nos. -	40278
OWNERS Nos. -	16

TANK WAGON

TRO08A

EXCESS LENGTH	H	M	L	E
tonnes	23	20	9	9
VB				
AB				
RA	1	1	1	1
MAX. SPEED	45	45	45	45

TOPS CODE		
CARKND	AARKND	OPERATING PANEL No.
T R Ø	T R Ø A	7 9 0

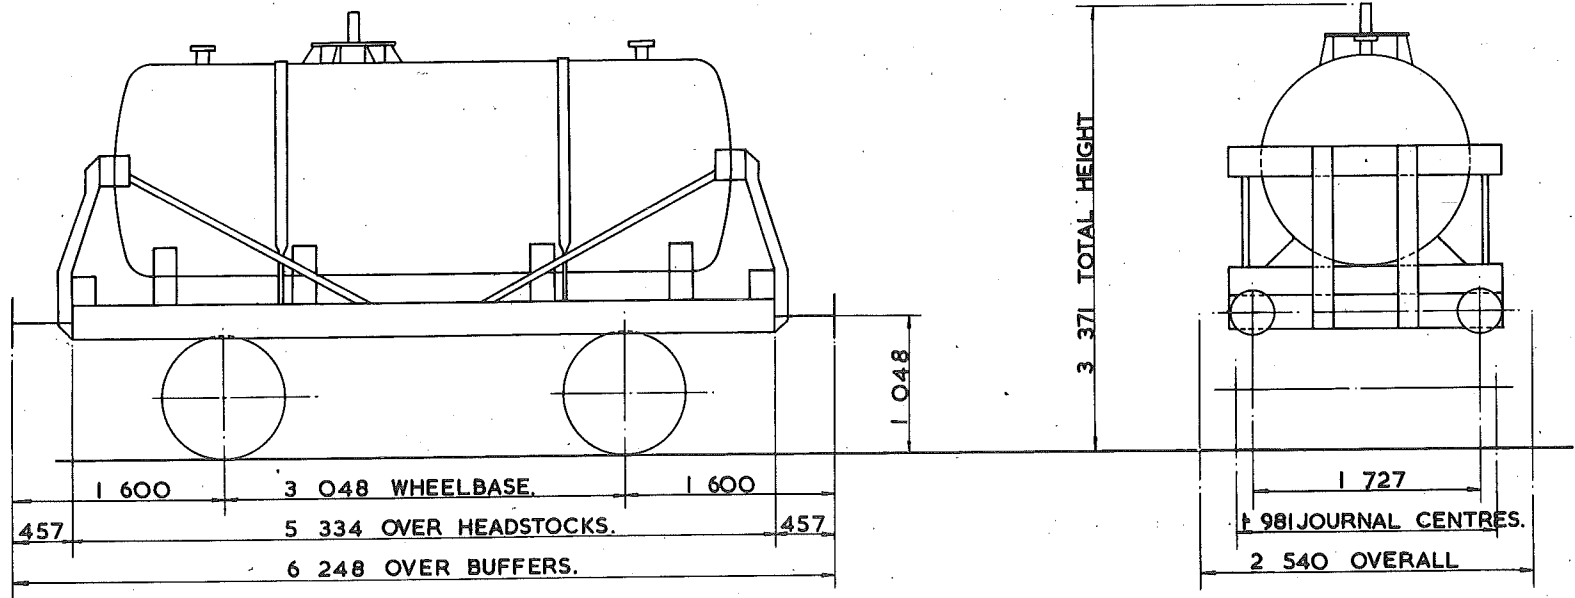

TARE - 8600kg.
CARRYING CAPACITY - 14000kg.
CAPACITY -
MAX. SPEED - 45 mile/h.
WHEELS - 952 DIA
JOURNALS - 228 x 114 PLAIN BEARINGS.

BUFFERS - SPINDLE 330 DIA. HEADS.
COUPLINGS - INSTANTER.
MIN. CURVE - 21m.
GEN. ARRGT. DRG. No. -
BRAKE - HAND LEVER.
SUSPENSION - SHOE.


BUILDER - CHARLES ROBERTS.
OWNER - BRITISH NUCLEAR FUELS LTD. (SPRINGFIELD)
REGISTERED BY - C.M.&E.E. (B.R.B.) DERBY.
YEAR BUILT - 1941
REGISTRATION Nos. - 40611 - 40630
OWNERS Nos. - 4306 A' 0011 - 4306 A' 0030.

TANK WAGON

TRO08B

EXCESS LENGTH	H	M	L	E
tonnes	23	20	9	9
VB				
AB				
RA	1	1	1	1
MAX. SPEED	45	45	45	45

TOPS CODE		
CARKND	AARKND	OPERATING PANEL No.
T R Ø	T R Ø A	7 9 0

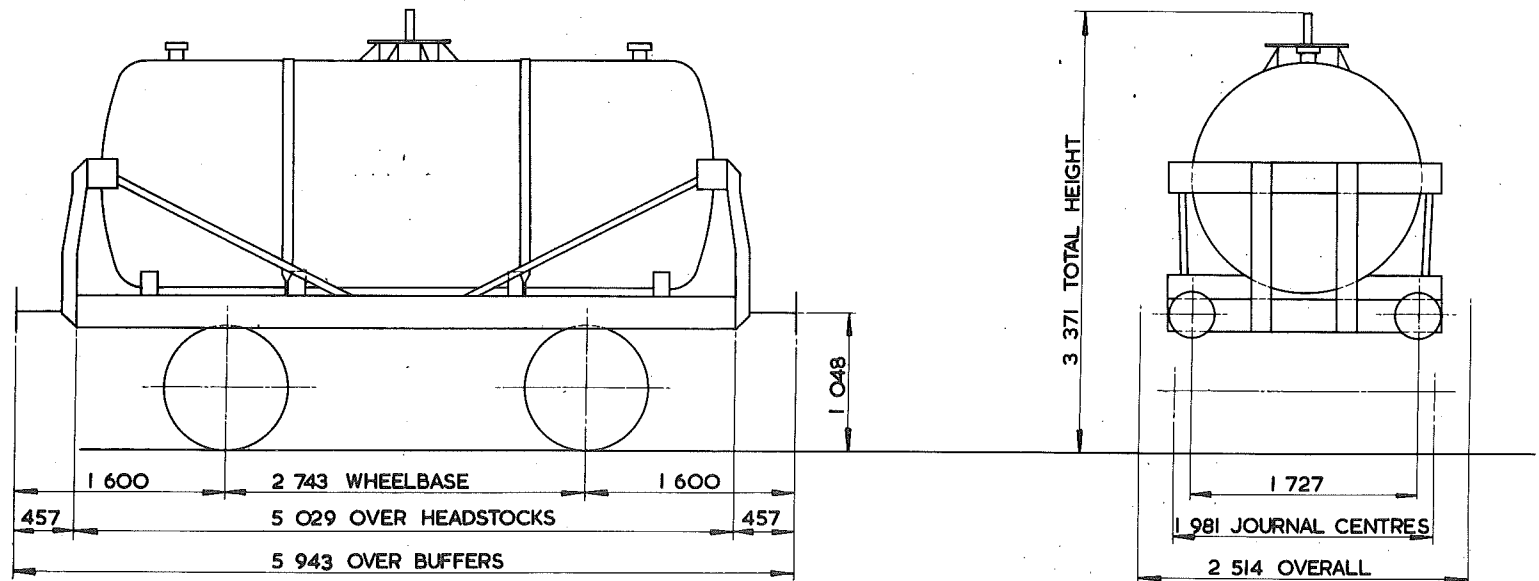

TARE - 8 ⁵⁰⁰ kg
CARRYING CAPACITY - 14 ⁰⁰⁰ kg
CAPACITY -
MAX. SPEED - 45 mile/h
WHEELS - 952 DIA
JOURNALS - 228 x 114 PLAIN BEARINGS

BUFFERS - SPINDLE 330 DIA HEADS
COUPLINGS - INSTANTER
MIN. CURVE - 21 m
GEN. ARRGT. DRG. No. -
BRAKE - HAND LEVER
SUSPENSION - SHOE


BUILDER - CHARLES ROBERTS
OWNER - BRITISH NUCLEAR FUELS LTD. (SPRINGFIELDS). BRITISH NUCLEAR FUELS LTD. (SEASCALE).
REGISTERED BY - C.M. & E.E.(B.R.B.) DERBY
YEAR BUILT - 1950, 1951 & 1955
REGISTRATION Nos. - BNF 40662 - BNF 40671 - B.N.F.L. 40597 - B.N.F.L. 40610
OWNERS Nos. - 4306 W 0062 - 4306 W 0071, 4306 B 0001 - 4306 B 0012, 4306 B 0034 - 4306 B 0035.

TANK WAGON

TRO09A

EXCESS LENGTH	H	M	L	E
tonnes	23	23	9	9
VB				
AB				
RA	1	1	1	1
MAX SPEED	45	45	45	45

TOPS CODE									
CARKND		AARKND			OPERATING PANEL No.				
T	R	Ø	T	R	Ø	A	7	8	1

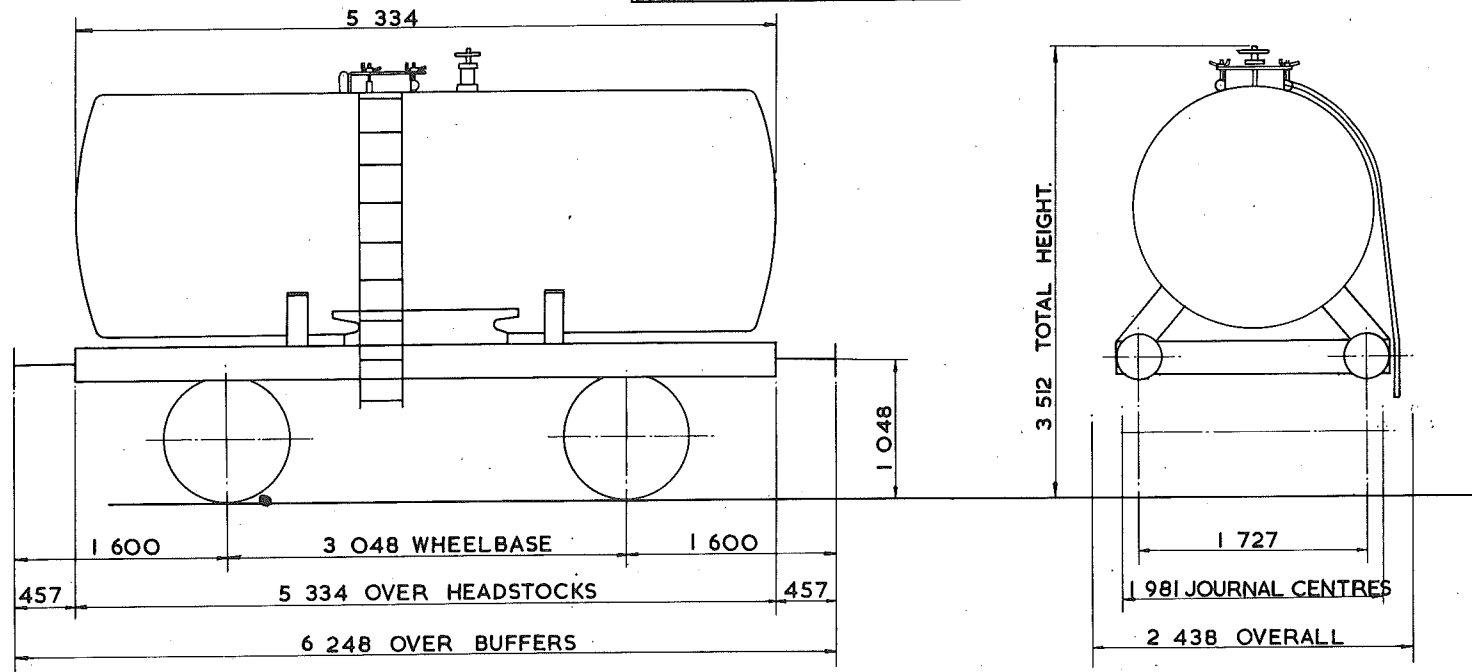

TARE - 8 600 kg.
CARRYING CAPACITY - 14 000 kg.
CAPACITY - 14 320 litres.
MAX. SPEED - 45 mile/h.
WHEELS - 952 DIA.
JOURNALS - 228 x 114 PLAIN BEARINGS

BUFFERS - SPINDLE 330 DIA. HEADS.
COUPLINGS - INSTANTER.
MIN. CURVE - 21m.
GEN. ARRGT. DRG. No. -
BRAKE - HAND LEVER.
SUSPENSION - SHOE.


BUILDER - HURST NELSON.
OWNER - BRITISH BITUMEN EMULSIONS (SCOTLAND) LTD.
REGISTERED BY - C.M. & E.E. (B.R.B.) DERBY.
YEAR BUILT - 1948
REGISTRATION Nos. - 40036
OWNERS Nos. - B9.

TANK WAGON

TR 009 B

EXCESS LENGTH	H	M	L	E
tonnes	23	23	9	9
VB				
AB				
RA	1	1	1	1
MAX. SPEED	45	45	45	45

TOPS CODE		
CARKND	AARKND	OPERATING PANEL No.
T R Ø	T R Ø A	7 8 1

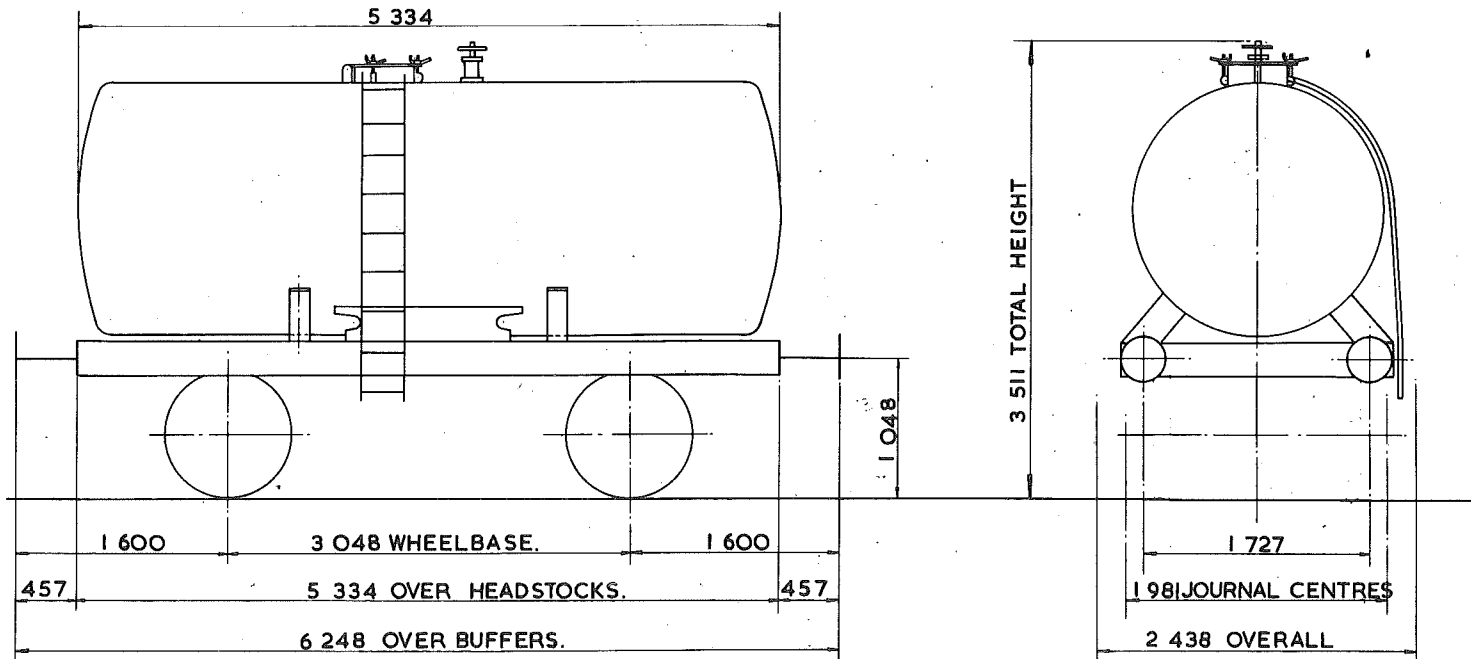

TARE - 8 500 kg
CARRYING CAPACITY - 14 000 kg
CAPACITY - 13 410 litres
MAX. SPEED - 45 mile / h
WHEELS - 952 DIA.
JOURNALS - 228 x 114 PLAIN BEARING.

BUFFERS - SPINDLE 330 DIA. HEADS.
COUPLINGS - INSTANTER.
MIN. CURVE - 21 m
GEN. ARRGT. DRG. No. -
BRAKE - HAND LEVER
SUSPENSION - SHOE

BUILDER - HURST NELSON.
OWNER - BRITISH BITUMEN EMULSIONS (SCOTLAND) LTD.
REGISTERED BY - C.M. & E.E. (B.R.B.) DERBY
YEAR BUILT - 1948
REGISTRATION Nos. - 40037
OWNERS Nos. - 14


EX. PO. DIAGRAM 6/629 (ALLOCATED)

TANK WAGON

TR 015A

EXCESS LENGTH	H	M	L	E
tonnes	20	20	10	10
VB				
AB				
RA	I	I	I	I
MAX SPEED	45	45	45	45

TOPS CODE		
CARKND	AARKND	OPERATING PANEL No.
T R Ø	T R Ø A	7 8 3

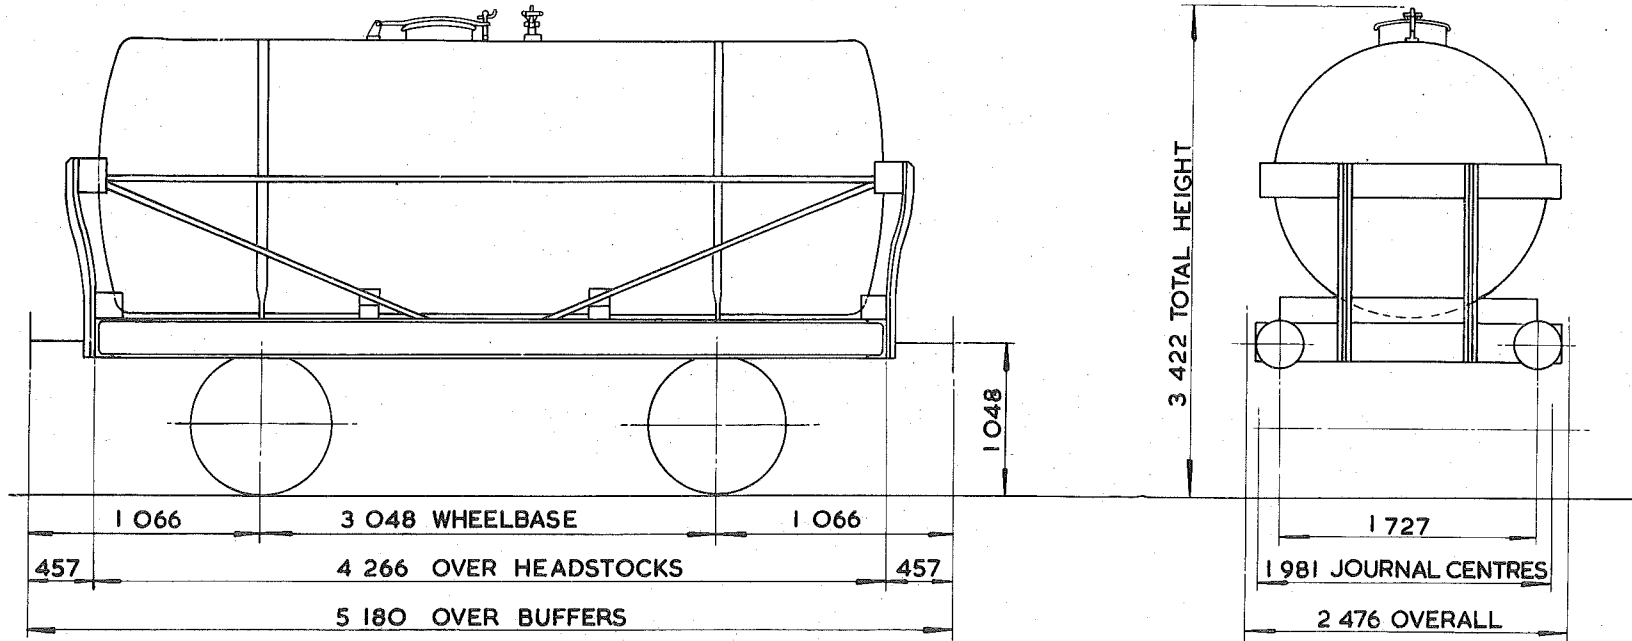

TARE -	9 250 kg
CARRYING CAPACITY -	14 000 kg
CAPACITY -	12 728 litres
MAX. SPEED -	45 mile /h
WHEELS -	952 DIA.
JOURNALS -	228x111 PLAN BEARINGS

BUFFERS -	SPINDLE 330 DIA HEADS.
COUPLINGS -	INSTANTER
MIN. CURVE -	21 m
GEN. ARRGT. DRG. No. -	
BRAKE -	HAND LEVER
SUSPENSION -	SHOE


BUILDER -	HURST NELSON
OWNER -	B.S.C. ORGREAVE
REGISTERED BY -	C.M. & E.E. (B.R.B) DERBY
YEAR BUILT -	1940
REGISTRATION Nos. -	40591 TO 40596
OWNERS Nos. -	26, 36, 39, 47, 58, 59

TANK WAGON

TROI5B

EXCESS LENGTH	H	M	L	E
tonnes	20	20	10	10
VB				
AB				
RA	1	1	1	1
MAX. SPEED	45	45	45	45

TOPS CODE		
CARKND	AARKND	OPERATING PANEL No.
T R Ø	T R Ø A	7 0 3
		8 0 4

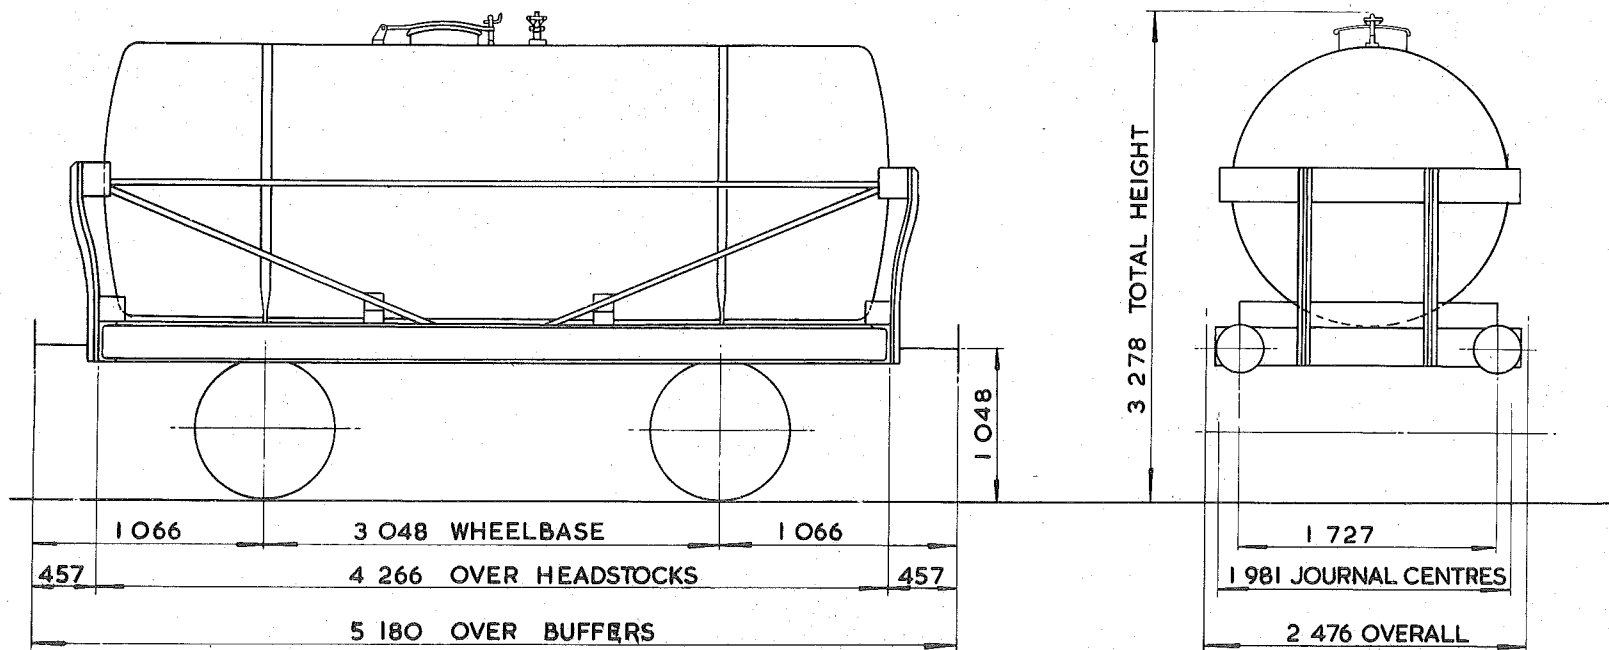

TARE -	9 700 kg
CARRYING CAPACITY -	14 000 kg
CAPACITY -	12.160 litres
MAX. SPEED -	45 mile /h
WHEELS -	952 DIA.
JOURNALS -	254 x 127 PLAIN BEARINGS

BUFFERS -	SPINDLE 330 DIA. HEADS
COUPLINGS -	INSTANTER
MIN. CURVE -	21 m
GEN. ARRGT. DRG. No. -	
BRAKE -	HAND LEVER
SUSPENSION -	SHOE


BUILDER -	CHARLES ROBERTS
OWNER -	N.C.B.
REGISTERED BY -	C.M. & E.E.(B.R.B) DERBY
YEAR BUILT -	1930
REGISTRATION Nos. -	40230 TO 40234
OWNERS Nos. -	7211 - 7215

TANK WAGON

TRO16A

EXCESS LENGTH	H	M	L	E
tonnes	22	22	8	8
VB	0	0	0	0
AB				
RA	1	1	1	1
MAX SPEED	45	45	45	45

TOPS CODE				
CARKND	AARKND	OPERATING PANEL No.		
T	R	P	T	R
P	A			
			8	9
				5

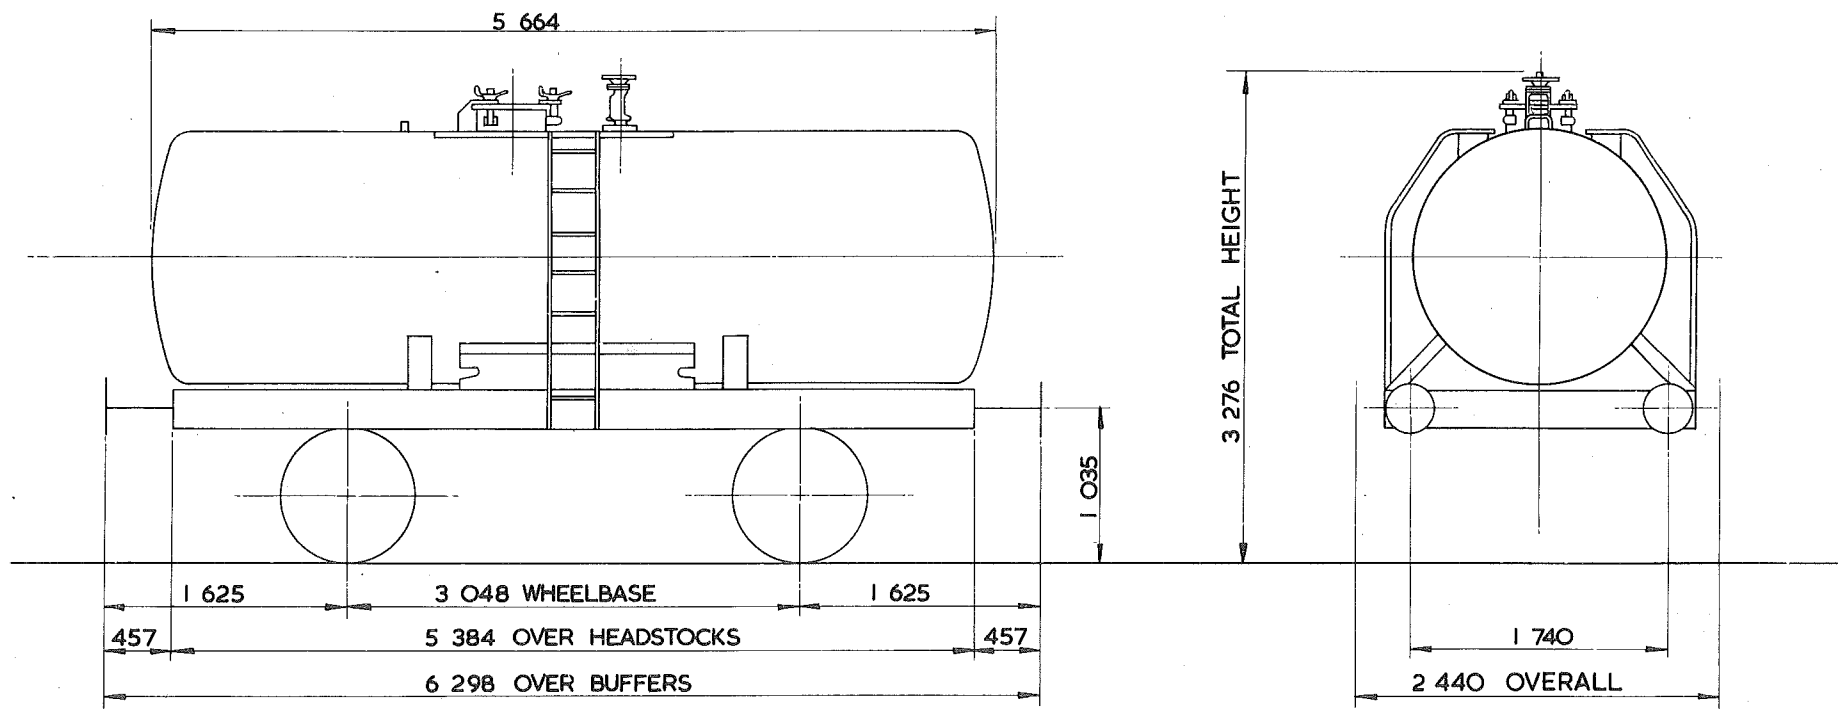

TARE - 8 100 kg
CARRYING CAPACITY - 15 000 kg
CAPACITY -
MAX. SPEED - 45 mile/h
WHEELS - 939 DIA
JOURNALS - 228 x 114 PLAIN BEARINGS

BUFFERS - SPINDLE 330 DIA HEADS
COUPLINGS - INSTANTER
MIN. CURVE - 21 m
GEN. ARRGT. DRG. No. -
BRAKE - VACUUM PIPED & HAND LEVER
SUSPENSION - SHOE


BUILDER - HURST NELSON & SONS Co. LTD.
OWNER - CHIPMAN CHEMICAL Co. LTD
REGISTERED BY - C.M. & E.E.(BR.B.) DERBY
YEAR BUILT - 1958
REGISTRATION Nos. - 40740, 40795, 40798, 40799, 40800.
OWNERS Nos. - 40, 95, 98, 99, 100.

TANK WAGON.

TROI6B

EXCESS LENGTH	H	M	L	E
tonnes	23	23	9	9
VB	7	7	7	7
AB				
RA	1	1	1	1
MAX. SPEED	45	45	45	45

TOPS CODE									
CARKND			AARKND			OPERATING PANEL No.			
T	R	V	T	R	V	A	8	9	6

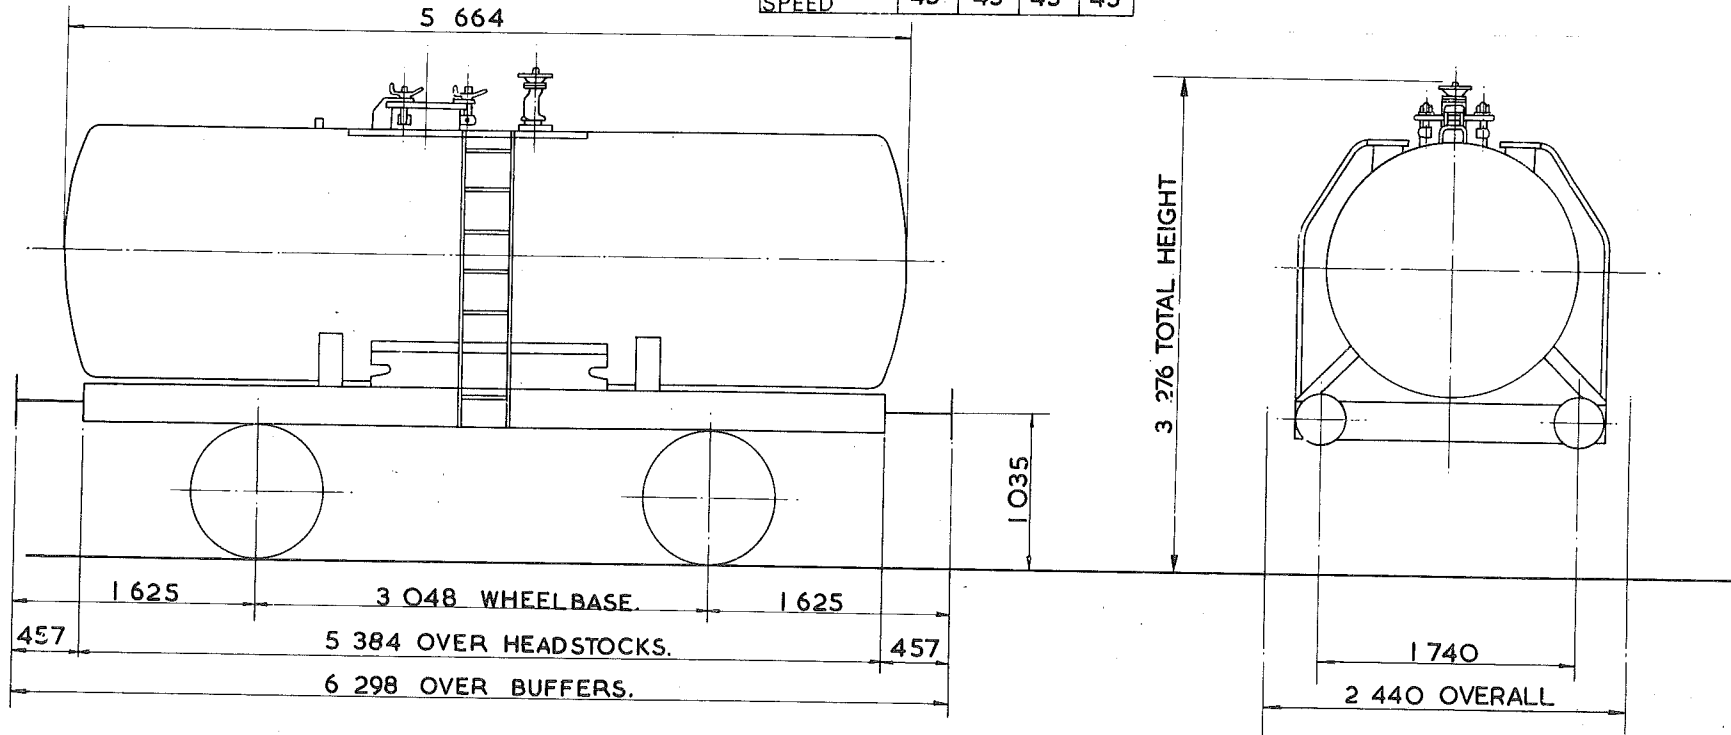

TARE - 8 500 kg
CARRYING CAPACITY - 15 000 kg
CAPACITY-
MAX. SPEED - 45 mile/h
WHEELS - 939 DIA
JOURNALS - 228x114 PLAIN BEARINGS.

BUFFERS - SPINDLE 330 DIA. HEADS.
COUPLINGS - INSTANTER.
MIN. CURVE - 21m.
GEN. ARRGT. DRG. No. -
BRAKE - VACUUM BLOCK & HAND LEVER
SUSPENSION - SHOE.


BUILDER - HURST NELSON & SONS CO. LTD.
OWNER - CHIPMAN CHEMICAL CO. LTD.
REGISTERED BY - C.M. & E.E.(B.R.B) DERBY.
YEAR BUILT - 1958
REGISTRATION Nos. - 40796, 40797.
OWNERS Nos. - 96, 97.

TANK WAGON

TROI7A

EXCESS LENGTH	H	M	L	E
tonnes	24	24	10	10
VB				
AB				
RA	1	1	1	1
MAX. SPEED	45	45	45	45

TOPS CODE		
CARKND	AARKND	OPERATING PANEL No.
T R Ø	T R Ø A	7 6 4

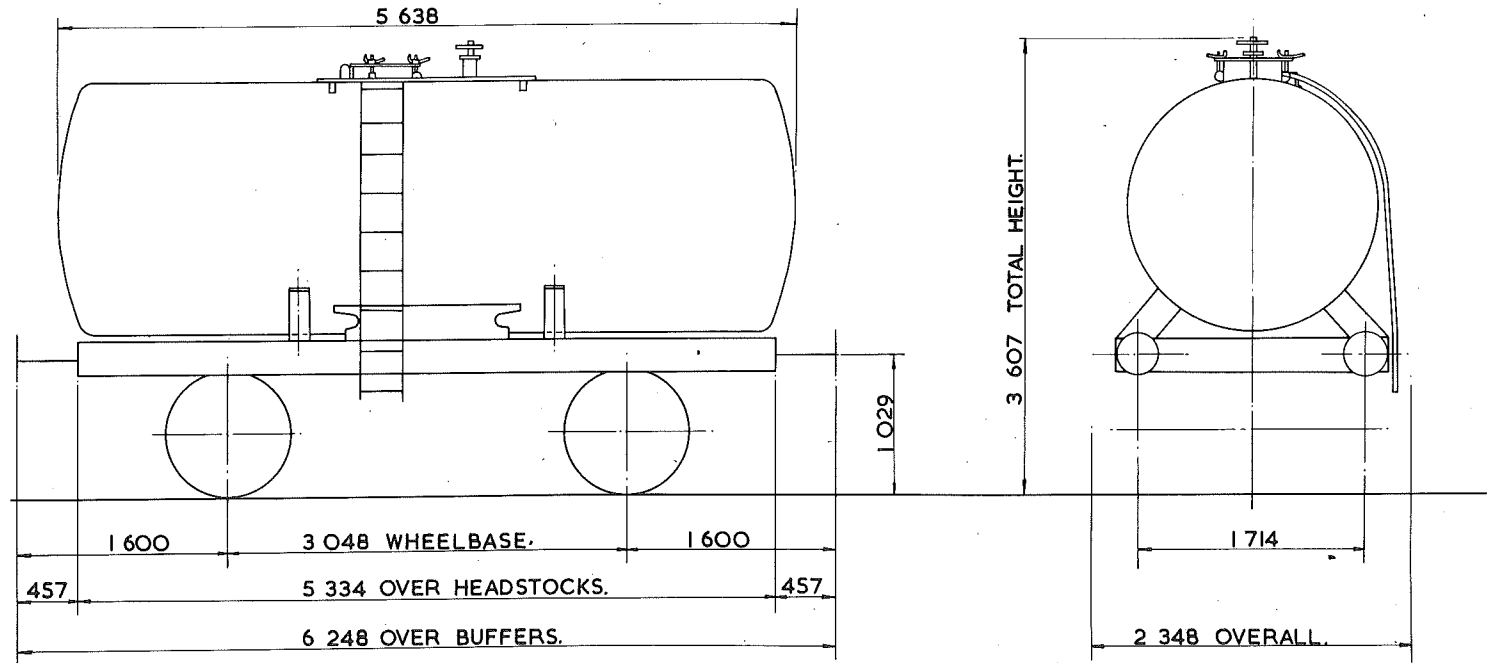

TARE - 9 ³⁵⁰ kg.
CARRYING CAPACITY - 14 ⁰⁰⁰ kg.
CAPACITY - 15911 litres.
MAX. SPEED - 45 mile/h.
WHEELS - 952 DIA.
JOURNALS - 228 x 114 PLAIN BEARINGS.

BUFFERS - SPINDLE 330 DIA. HEADS.
COUPLINGS - INSTANTER
MIN. CURVE - 21m.
GEN. ARRGT. DRG. No. -
BRAKE - HAND LEVER.
SUSPENSION - SHOE.


BUILDER - CAMBRIAN WAGON ENGINEERING.
OWNER - GULF OIL (G.B.) LTD.
REGISTERED BY - C.M. & E.E. (B.R.B.) DERBY.
YEAR BUILT - 1953 & 1956.
REGISTRATION Nos. - 40127, 40130, 40145.
OWNERS Nos. - 77, 82, 98

TANK WAGON

TROI7B

EXCESS LENGTH	H	M	L	E
tonnes	23	23	10	10
VB				
AB				
RA	1	1	1	1
MAX. SPEED	45	45	45	45

TOPS CODE									
CARKND			AARKND			OPERATING PANEL No.			
T	R	Ø	T	R	Ø	E	9	2	6

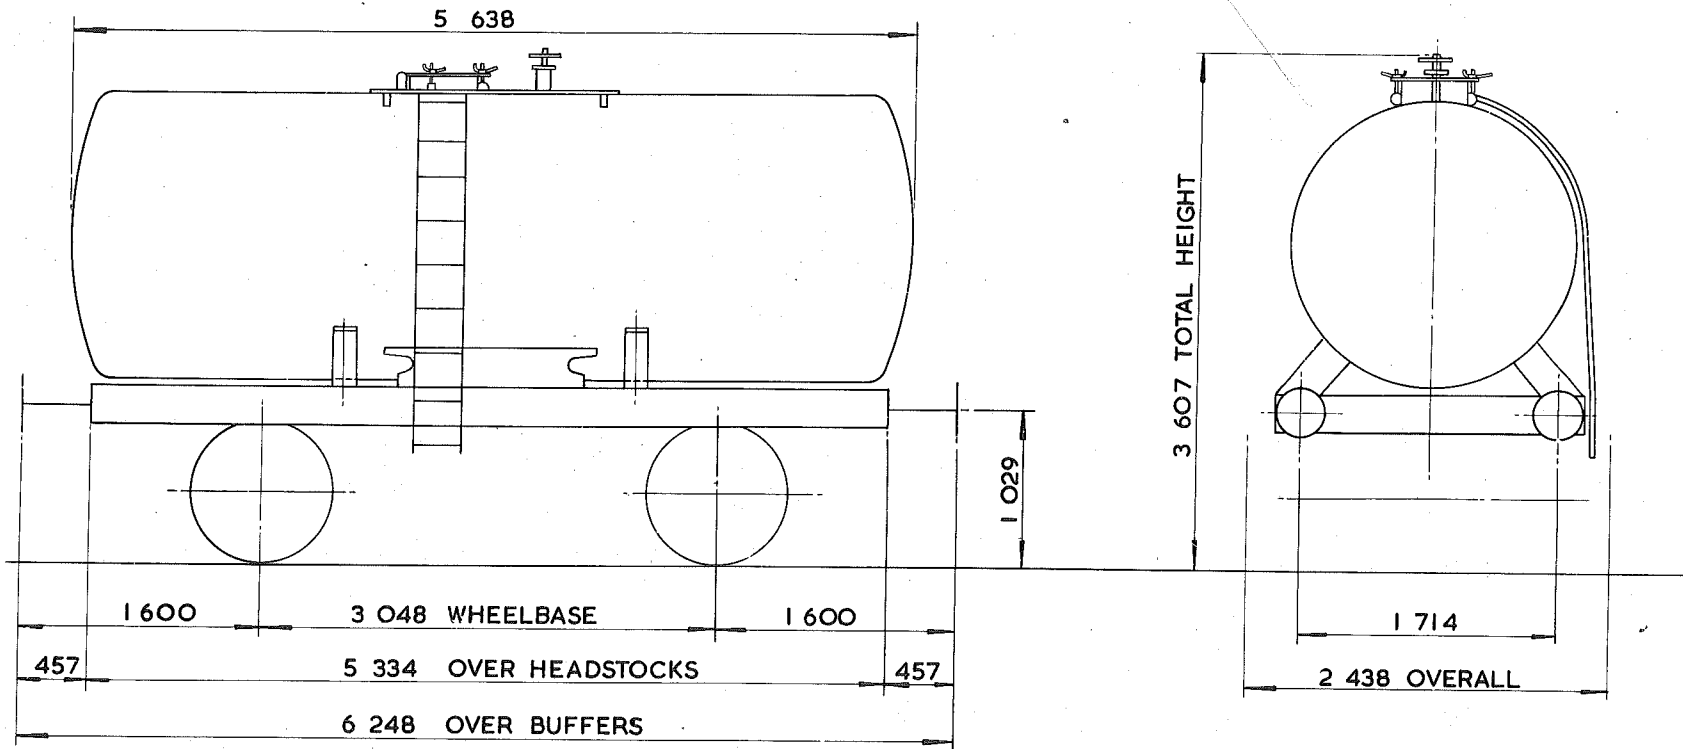

TARE -	9 350 kg
CARRYING CAPACITY -	14 000 kg
CAPACITY -	16000litres
MAX. SPEED -	45 mile/h
WHEELS -	952 DIA.
JOURNALS -	228x114 PLAIN BEARINGS

BUFFERS -	SPINDLE 330 DIA. HEADS
COUPLINGS -	INSTANTER
MIN. CURVE -	21m
GEN. ARRGT. DRG. No. -	
BRAKE -	HAND LEVER
SUSPENSION -	SHOE


BUILDER -	CAMBRIAN WAGON
OWNER -	GULF OIL (G.B.) LTD.
REGISTERED BY -	C.M. & E.E. (B.R.B.) DERBY
YEAR BUILT -	1955/56
REGISTRATION Nos. -	40128 TO 40147 (RANGE)
OWNERS Nos. -	78 TO 100 (RANGE)

TANK WAGON

TRO20A

EXCESS LENGTH	4	H	M	L	E
tonnes	24	24	9	9	
VB					
AB					
RA	I	I	I	I	
MAX SPEED	45	45	45	45	

TOP'S CODE										
CARKND		AARKND			OPERATING PANEL No.					
T	R	Ø	T	R	Ø	E	I	O	I	5

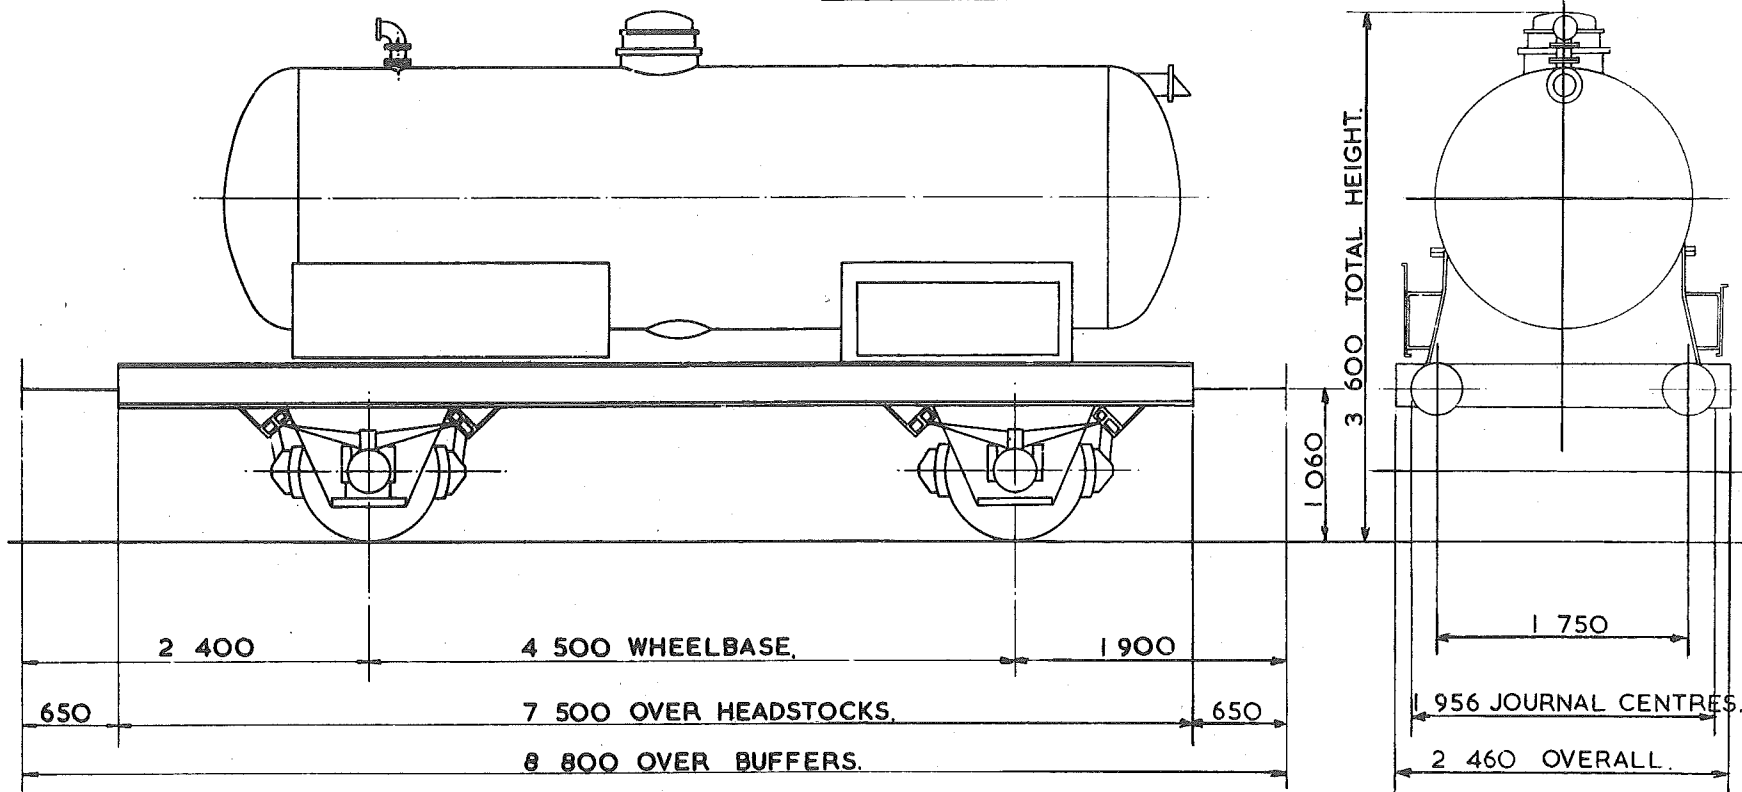

TARE - 9150kg.
CARRYING CAPACITY - 15000kg.
CAPACITY - 18196 litres
MAX SPEED - 45 mile/h
WHEELS - 970 DIA.
JOURNALS - 203 x 114 PLAIN BEARING.

BUFFERS - 370 DIA. HEADS
COUPLINGS - B.R. SCREW
MIN. CURVE - 31m.
GEN. ARRGT. DRG. No. -
BRAKE - HAND LEVER
SUSPENSION - DOUBLE LINK

BUILDER
OWNER M.O.D.A.
REGISTERED BY C.M.&E.E.(B.R.B.)DERBY.
YEAR BUILT 1945.
REGISTRATION Nos 40297 TO 40344
OWNERS Nos P2 TO P6(RANGE.)


EX. P.O. DIAGRAM 6/791 (ALLOCATED)

TANK WAGON

TRO21A

EXCESS LENGTH	H	M	L	E
tonnes	23	23	9	9
VB				
AB				
RA	1	1	1	1
MAX. SPEED	45	45	45	45

TOPS CODE			
CARKND	AARKND	OPERATING PANEL No	
T	R	Ø	A
7	8	1	

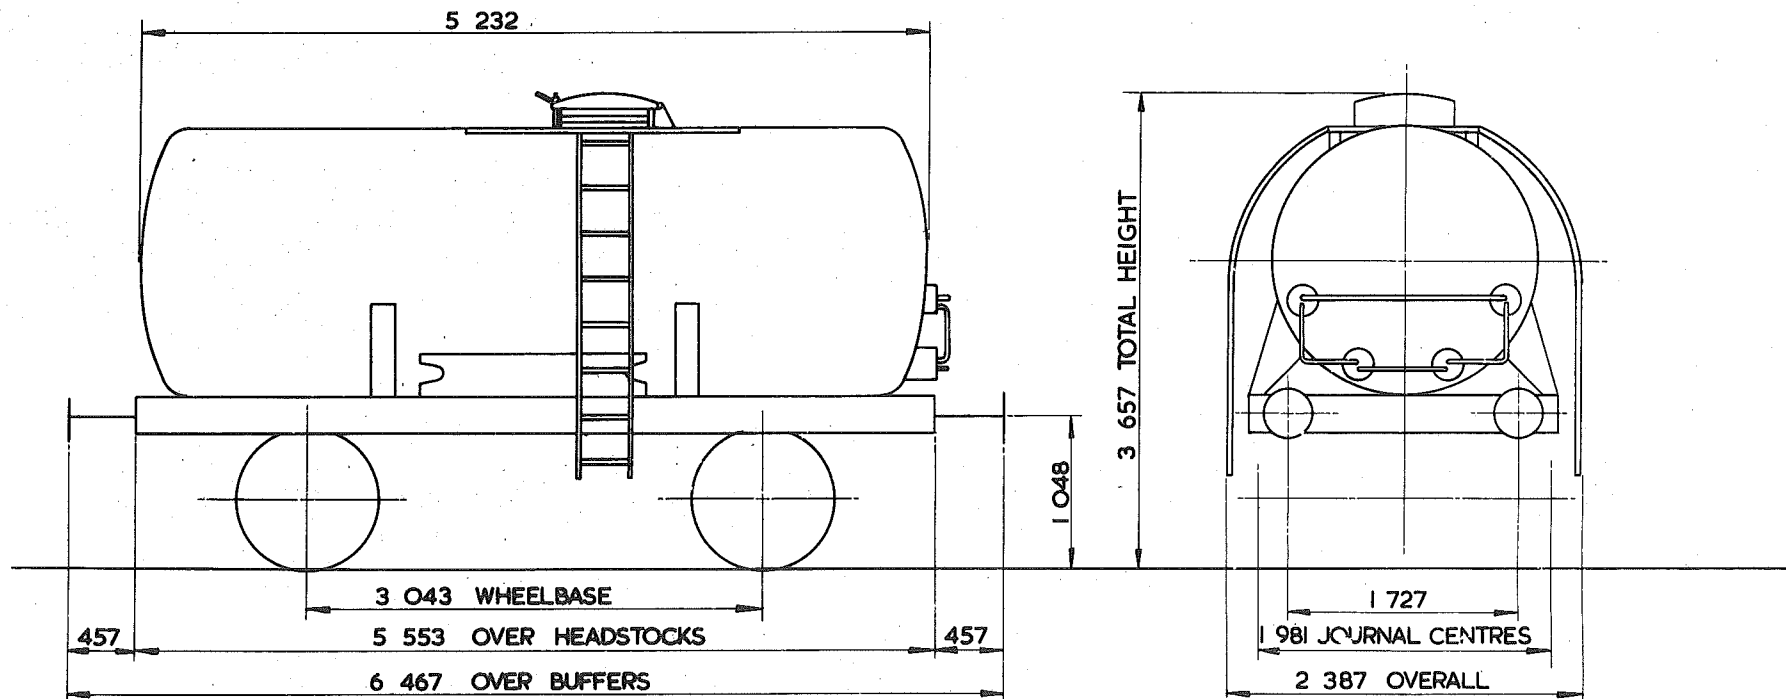

TARE - 8750 kg
CARRYING CAPACITY - 14 000 kg
CAPACITY -
MAX. SPEED - 45 mile/h
WHEELS - 952 DIA
JOURNALS - 228 x 114 DIA PLAIN BEARINGS

BUFFERS - SPINDLE 330 DIA HEADS
COUPLINGS - INSTANTER
MIN. CURVE - 21 m
GEN. ARRGT. DRG. No. -
BRAKE - HAND LEVER
SUSPENSION - SHOE


BUILDER - CHARLES ROBERTS
OWNER - N.C.B. (THOS NESS LTD) WINGERWORTH
REGISTERED BY - C.M. & E.E. (B.R.B.) DERBY
YEAR BUILT - 1951
REGISTRATION Nos. - 40345 TO 40358
OWNERS Nos. - A/T 02 TO A/T 18 (RANGE)

TANK WAGON

TRO22A

EXCESS LENGTH	H	M	L	E
tonnes	24	24	9	9
VB				
AB				
RA	1	1	1	1
MAX. SPEED	45	45	45	45

TOPS CODE					
CARKND		AARKND		OPERATING PANEL No.	
T	R	Ø	T	R	Ø
A				7	6
				3	

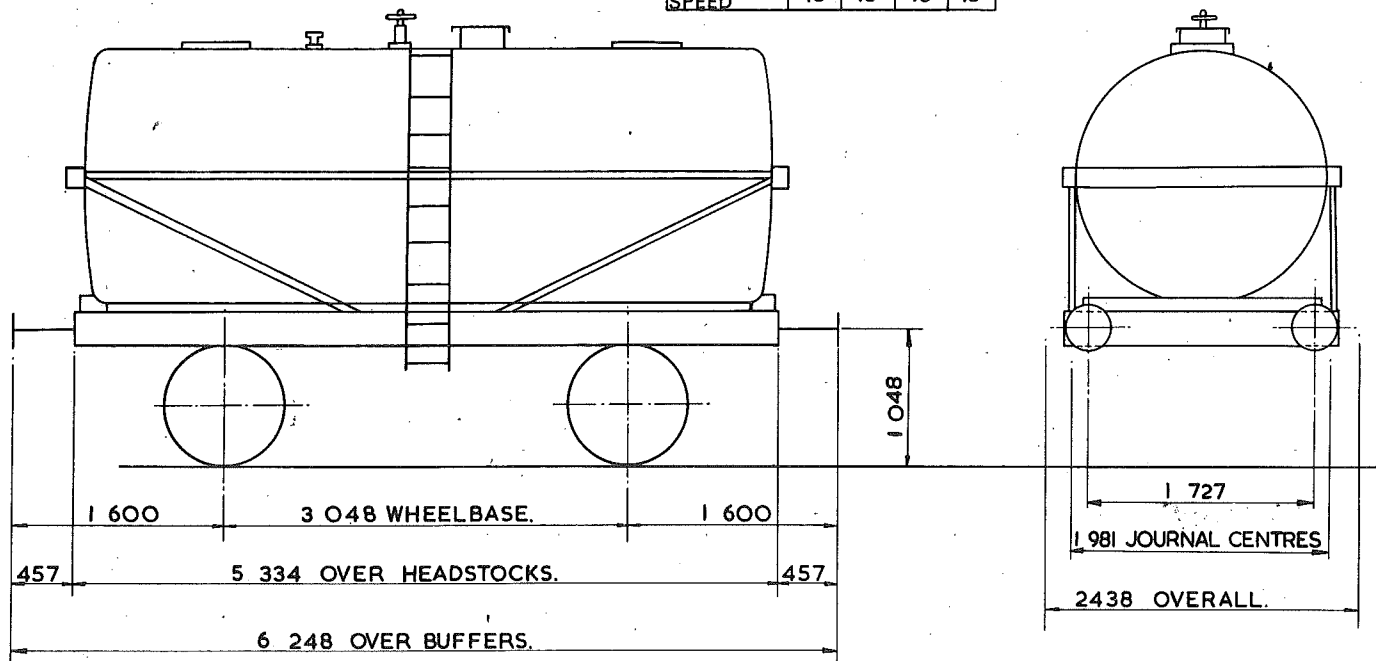

TARE - 9650 kg
CARRYING CAPACITY - 14 000 kg
CAPACITY -
MAX. SPEED - 45 mile/h
WHEELS - 952 DIA.
JOURNALS - 254 X 127 PLAIN BEARINGS.

BUFFERS - SPINDLE 330 DIA. HEADS
COUPLINGS - INSTANTER.
MIN. CURVE - 21m
GEN. ARRGT. DRG. No. -
BRAKE - HAND LEVER
SUSPENSION - SHOE.

BUILDER - HURST NELSON
OWNER - E.G. STEELE.
REGISTERED BY - C.M. & E.E. (B.R.B.) DERBY
YEAR BUILT - 1949 & 1951.
REGISTRATION Nos. - 40589, 40590, 47943.
OWNERS Nos. - 145, 224, 231


EX. PO. DIAGRAM 6/740 (ALLOCATED)

TANK WAGON

TRO25A

EXCESS LENGTH	2	H	M	L	E
tonnes	24	24	10	10	
VB					
AB					
RA	1	1	1	1	
MAX. SPEED	45	45	45	45	

TOPS CODE		
CARKND	AARKND	OPERATING PANEL No.
T	R Ø	T R Ø A
		B O 4

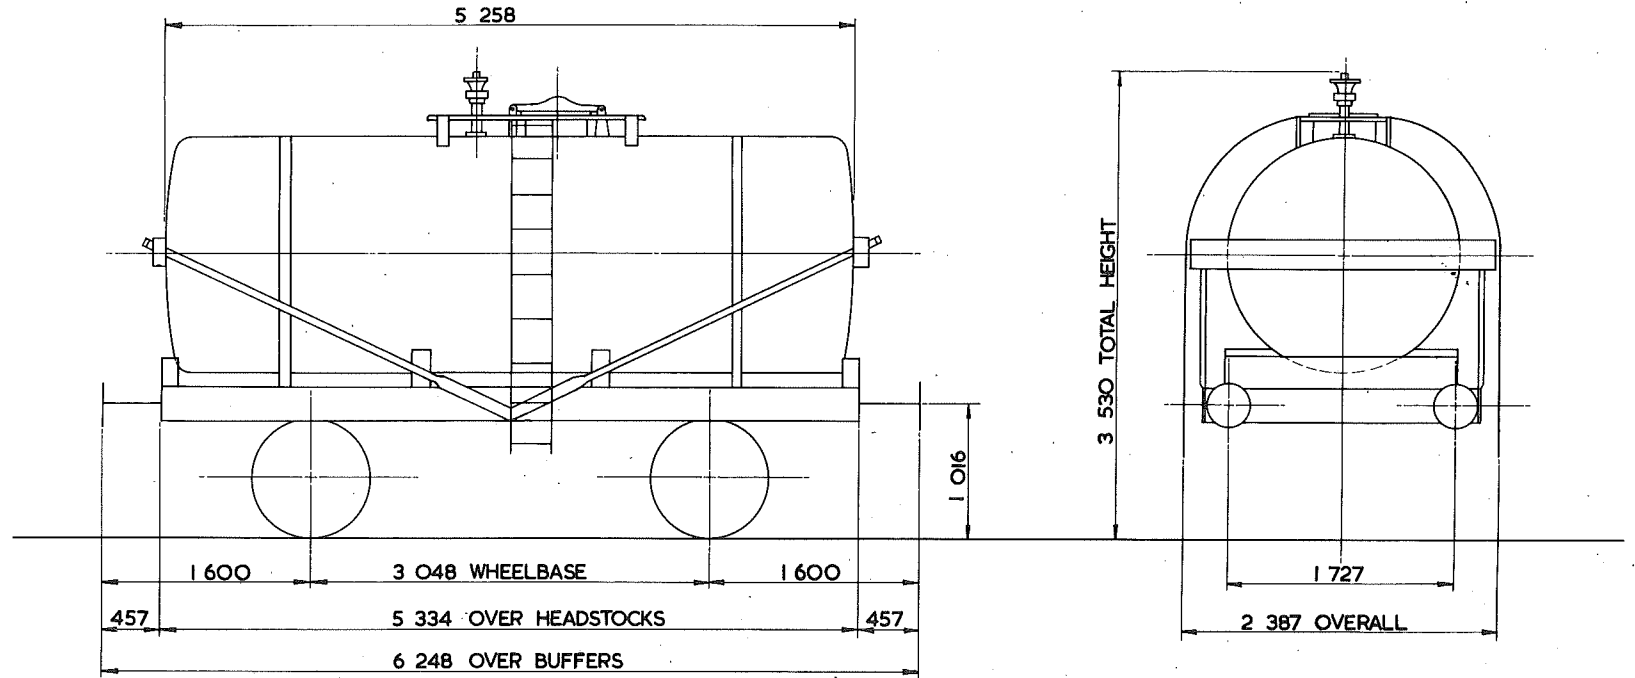

TARE - 10 ²⁰⁰ kg
CARRYING CAPACITY - 14 000 kg
CAPACITY - 12 160 litres
MAX. SPEED - 45 mile/h
WHEELS - 9 1/4 DIA
JOURNALS - 228 x 1 1/4 PLAIN BEARINGS

BUFFERS - SPINDLE 330 DIA HEADS
COUPLINGS - INSTANTER
MIN. CURVE - 21 m
GEN. ARRGT. DRG. No. -
BRAKE - HAND LEVER
SUSPENSION - SHOE

BUILDER - CHARLES ROBERTS.
OWNER - N.C.B.
REGISTERED BY - C.M. & E.E.(B.R.B) DERBY
YEAR BUILT - 1950
REGISTRATION Nos. - 40224 TO 40229
OWNERS Nos. - 7224 TO 7229


EX. P.O. DIAGRAM 6/38 (ALLOCATED).

TANK WAGON

TRO27A

EXCESS LENGTH	H	M	L	E
tonnes	26	26	13	13
VB				
AB				
RA	1	1	1	1
MAX. SPEED	45	45	45	45

TOPS CODE		
CARKND	AARKND	OPERATING PANEL No.
T R Ø	T R Ø A	9 8 2

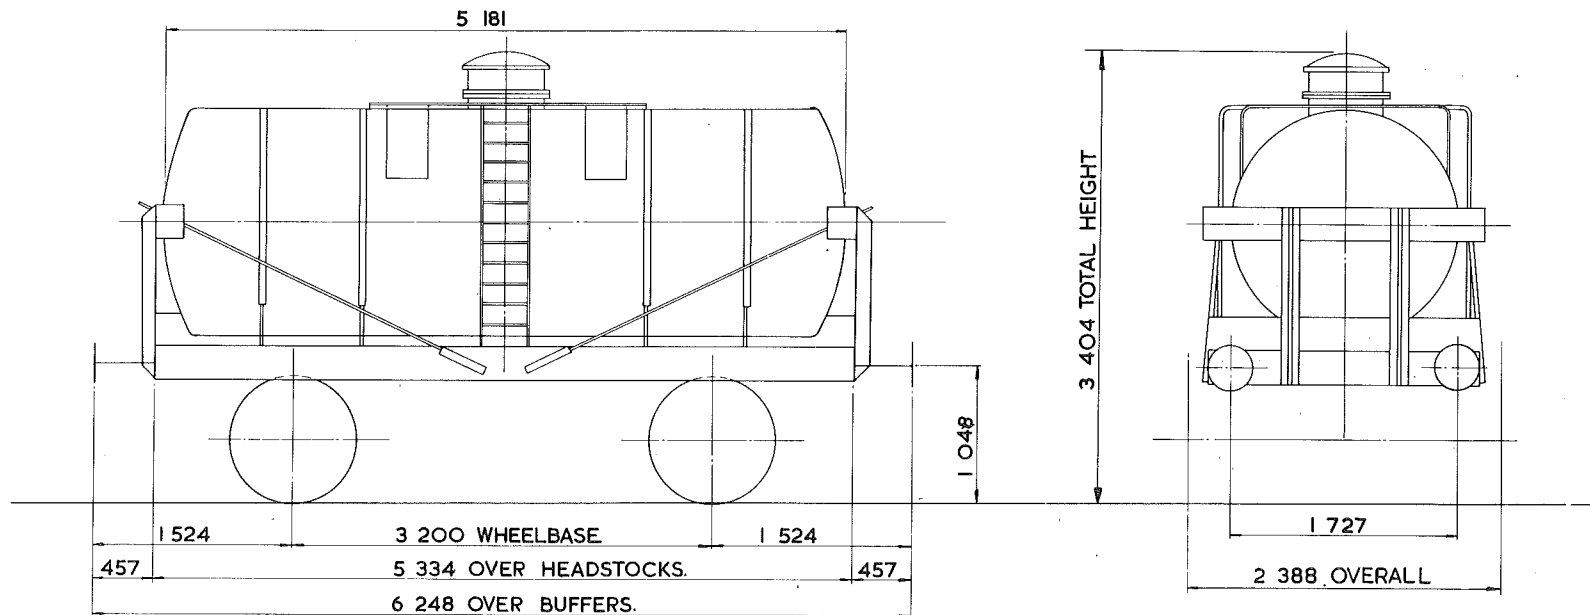

TARE - 12700kg 14550kg
CARRYING CAPACITY - 23000kg 14000kg
CAPACITY - 11470 litres
MAX SPEED - 45 mile/h.
WHEELS - 952 DIA.
JOURNALS - 254x127 PLAIN BEARINGS 127 DIA. ROLLER BEARINGS (909 ONLY)

BUFFERS - SPINDLE 330 DIA. HEADS
COUPLINGS - INSTANTER.
MIN. CURVE - 21m.
GEN. ARRGT. DRG. No. -
BRAKE - HAND LEVER
SUSPENSION - SHOE.

BUILDER - CHARLES ROBERTS LTD.
OWNER - ASSOCIATED OCTEL.
REGISTERED BY - C.M. & E.E.(B.R.B.) DERBY.
YEAR BUILT - 1940.
REGISTRATION Nos. - 47006 & 47009
OWNERS Nos. - 907 & 909


EX. P.O. DIAGRAM 6/613 (ALLOCATED.)

TANK WAGON-CHLORINE

TRO28A

EXCESS LENGTH	H	M	L	E
tonnes	26	26	13	13
VB				
AB	0	0	0	0
RA	1	1	1	1
MAX SPEED	45	45	45	45

TOPS CODE		
CARKND	AARKND	OPERATING PANEL No.
T R 0	T R 0 A	0 8 2
9	Q	1 2 4 3

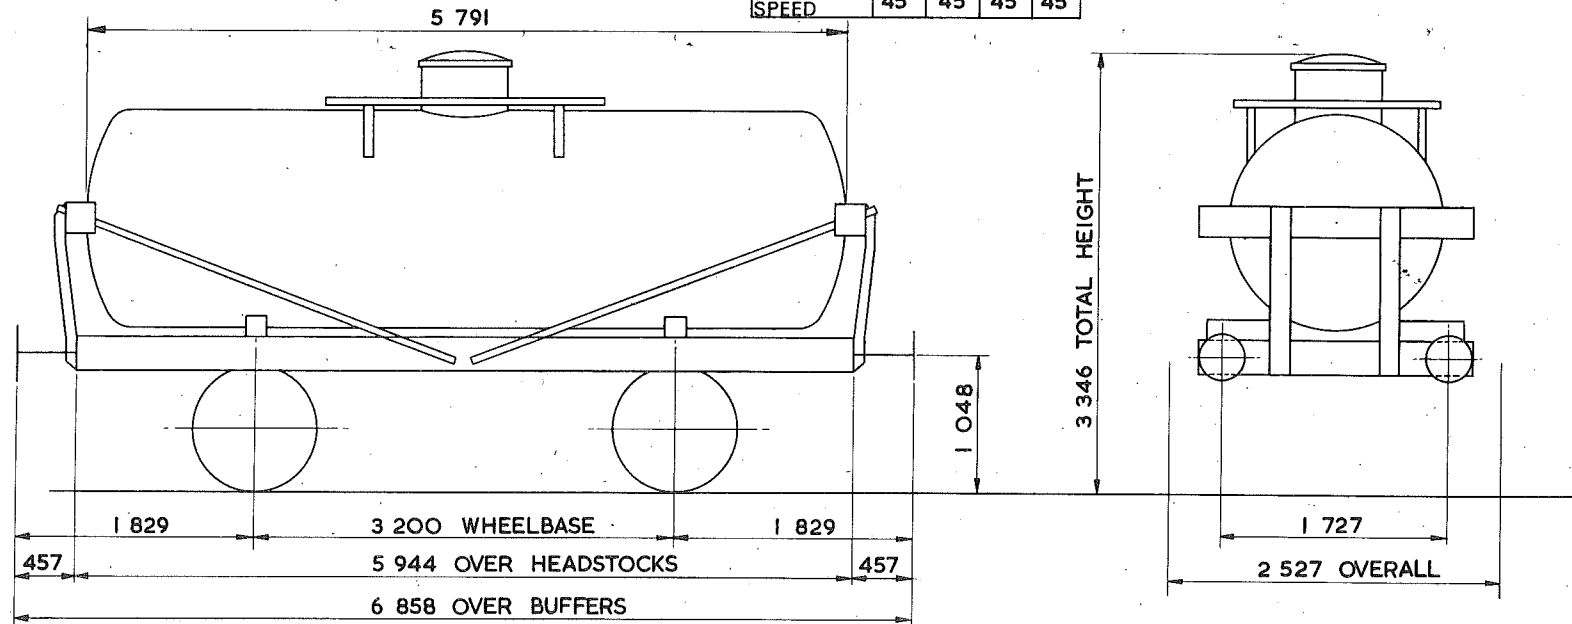

TARE - 12 600 kg
CARRYING CAPACITY - 14 000 kg
CAPACITY - 11 460 litres
MAX. SPEED - 45 mile/h
WHEELS - 952 DIA.
JOURNALS - 130 DIA. ROLLER BEARINGS

BUFFERS - SPINDLE 330 DIA. HEADS
COUPLINGS - INSTANTER
MIN. CURVE - 21m
GEN. ARRGT. DRG. No. -
BRAKE - HAND LEVER AIR PIPE & HAND LEVER
SUSPENSION - SHOE


BUILDER - HURST NELSON
OWNER - ASSOCIATED OCTEL
REGISTERED BY - C.M. & E.E. (B.R.B.) DERBY
YEAR BUILT - 1958
REGISTRATION Nos. - 47009 TO 47042
OWNERS Nos. - 910 TO 934, 936 TO 944

TANK WAGON (CHLORINE)

TRO28B

EXCESS LENGTH	I	H	M	L	E
tonnes	26	26	13	13	
VB					
AB	0	0	0	0	
RA	1	1	1	1	
MAX. SPEED	45	45	45	45	

TOPS CODE										
CARKND		AAF.KND			OPERATING PANEL No					
T	R	Q	T	R	Q	A	1	2	4	3

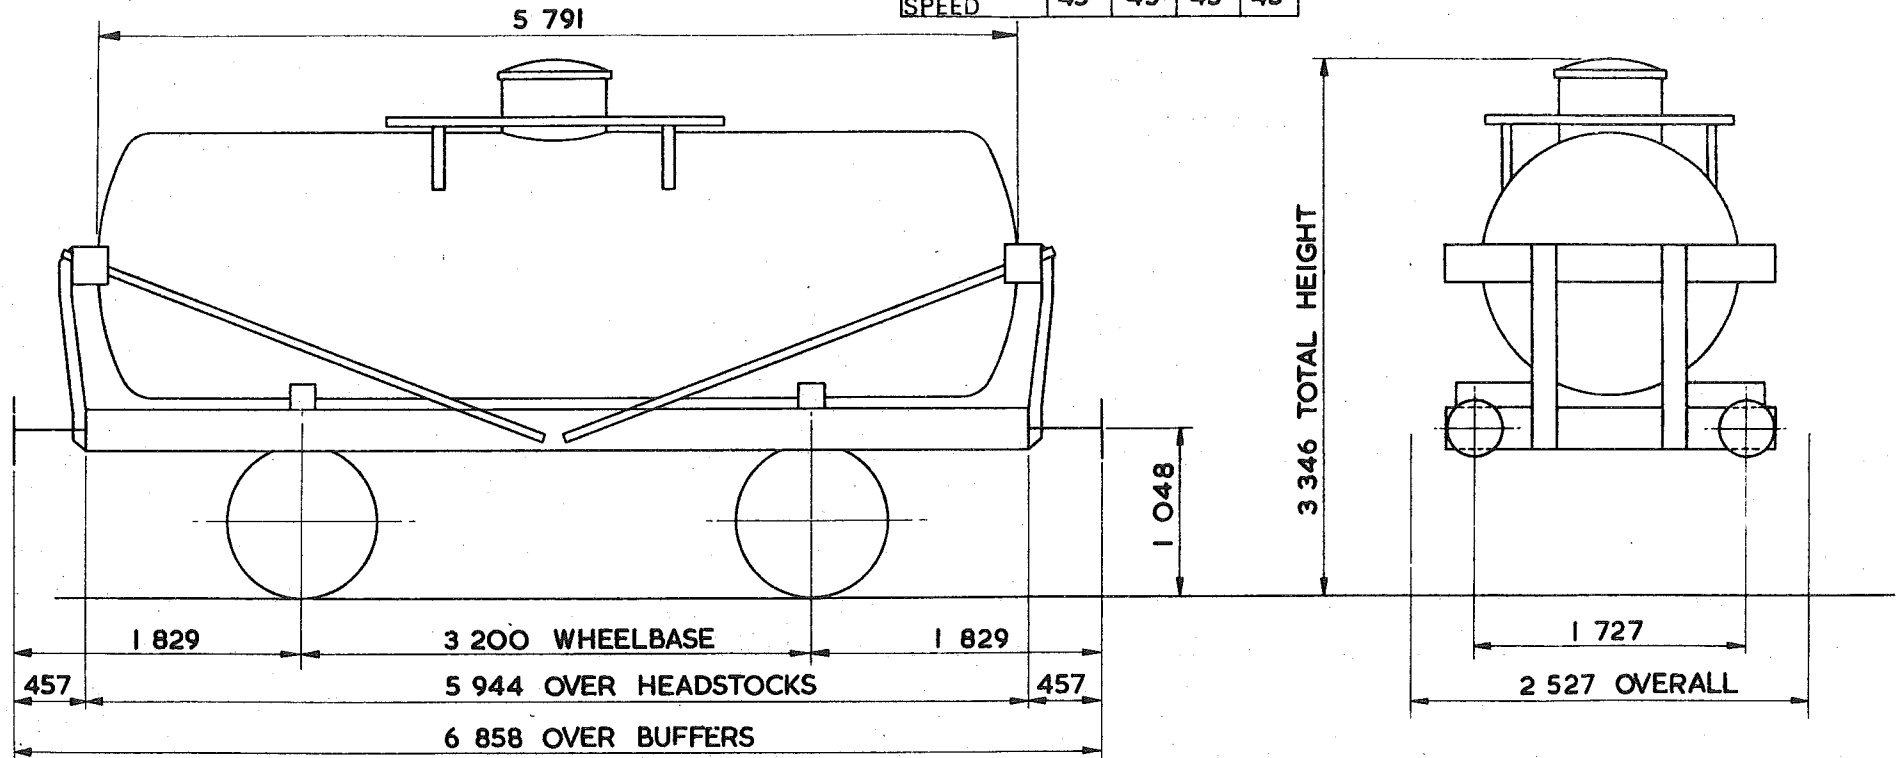

TARE - 12 600 kg
CARRYING CAPACITY - 14 000 kg
CAPACITY - 11 460 litres
MAX. SPEED - 45 mile/h
WHEELS - 952 DIA.
JOURNALS - 130 DIA. ROLLER BEARINGS

BUFFERS - SPINDLE 330 DIA. HEADS
COUPLINGS - INSTANTER
MIN. CURVE - 21m
GEN. ARRGT. DRG. No. -
BRAKE - AIR PIPED & HAND LEVER.
SUSPENSION - SHOE



BUILDER - HURST NELSON
OWNER - ASSOCIATED OCTEL
REGISTERED BY - C.M. & E.E. (B.R.B.) DERBY
YEAR BUILT - 1958
REGISTRATION Nos 47009 TO 47042
OWNERS Nos 910 TO 934, 936 TO 944

TANK WAGON CHLORINE

TRO32A

EXCESS LENGTH	I	H	M	L	E
tonnes	27	27	13	13	
VB	0	0	0	0	
AB					
RA	1	1	1	1	
MAX SPEED	45	45	45	45	

TOPS CODE					
CARKND	AARKND	OPERATING PANEL No.			
T	R	P	T	R	P
A				8	1
					8

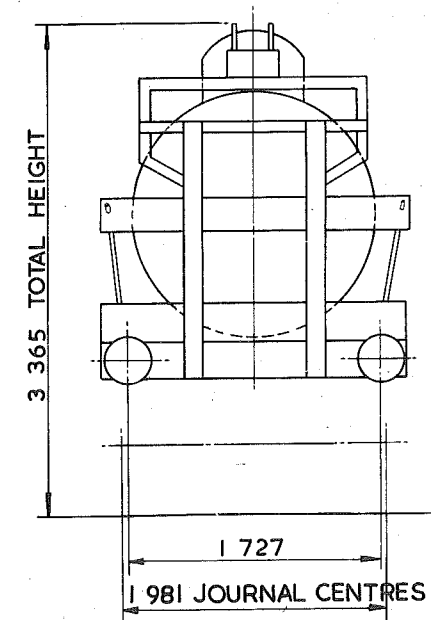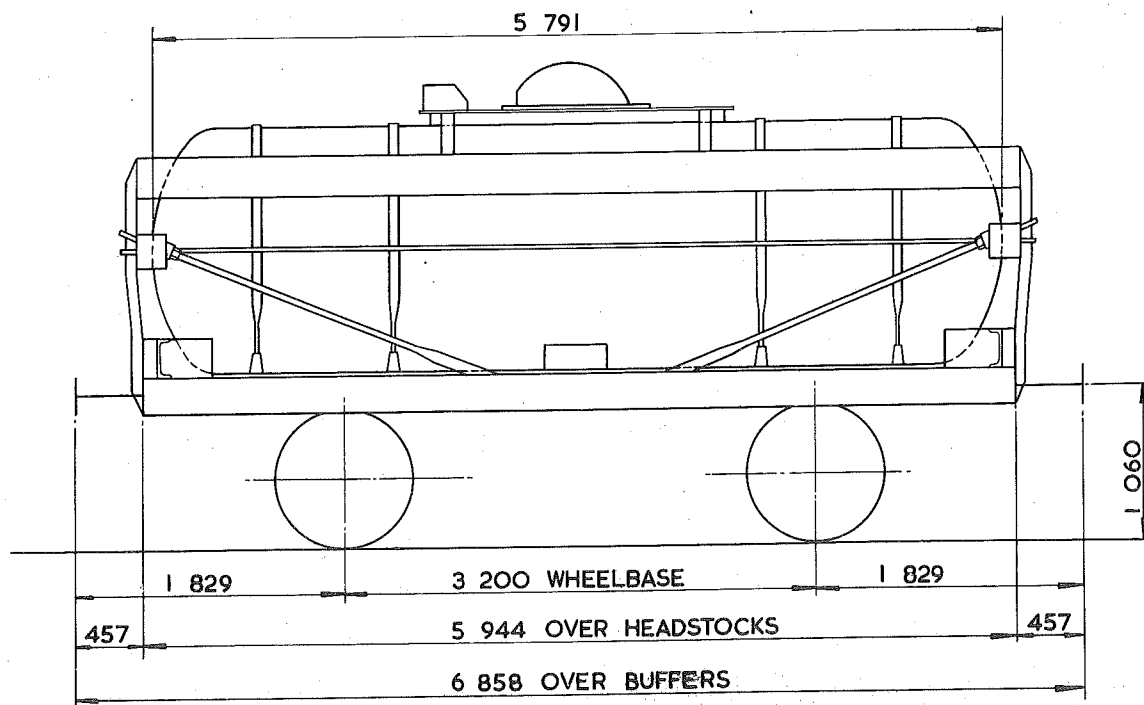

TARE - 12700 kg
CARRING CAPACITY - 14000 kg
CAPACITY - 11460 litres
MAX. SPEED - 45 mile/h
WHEELS - 952 DIA.
JOURNALS - 254 x 127 PLAIN BEARINGS

BUFFERS - SPINDLE 330 DIA. HEADS
COUPLINGS - INSTANTER
MIN. CURVE - 21m
GEN. ARRGT. DRG. No. -
BRAKE - VACUUM PIPED & HAND LEVER
SUSPENSION - SHOE



BUILDER - CHARLES ROBERTS
OWNER - B.P. CHEMICALS
REGISTERED BY - C.M. & E.E. (B.R.B.) DERBY
YEAR BUILT - 1950
REGISTRATION Nos. - 47130 TO 47143
OWNERS Nos. - T78 TO T91

TANK WAGON

TRO32B

EXCESS LENGTH	I	H	M	L	E
tonnes	28	25	13	13	
VB					
AB					
RA	2	1	1	1	
MAX. SPEED	45	45	45	45	

TGPS CODE					
CARKND	AARKND	OPERATING RANGE No.			
T	R	Ø	T	R	Ø
A	9	2	8		

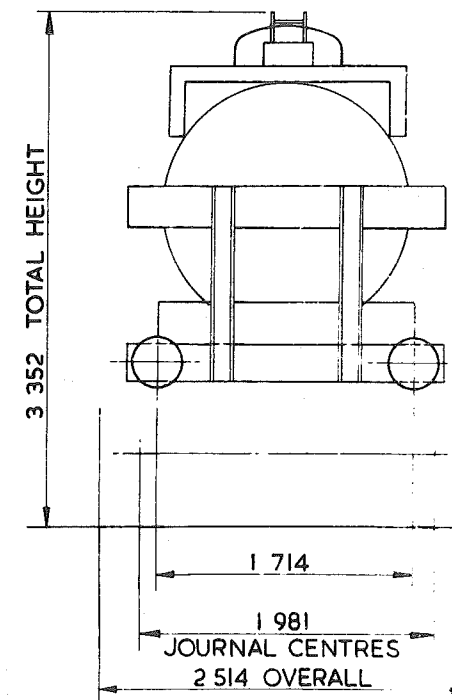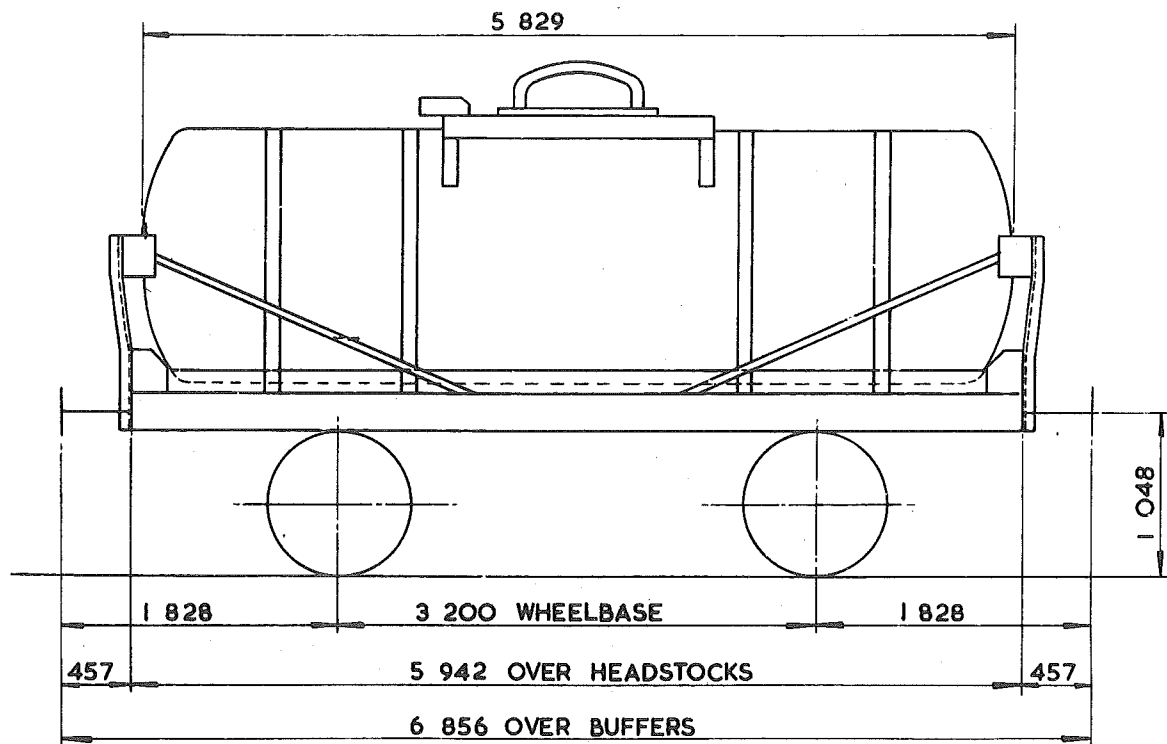

TARE - 12700 kg
CARRYING CAPACITY- 14000 kg
CAPACITY- 11520 litres
MAX SPEED - 45 mile/h
WHEELS - 952 DIA.
JOURNALS - 254 x 127 PLAIN BEARINGS

BUFFERS - SELF CONTAINED 330 DIA. HEADS
COUPLINGS INSTANTER
MIN. CURVE - 21 m
GEN. ARRGT. DRG. No. -
BRAKE - HAND LEVER
SUSPENSION - SHOE

BUILDER - R.Y. PICKERING LTD.
OWNER - I.C.I. MOND DIVISION
REGISTERED BY - C.M. & E.E. (B.R.B.) DERBY
YEAR BUILT - 1942, 3, 4, 5, 9, 50, 1 & 4
REGISTRATION No - 47417 TO 47555
OWNERS Nos - 1232 TO 1491 (RANGE)



EX PO. DIAGRAM 6/43 (ALLOCATED)

TANK WAGON

TRO33B

EXCESS LENGTH	H	M	L	E
tonnes	27	27	12	12
VB				
AB				
RA	1	1	1	1
MAX. SPEED	45	45	45	45

TOPS CODE			
CARKND	AARKND	OPERATING PANEL No.	
T R Ø	T R Ø A	8	1 2

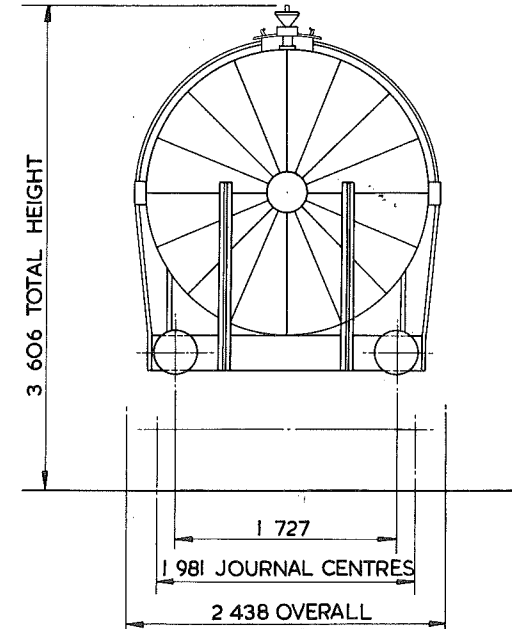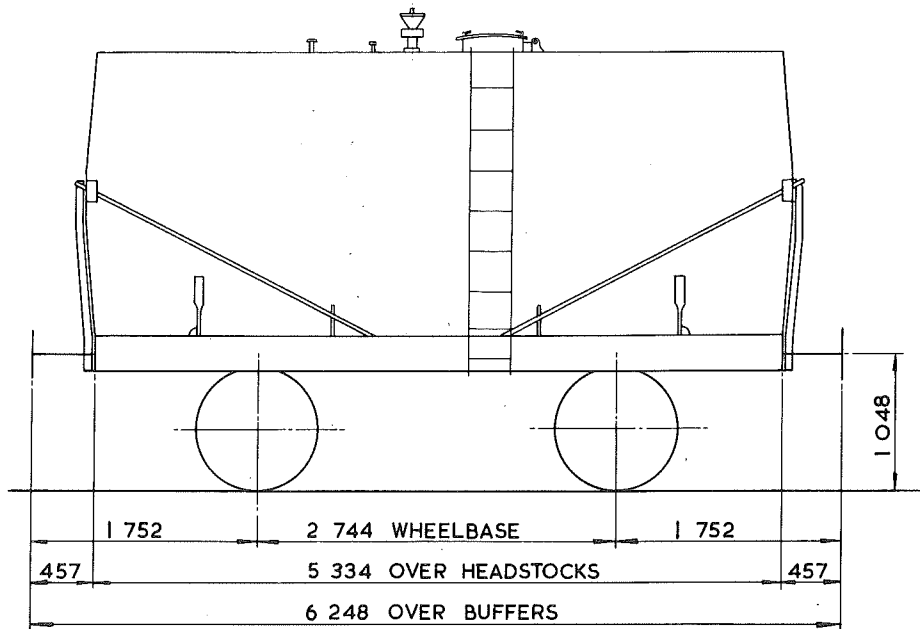

TARE - 12 000 kg
CARRYING CAPACITY - 15 000 kg
CAPACITY -
MAX. SPEED - 45 mile/h
WHEELS - 952 DIA.
JOURNALS - 254 x 127 PLAIN BEARINGS

BUFFERS - SPINDLE 330 DIA. HEADS
COUPLINGS - INSTANTER
MIN. CURVE - 21 m
GEN. ARRGT. DRG. No. -
BRAKE - HAND LEVER
SUSPENSION - SHOE

BUILDER - HURST NELSON
OWNER - WM BRIGGS & SONS LTD.
REGISTERED BY - C.M.&E.E. (B.R.B.) DERBY
YEAR BUILT - 1933
REGISTRATION Nos. - 47084 TO 47087 (RANGE)
OWNERS Nos. - 39 TO 42 (RANGE)

54-27


EX PO. DIAGRAM 6/620 (ALLOCATED)

TANK WAGON

TRO35A

EXCESS LENGTH	I	H	M	L	E
tonnes	27	27	13	13	
VB					
AB					
RA	I	I	I	I	
MAX. SPEED	45	45	45	45	

TOPS CODE					
CARKND	AARKND		OPERATING PANEL No		
T	R	Ø	T	R	Ø
A	B	O	O		

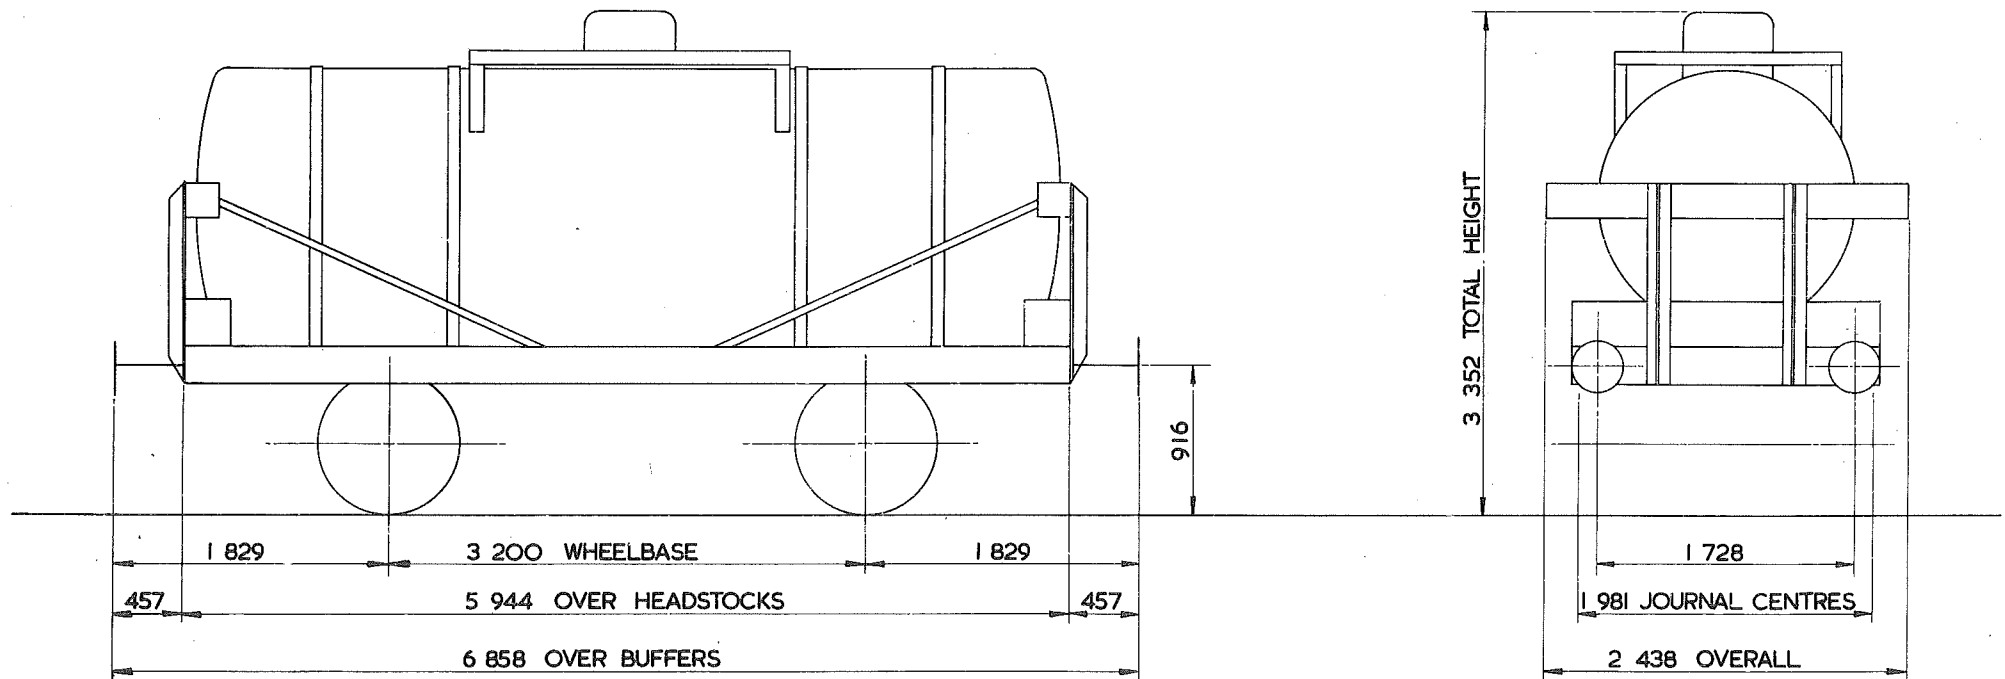

TARE -	12 150 kg
CARRYING CAPACITY -	15 000 kg
CAPACITY -	
MAX. SPEED -	45 mile/h
WHEELS -	952 DIA
JOURNALS -	254 x 127 PLAIN BEARINGS

BUFFERS -	SPINDLE 304 DIA HEADS
COUPLINGS -	INSTANTER
MIN. CURVE -	31 m
GEN. ARRGT. DRG. No. -	
BRAKE -	HAND LEVER
SUSPENSION -	SHOE


BUILDER -	GRAZEBROOK LTD
OWNER -	B.P. CHEMICALS (MURGATROYD).
REGISTERED BY -	C.M. & E.E. (B.R.B.) DERBY
YEAR BUILT -	1950
REGISTRATION Nos. -	47144 - 48
OWNERS Nos. -	T92 - T96

TANK WAGON

TRO36A

EXCESS LENGTH	H	M	L	E
tonnes	24	24	10	10
VB				
AB				
RA	1	1	1	1
MAX. SPEED	45	45	45	45

TOPS CODE												
CARKND				AARKND				OPERATING PANEL No.				
T	R	Ø	T	R	Ø	A	7	6	4			

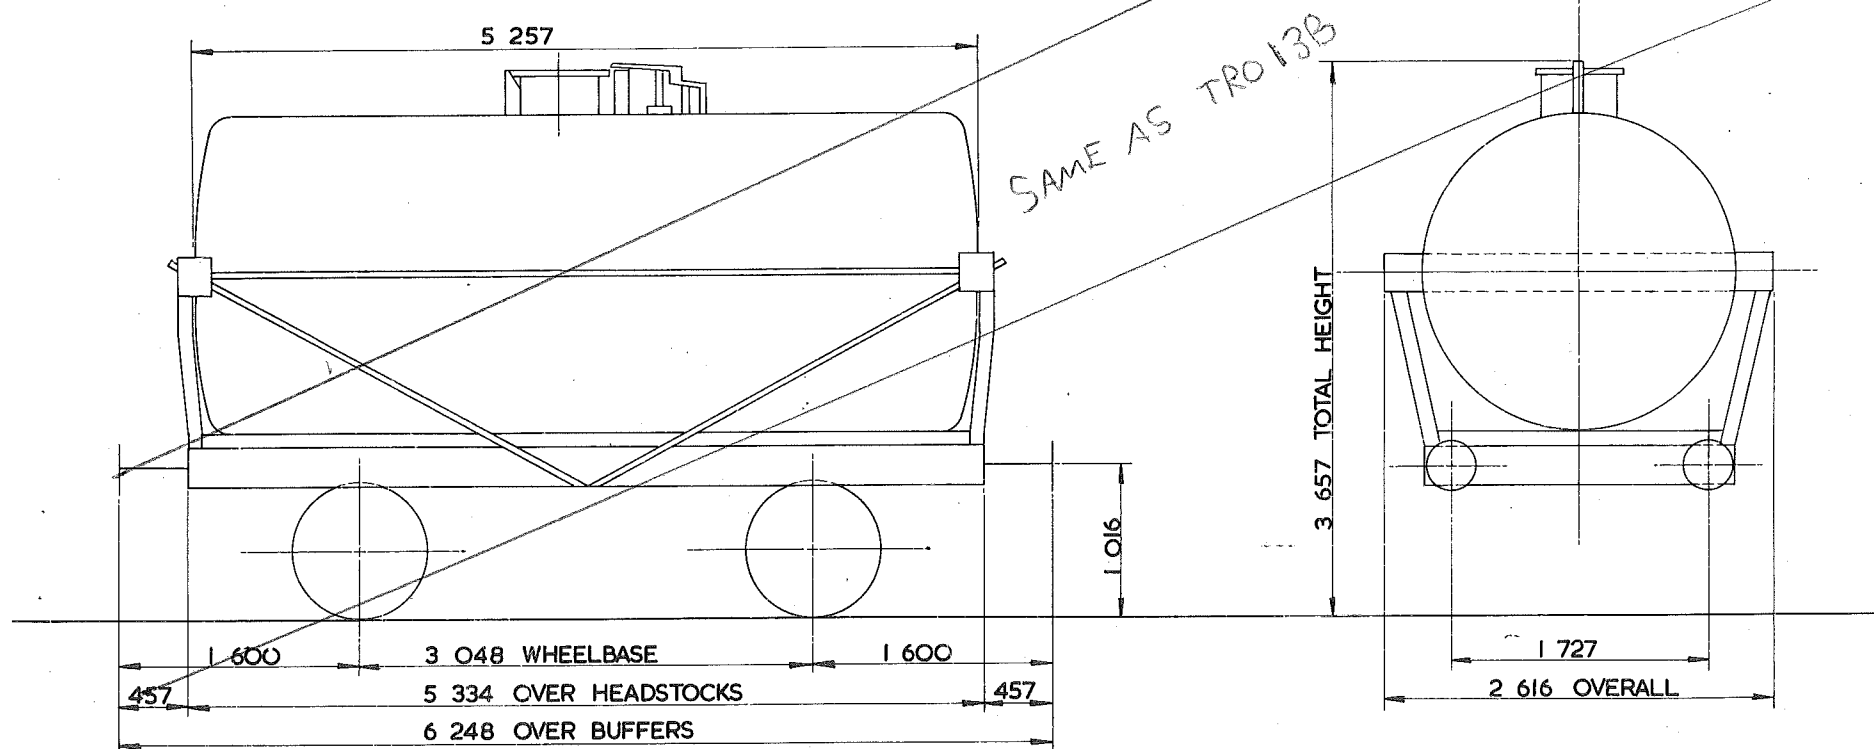

TARE -	10000 kg
CARRYING CAPACITY -	14000 kg
CAPACITY -	19400 litres
MAX. SPEED -	45 mile/h
WHEELS -	914 DIA
JOURNALS -	228 x 114 PLAIN BEARINGS

BUFFERS -	SPINDLE 330 DIA HEADS
COUPLINGS -	INSTANTER
MIN. CURVE -	21 m
GEN. ARRGT. DRG. No. -	
BRAKE -	HAND LEVER
SUSPENSION -	SHOE



BUILDER -	CHARLES ROBERTS
OWNER -	B.P BAGLAN BAY
REGISTERED BY -	C.M. & E.E. (B.R.B.) DERBY
YEAR BUILT -	1940
REGISTRATION Nos. -	47323
OWNERS Nos. -	BB2

TANK WAGON

T\$00IB

EXCESS LENGTH	H	M	L	E
tonnes.	30	30	11	11
— VB				
— AB				
RA	2	2	1	1
MAX. SPEED	45	45	45	45

TOPS CODE									
CARKND		AARKND		OPERATING PANEL No					
T	\$	Ø	T	\$	Ø	E	7	8	5

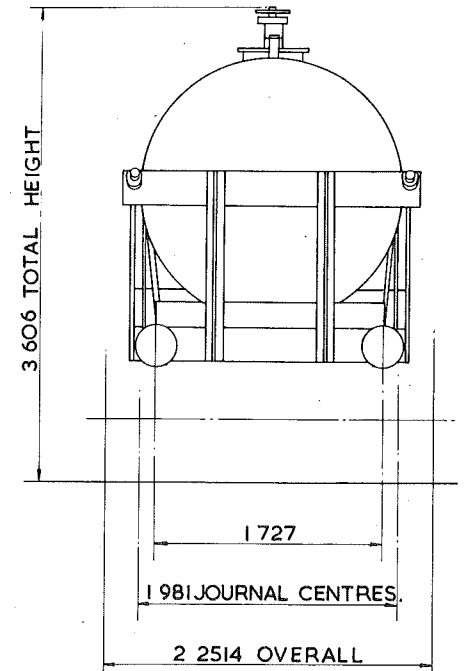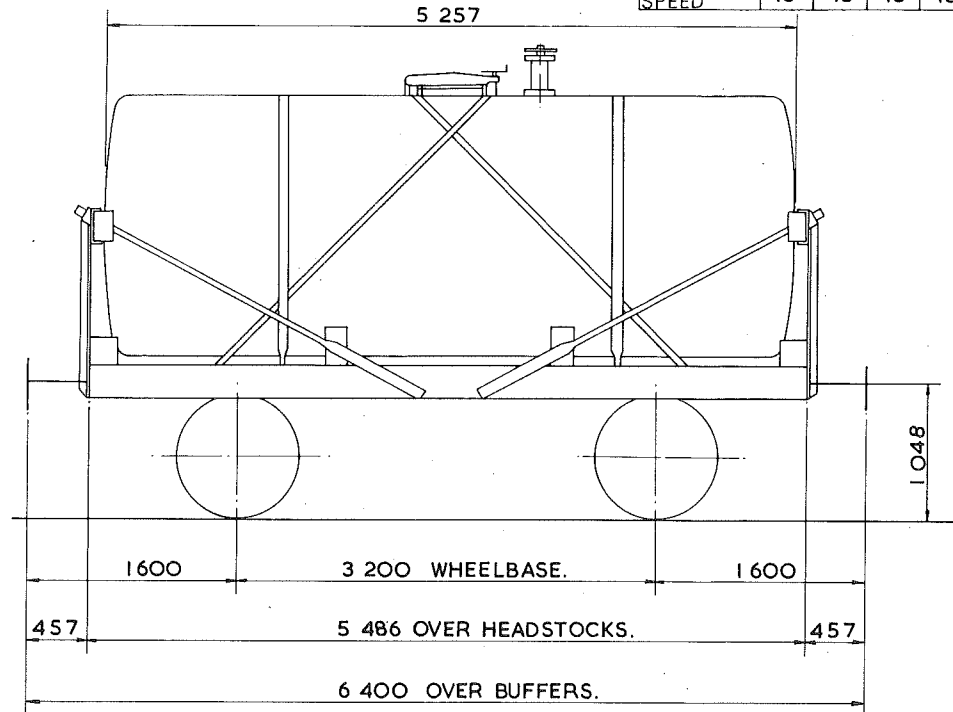

TARE—	10 600kg.
CARRYING CAPACITY—	20 500kg.
CAPACITY—	14 547 litres.
MAX. SPEED—	45 mile/h.
WHEELS—	952 DIA.
JOURNALS—	254x127 PLAIN BEARINGS

BUFFERS—	SPINDLE 330 DIA. HEADS
COUPLINGS—	INSTANTER.
MIN. CURVE—	21m.
GEN. ARRGT. DRG. No.—	
BRAKE—	HAND LEVER.
SUSPENSION—	SHOE.


BUILDER—	STABLEFORD.
OWNER—	UNITED MOLASSES.
REGISTERED BY—	C.M.&E.E. (B.R.B) DERBY
YEAR BUILT—	1927.
REGISTRATION Nos.—	48078.
OWNERS Nos.—	22.

TANK WAGON

T\$004A

EXCESS LENGTH	2	H	M	L	E
tonnes	30	30	11	11	
VB					
AB					
RA	2	2	1	1	
MAX. SPEED	45	45	45	45	

TOPS CODE		
CARKND	AARKND	OPERATING PART No.
T \$ Ø	T \$ Ø E	7 B 5

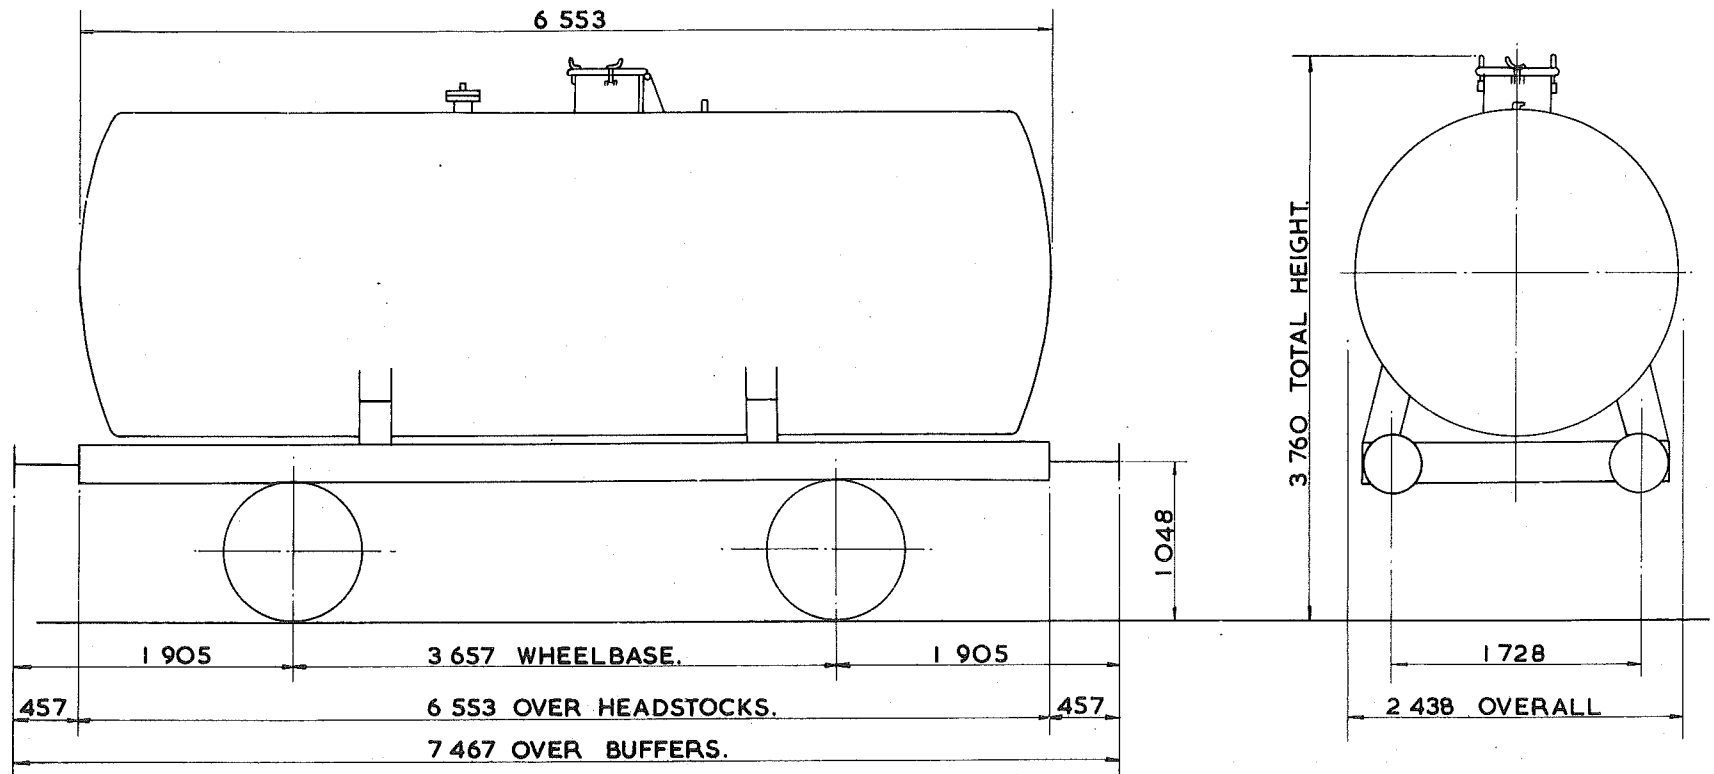

TARE--	11300kg.
CARRYING CAPACITY--	20500kg.
CAPACITY--	31m
MAX. SPEED--	45 mile/h.
WHEELS--	952 DIA.
JOURNALS--	254x127 PLAIN BEARINGS.

BUFFERS--	SPINDLE 330 DIA. HEADS.
COUPLINGS--	INSTANTER.
MIN. CURVE--	21m
GEN. ARRGT. DRG. No.--	
BRAKE--	HAND LEVER.
SUSPENSION--	SHOE.


BUILDER--	CHARLES ROBERTS.
OWNER--	BRITISH NUCLEAR FUELS LTD.
REGISTERED BY--	C.M.&E.E. (B.R.B.) DERBY.
YEAR BUILT--	1951
REGISTRATION Nos.--	48058 TO 48065.
OWNERS Nos.--	B 23 TO B 30.

TANK WAGON

T\$009A

EXCESS LENGTH - 2	H	M	L	E
tonnes	32	32	16	16
VB	0	0	0	0
AB	16	16	8	8
RA	3	3	1	1
MAX SPEED	50	50	50	50

TOPS CODE					
CARKND	AARKND			OPERATING PANEL No.	
T	\$	B	T	\$	B
					9 8 4

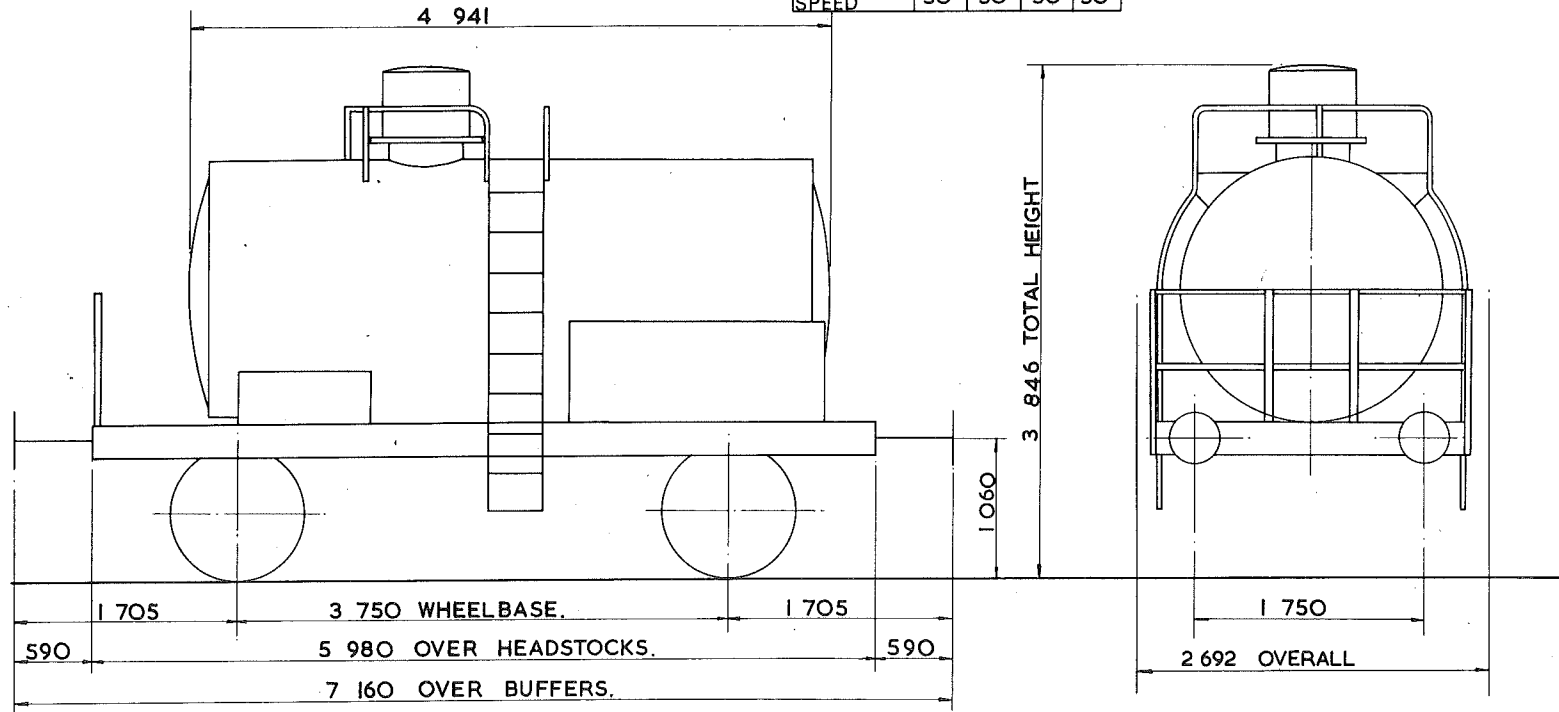


TARE - 15 ²⁵⁰ kg.
CARRYING CAPACITY - 17 ⁵⁰⁰ kg.
CAPACITY - 10 ⁵⁰⁰ litres
MAX. SPEED - 50 mile/h.
WHEELS - 1 050 DIA.
JOURNALS - 250 x 130 PLAIN BEARINGS

BUFFERS - SELF CONTAINED 400 DIA. HEADS.
COUPLINGS - INTERNATIONAL SCREW.
MIN. CURVE - 26 m.
GEN. ARRGT. DRG. No. -
BRAKE - AIR BLOCK, VACUUM PIPED & HAND SCREW
SUSPENSION - SHORT LINK.

BUILDER - FAUVET - GIREL.
OWNER - ASSOCIATED OCTEL.
REGISTERED BY - C.M. & E.E. (B.R.B.) DERBY.
YEAR BUILT - 1949.
REGISTRATION Nos. - 47070 - 47077.
OWNERS Nos. - C 413 - C 424 (RANGE).

TANK WAGON

T\$009B

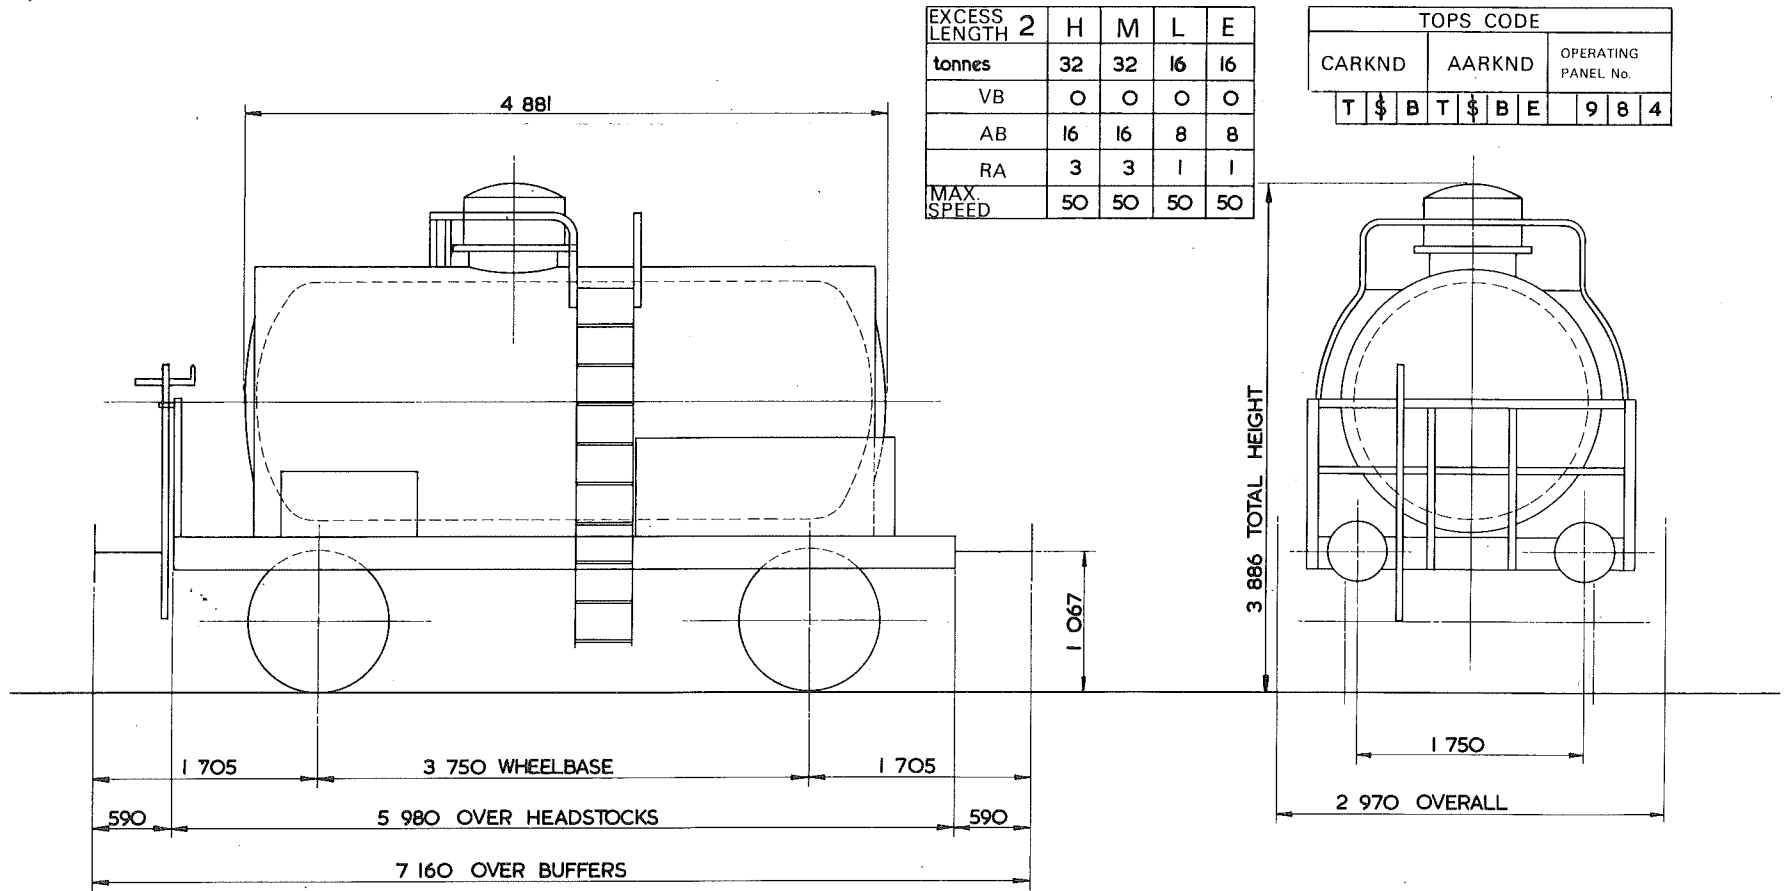

TARE - 15 ²⁵⁰ kg
CARRYING CAPACITY - 17000 kg
CAPACITY - 10500 litres
MAX. SPEED - 50 mile/h
WHEELS - 1 050 DIA
JOURNALS - 250 x 130 PLAIN BEARINGS

BUFFERS - SELF CONTAINED 457 DIA HEADS
COUPLINGS - INTERNATIONAL SCREW
MIN. CURVE - 26 m
GEN. ARRGT. DRG. No. - 64515 (S.F.V.) 6090
BRAKE - AIR, BLOCK VACUUM PIPED & HAND SCREW
SUSPENSION - SINGLE LINK


BUILDER - FAUVET - GIREL
OWNER - ASSOCIATED OCTEL COMPANY LTD
REGISTERED BY - C.M. & E.E. (B.R.B.) DERBY
YEAR BUILT - 1950
REGISTRATION Nos. - 47080
OWNERS Nos. - 260-6

TANK WAGON

T\$013A

EXCESS LENGTH -3	H	M	L	E
tonnes	32	32	12	12
VB	16	16	7	7
AB				
RA	3	3	1	1
MAX. SPEED	60	60	60	60

TOPS CODE										
CARKND		AARKND		OPERATING PANEL No.						
T	\$	V	T	\$	V	E		8	3	3

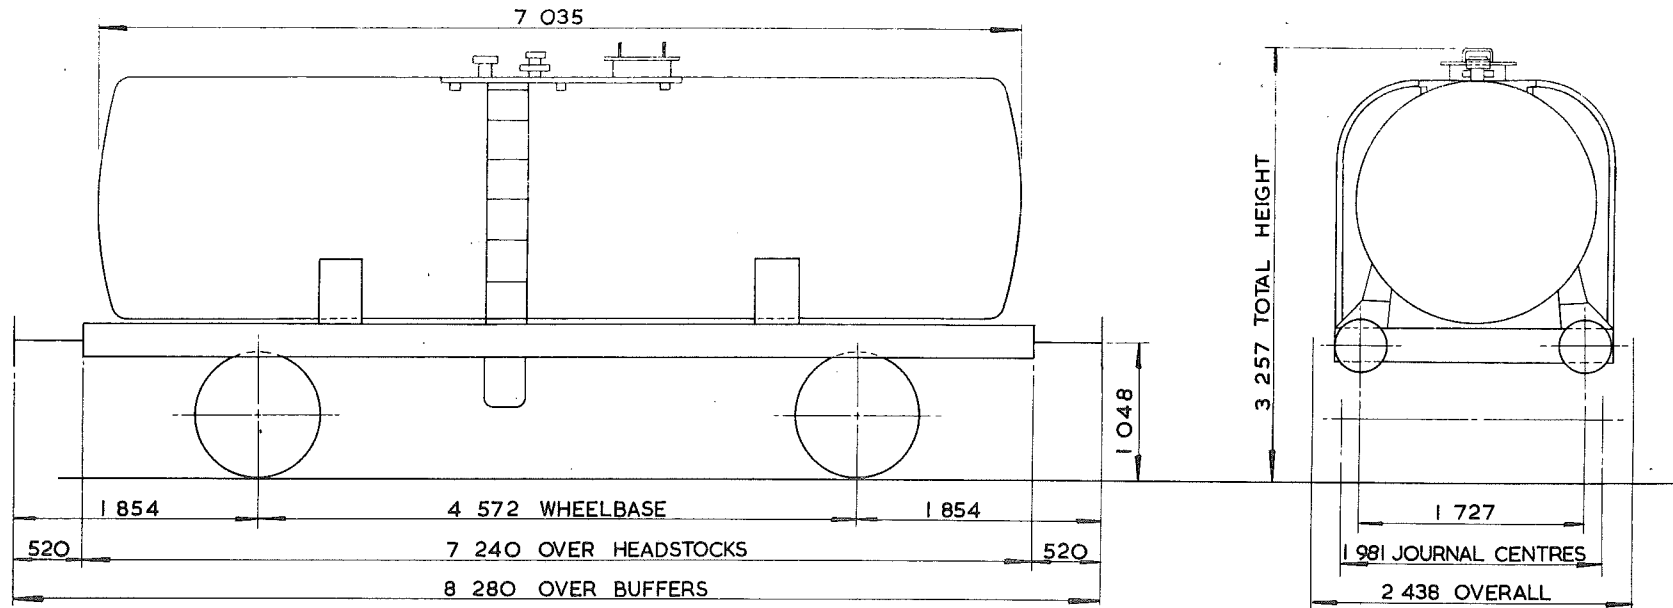

TARE - 12150 kg
CARRYING CAPACITY - 22500 kg
CAPACITY -
MAX. SPEED - 60 mile/h
WHEELS - 952 DIA.
JOURNALS - 124 DIA. ROLLER BEARINGS

BUFFERS - PNEUMATIC 406 DIA. HEADS
COUPLINGS - SCREW
MIN. CURVE - 31m
GEN. ARRGT. DRG. No. -
BRAKE - VACUUM BLOCK, HAND LEVER
SUSPENSION - SHOE

BUILDER - GRAZEBROOK (DUDLEY)
OWNER - BRITISH NUCLEAR FUELS LTD.
REGISTERED BY - C.M. & E.E. (B.R.B.) DERBY
YEAR BUILT - 1959
REGISTRATION Nos. - 48066 TO 48073
OWNERS Nos. - 4306 'B' 0036 TO 4306 'B' 0043


EX. P.O. DIAGRAM 6/777 (ALLOCATED)

TANK WAGON - CLASS. A.

T\$016A

EXCESS LENGTH	2	H	M	L	E
tonnes	32	32	12	12	
VB	0	0	0	0	
AB	0	0	0	0	
RA	4	4	1	1	
MAX SPEED	50	50	50	50	

TOPS CODE										
CARKND			AARKND			OPERATING PANEL No.				
T	\$	R	T	\$	R	E	I	I	4	6

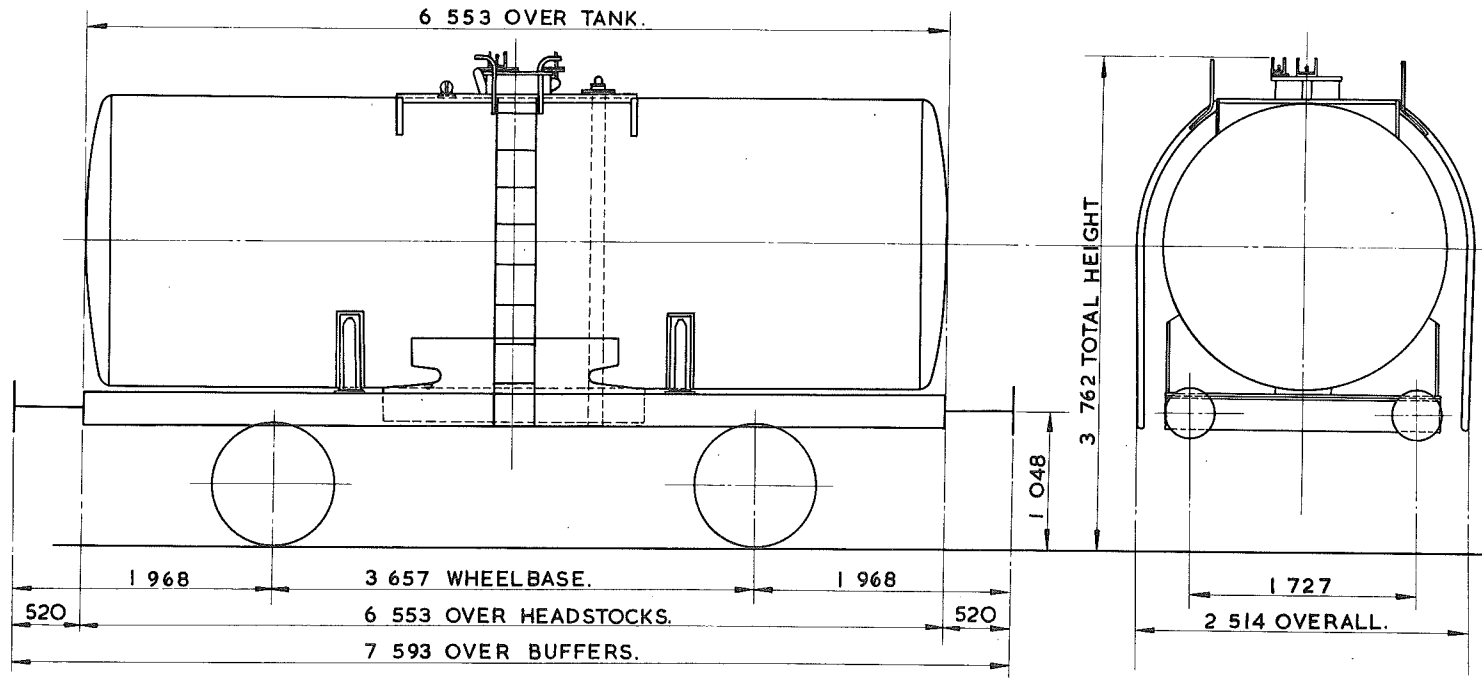

TARE-	11 850 kg
CARRYING CAPACITY-	20 500 kg
CAPACITY-	22 880 litres
MAX. SPEED-	50 mile/h
WHEELS-	9 52 DIA.
JOURNALS-	254 x 127 PLAIN BEARINGS.

BUFFERS-	SPINDLE 381 DIA. HEADS
COUPLINGS-	B.R. SCREW.
MIN. CURVE-	26 m.
GEN. ARRGT. DRG. No.-	
BRAKE-	DUAL PIPED & HAND LEVER
SUSPENSION-	SHOE.

BUILDER-	HURST NELSON.
OWNER-	KILFROST LTD.
REGISTERED BY-	C.M. & E.E. (B.R.B) DERBY
YEAR BUILT-	1970
REGISTRATION Nos.-	48128.
OWNERS Nos.-	1.



EX. PO. DIAGRAM 6/35.

TANK WAGON.

T\$017A

EXCESS LENGTH	H	M	L	E
tonnes.	32	32	12	12
— VB				
— AB				
RA	3	3	1	1
MAX. SPEED	45	45	45	45

TOPS CODE									
CARKND		AARKND		OPERATING PANEL No.					
T	\$	Ø	T	\$	Ø	E	7	7	2

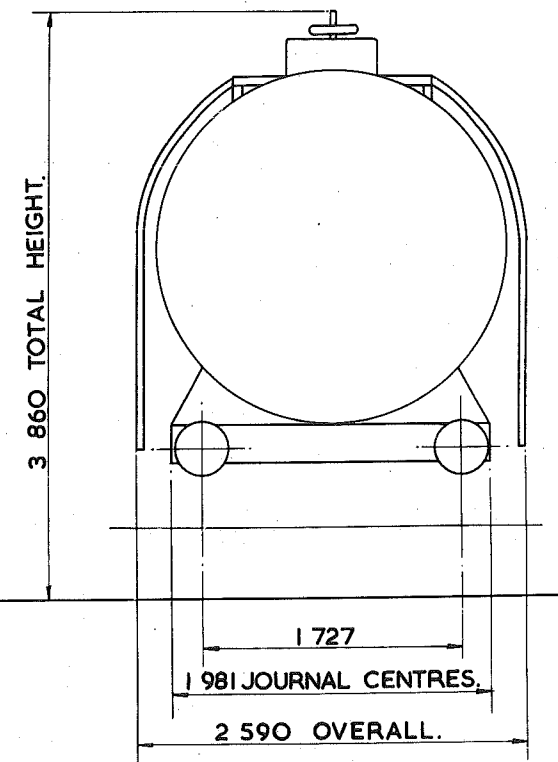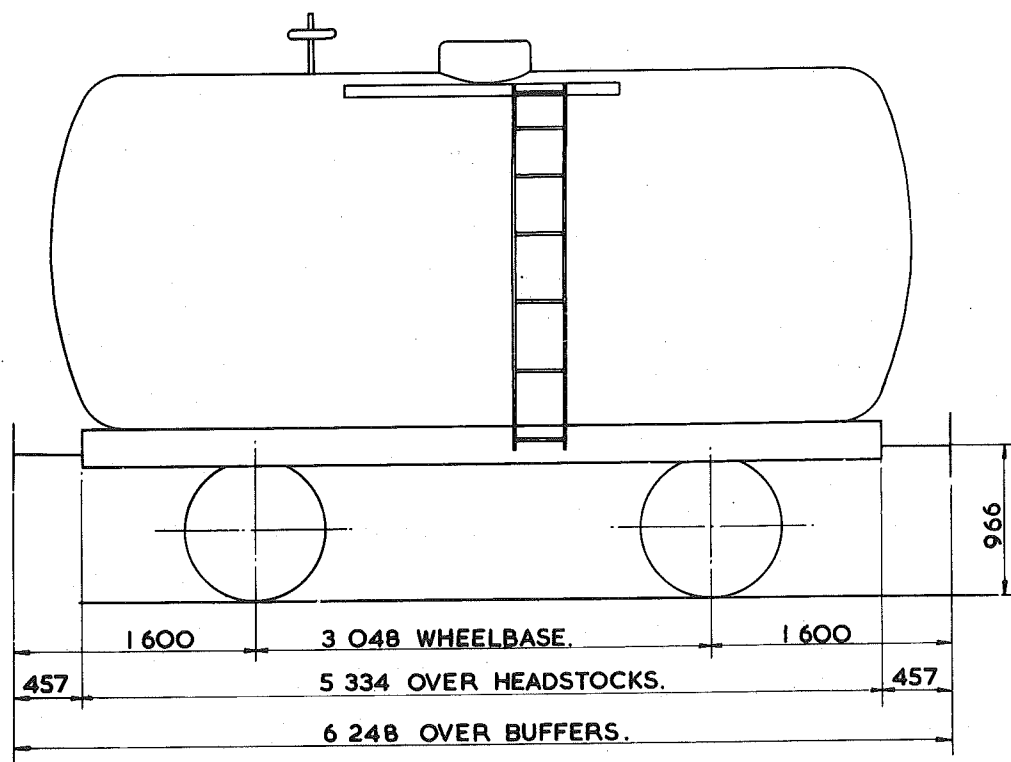

TARE - 11 ³⁰⁰ kg.
CARRYING CAPACITY - 20 ⁵⁰⁰ kg.
CAPACITY - 19548 litres.
MAX. SPEED - 45 mile/h.
WHEELS - 952 DIA.
JOURNALS - 254 x 140 PLAIN BEARINGS

BUFFERS - SPINDLE 356 DIA. HEADS.
COUPLINGS - INSTANTER
MIN. CURVE - 21m.
GEN. ARRGT. DRG. No. -
BRAKE - HAND LEVER.
SUSPENSION - SHOE.



BUILDER - CAMBRIAN WAGON WORKS CARDIFF.
OWNER - LION EMULSIONS.
REGISTERED BY - C.M. & E.E. (B.R.B.) DERBY.
YEAR BUILT - 1948
REGISTRATION Nos. - 47724
OWNERS Nos. - 6119.

TANK WAGON.

T\$017B

EXCESS LENGTH	H	M	L	E
tonnes.	32	32	12	12
— VB				
— AB				
RA	3	3	1	1
MAX. SPEED	45	45	45	45

TOPS CODE			
CARKND	AARKND	OPERATING PANEL No.	
T	\$	0	0
E	7	7	2

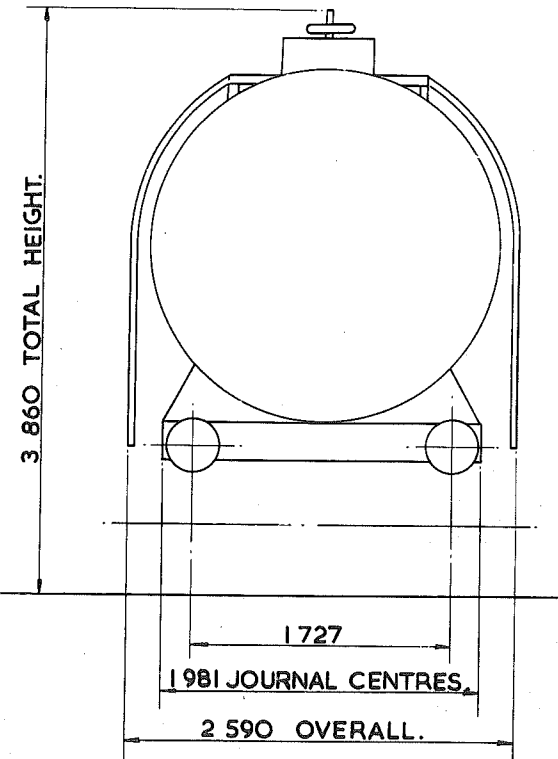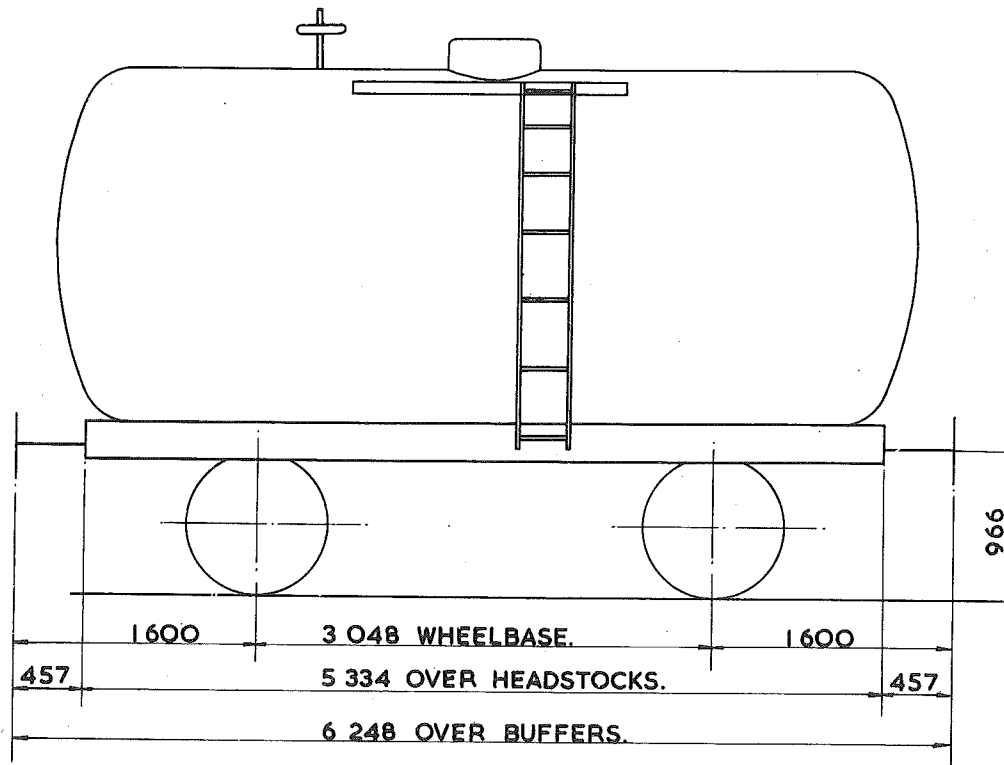



TARE —	11300kg
CARRYING CAPACITY —	20500kg.
CAPACITY —	19548 litres.
MAX. SPEED —	45mie/h.
WHEELS —	952 DIA.
JOURNALS —	251x40 PLAIN BEARINGS

BUFFERS —	SPINDLE 356 DIA. HEADS.
COUPLINGS —	INSTANTER
MIN. CURVE —	21m.
GEN. ARRGT. DRG. No. —	
BRAKE —	HAND LEVER.
SUSPENSION —	SHOE.

BUILDER —	FAIRFIELD S & E. CO.LTD.
OWNER —	LION EMULSION.
REGISTERED BY —	C.M.&E.E (B.R.B.) DERBY.
YEAR BUILT —	1948
REGISTRATION Nos. —	47723, 47726.
OWNERS Nos. —	5761, 6611

EXCESS LENGTH	H	M	L	E
tonnes.	32	32	12	12
— VB				
— AB				
RA	3	3	1	1
MAX. SPEED	45	45	45	45

TOPS CODE					
CARKND		AARKND		OPERATING PANEL No	
T	\$	Ø	T	\$	Ø
					7 7 2

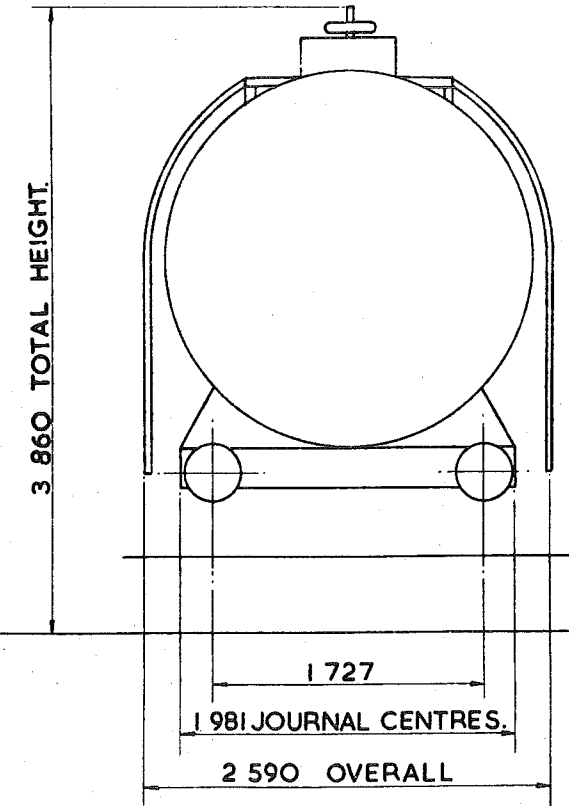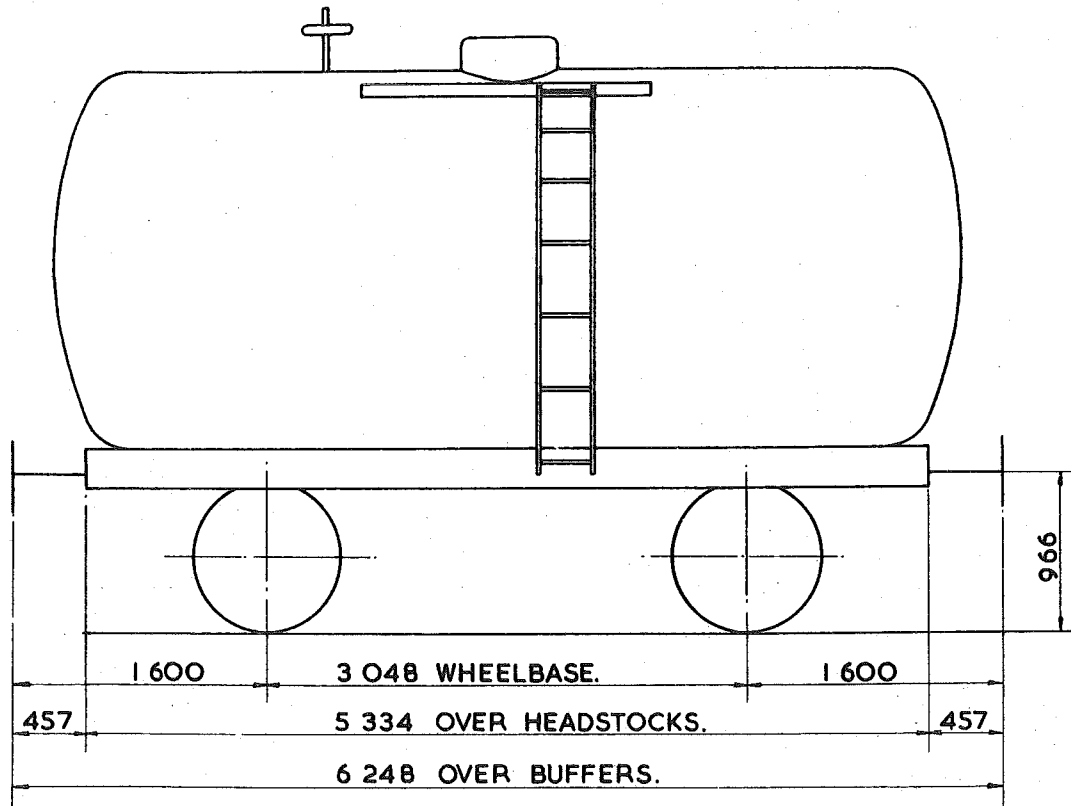

TARE —	11300kg.
CARRYING CAPACITY —	20 ⁵⁰⁰ kg.
CAPACITY —	19548 litres.
MAX. SPEED —	45 mile/h.
WHEELS —	952 DIA.
JOURNALS —	254x140 PLAIN BEARINGS

BUFFERS —	SPINDLE 356 DIA. HEADS.
COUPLINGS —	INSTANTER.
MIN. CURVE —	21m.
GEN. ARRGT. DRG. No. —	
BRAKE —	HAND LEVER.
SUSPENSION —	SHOE.



BUILDER —	CHARLES ROBERTS.
OWNER —	LION EMULSIONS.
REGISTERED BY —	C.M.&E.E. (B.R.B.) DERBY.
YEAR BUILT —	1948.
REGISTRATION Nos. —	47725
OWNERS Nos. —	6419

TANK WAGON.

T\$017D

EXCESS LENGTH	H	M	L	E
tonnes.	32	32	12	12
— VB				
— AB				
RA	3	3	1	1
MAX. SPEED	45	45	45	45

TOPS CODE									
CARKND		AARKND		OPERATING PANEL No.					
T	\$	Ø	T	\$	Ø	E	7	7	2

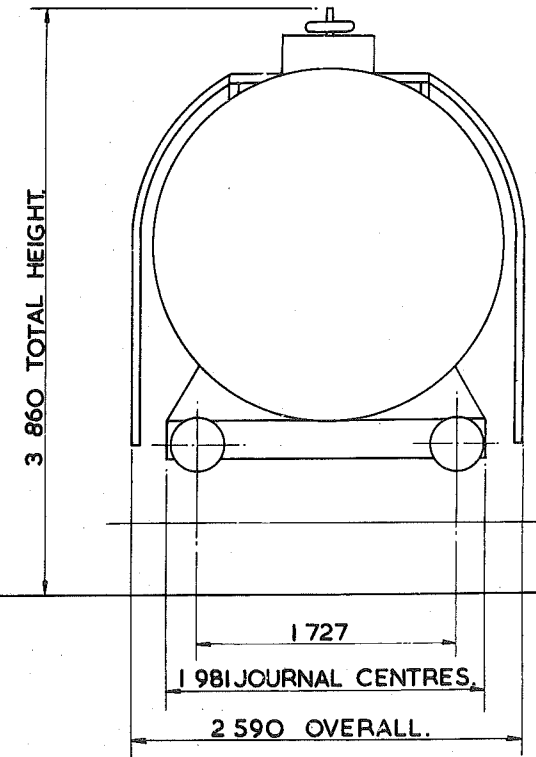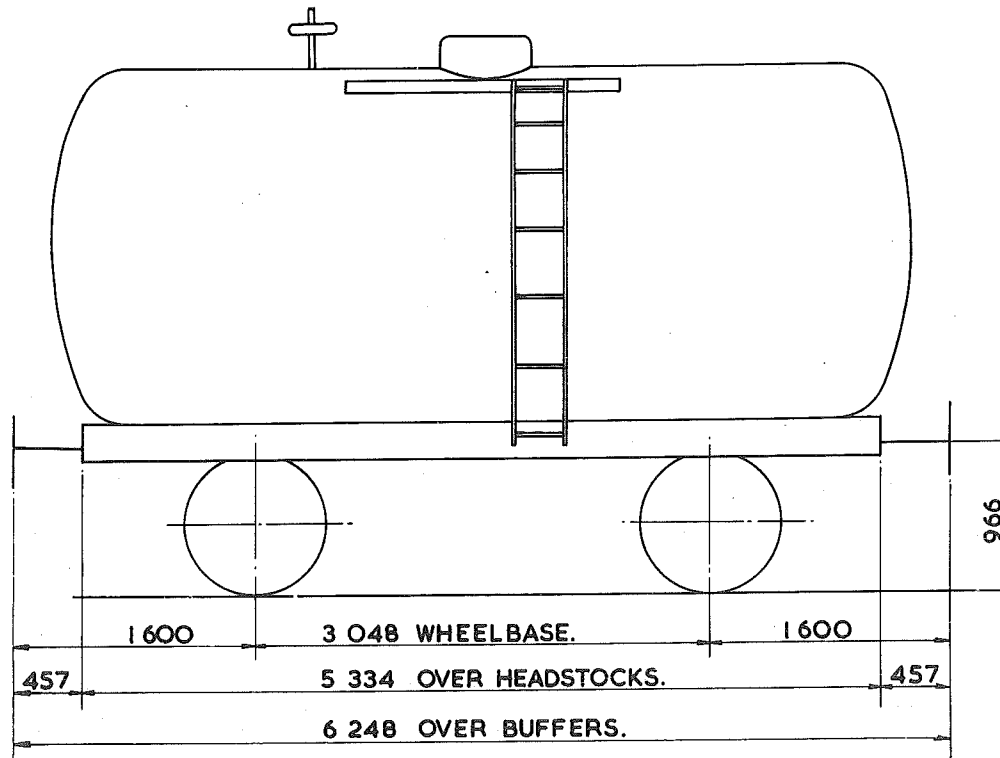

TARE—	11300kg.
CARRYING CAPACITY—	20 ⁵⁰⁰ kg.
CAPACITY—	1954litres.
MAX. SPEED—	45mile/h.
WHEELS—	952 DIA.
JOURNALS—	254x140 PLAIN BEARINGS

BUFFERS—	SPINDLE 356 DIA. HEADS.
COUPLINGS—	INSTANTER.
MIN. CURVE—	21m.
GEN. ARRGT. DRG. No.—	
BRAKE—	HAND LEVER.
SUSPENSION—	SHOE.


BUILDER—	GRAZEBROOK LTD.
OWNER—	LION EMULSION.
REGISTERED BY—	C.M.&E.E. (B.R.B) DERBY.
YEAR BUILT—	1948
REGISTRATION Nos.—	47727
OWNERS Nos.—	6938

TANK WAGON - CLASS A

T\$O20A.

EXCESS LENGTH	4	H	M	L	E
tonnes.	33	33	13	13	
VB	0	0	0	0	
AB	0	0	0	0	
RA	4	4	1	1	
MAX. SPEED	50	50	50	50	

TOPS CODE	
CARKND	AARKND
T	\$ R T \$ R E I I 4 7

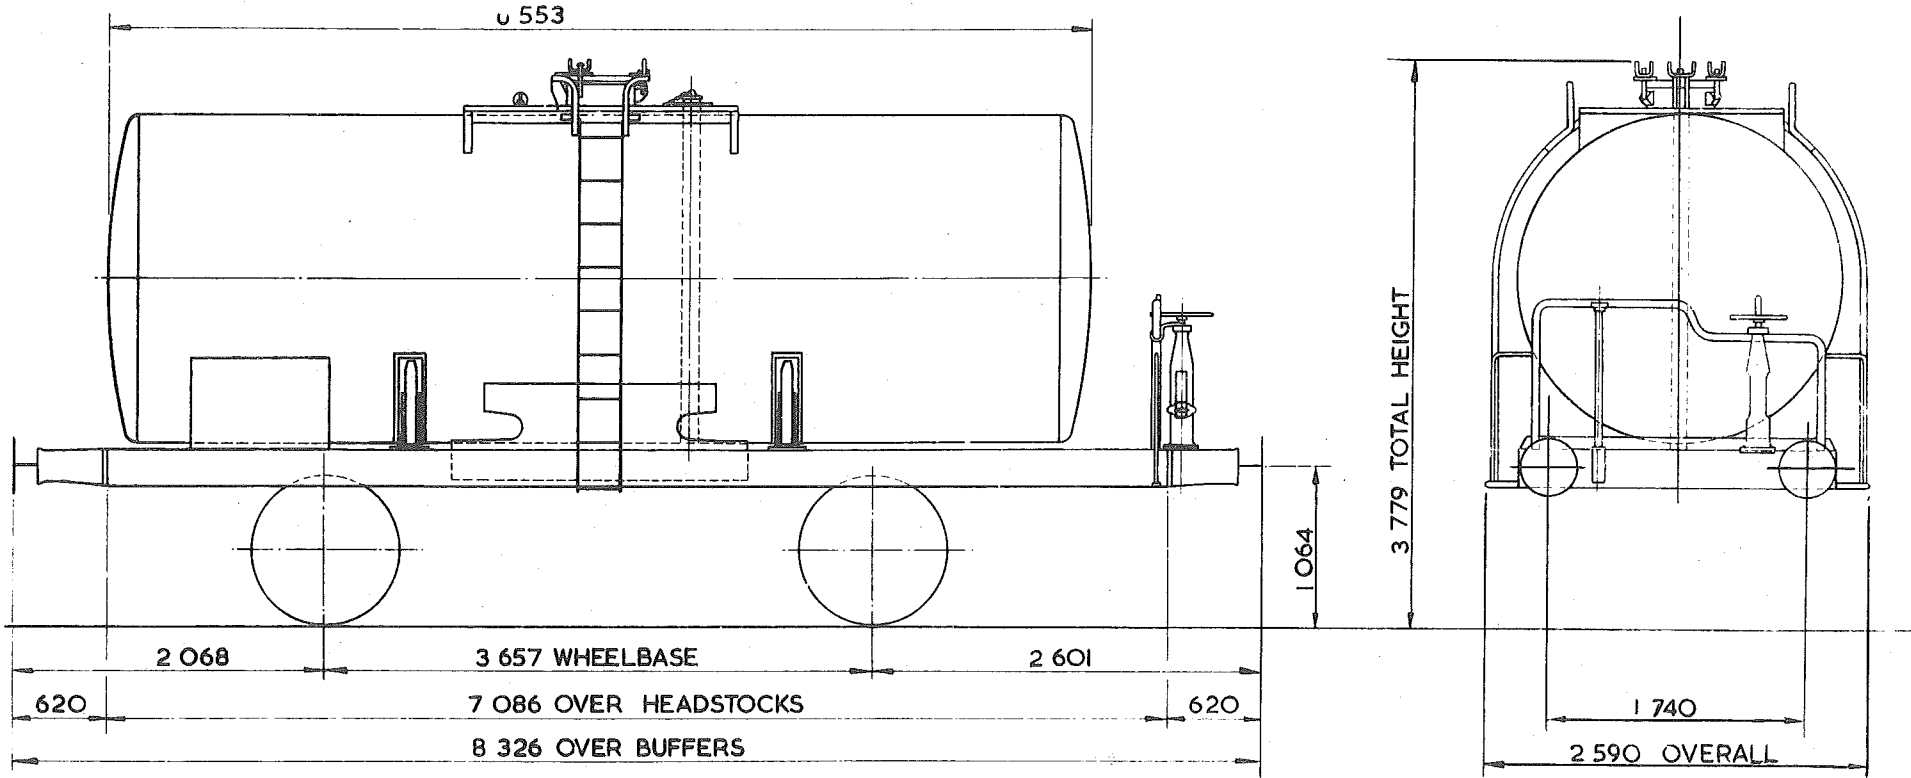

TARE	12300kg.
CARRYING CAPACITY	20500kg.
CAPACITY	22880 litres.
MAX. SPEED	50mile/h.
WHEELS	1000 DIA.
JOURNALS	254 X 127 PLAIN BEARINGS

BUFFERS	SELF CONTAINED 400 DIA. HEADS.
COUPLINGS	INTERNATIONAL SCREW
MIN. CURVE	26m.
GEN. ARRGT. DRG. No.	-
BRAKE	DUAL PIPED & HAND SCREW.
SUSPENSION	SHOE

BY	ASHFORD
OF	KILFROST LTD.
REVISION	By C.M.&E.E.(B.R.B)DERBY
YEAR BUILT	1970
REGISTRATION	48129
OWNERS	2


EX PO DIAGRAM 6/36

TANK WAGON.

T\$020B

EXCESS LENGTH	3	H	M	L	E
tonnes	33	28	13	13	
VB	0	0	0	0	
AB	0	0	0	0	
RA	3	2	1	1	
MAX. SPEED	45	45	45	45	

TOPS CODE					
CARKND	AARKND		OPERATING PANEL No.		
T	\$	R	T	\$	R
E	I	O	I	7	

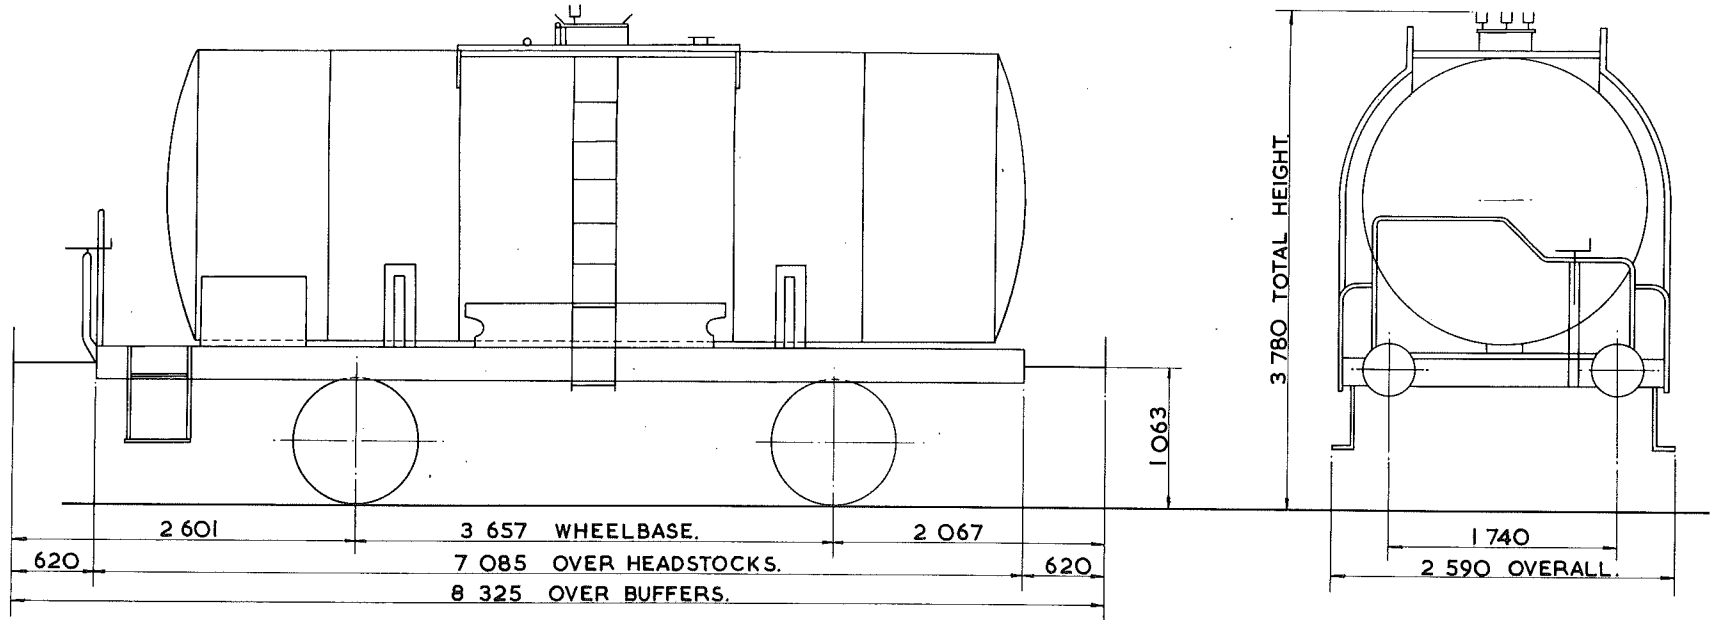

TARE - 12350kg.
CARRYING CAPACITY - 20000kg.
CAPACITY - 23250 litres.
MAX. SPEED - 45 mile/h.
WHEELS - 952 DIA.
JOURNALS - 254 x 127 PLAIN BEARINGS.

BUFFERS - 406 DIA. HEADS.
COUPLINGS - INTERNATIONAL SCREW.
MIN. CURVE - 26m.
GEN. ARRGT. DRG. No. -
BRAKE - DUAL PIPED & HAND SCREW.
SUSPENSION - SHOE.

BUILDER - GRAZEBROOK.
OWNER - SHELL CHEMICALS U.K. LTD.
REGISTERED BY - C.M. & E.E. (B.R.B) DERBY.
YEAR BUILT - 1953.
REGISTRATION Nos. - 48384 TO 48387.
OWNERS Nos. - 21-70-078-0001-4-21-70-078-0002-2 21-70-078-0005-5-21-70-078-0021-4


EX. PO. DIAGRAM 6/708 (ALLOCATED)

TANK WAGON

T\$0 21A

EXCESS LENGTH	3	H	M	L	E
tonnes	33	33	13	13	
VB	15	15	7	7	
AB					
RA	4	4	1	1	
MAX. SPEED	50	50	50	50	

TOPS CODE									
CARKND			AARKND			OPERATING PANEL No.			
T	\$	V	T	\$	V	E	9	6	7

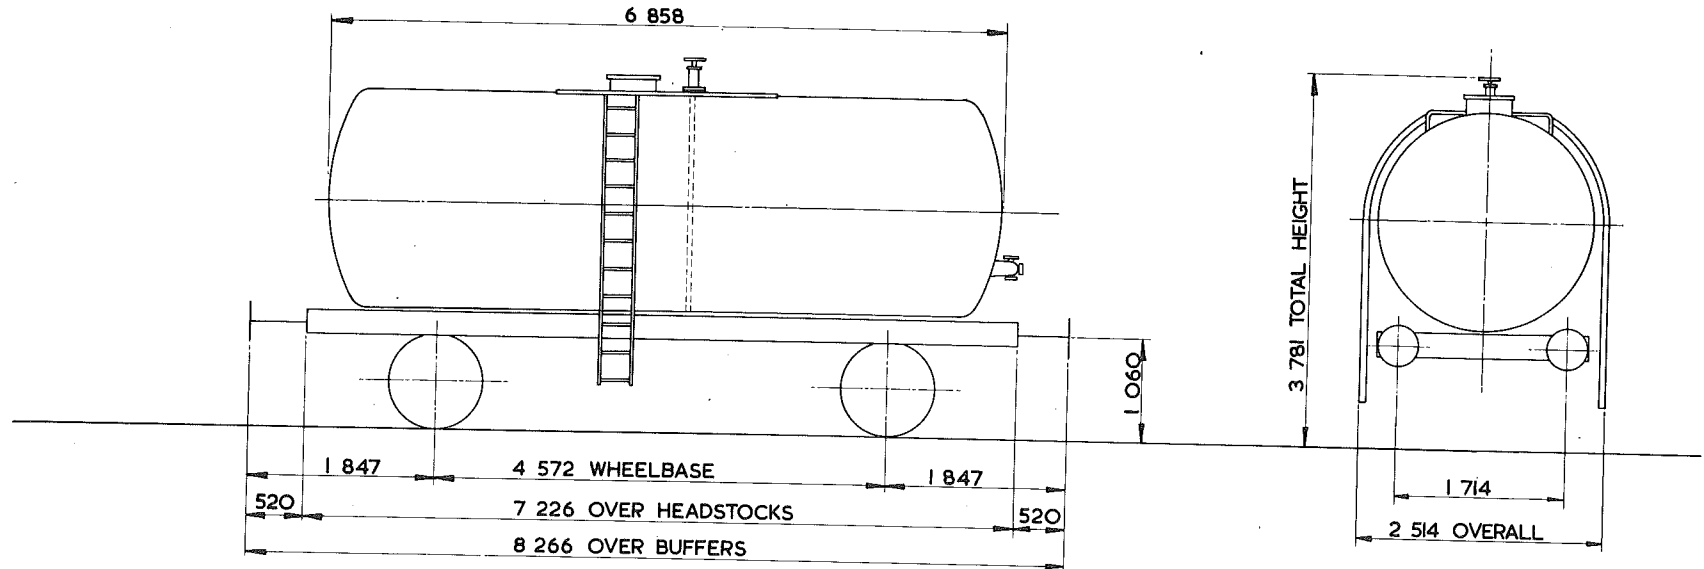

TARE - 13 ⁵⁰ kg
CARRYING CAPACITY - 22 ⁵⁰⁰ kg
CAPACITY - 24 048 litres.
MAX. SPEED - 50 mile/h
WHEELS - 952 DIA
JOURNALS - 124 DIA ROLLER BEARINGS

BUFFERS - HYDRAULIC 406 DIA HEADS
COUPLINGS - INSTANTER
MIN. CURVE - 31 m
GEN. ARRGT. DRG. No. -
BRAKE - VACUUM BLOCK & HAND LEVER.
SUSPENSION - EYEBOLT


BUILDER - CHARLES ROBERTS
OWNER - TEXACO
REGISTERED BY - C.M. & E.E.(B.R.B.) DERBY
YEAR BUILT - 1960
REGISTRATION Nos. - 47766 TO 47851 (RANGE)
OWNERS Nos. - 316 TO 401 (RANGE)

TANK WAGON

T\$O22A

EXCESS LENGTH	4	H	M	L	E
tonnes	33	33	13	13	
VB	15	15	7	7	
AB					
RA	4	4	1	1	
MAX. SPEED	50	50	50	50	

TOPS CODE									
CARKND		AARKND			OPERATING PANEL No.				
T	\$	V	T	\$	V	E	9	6	9

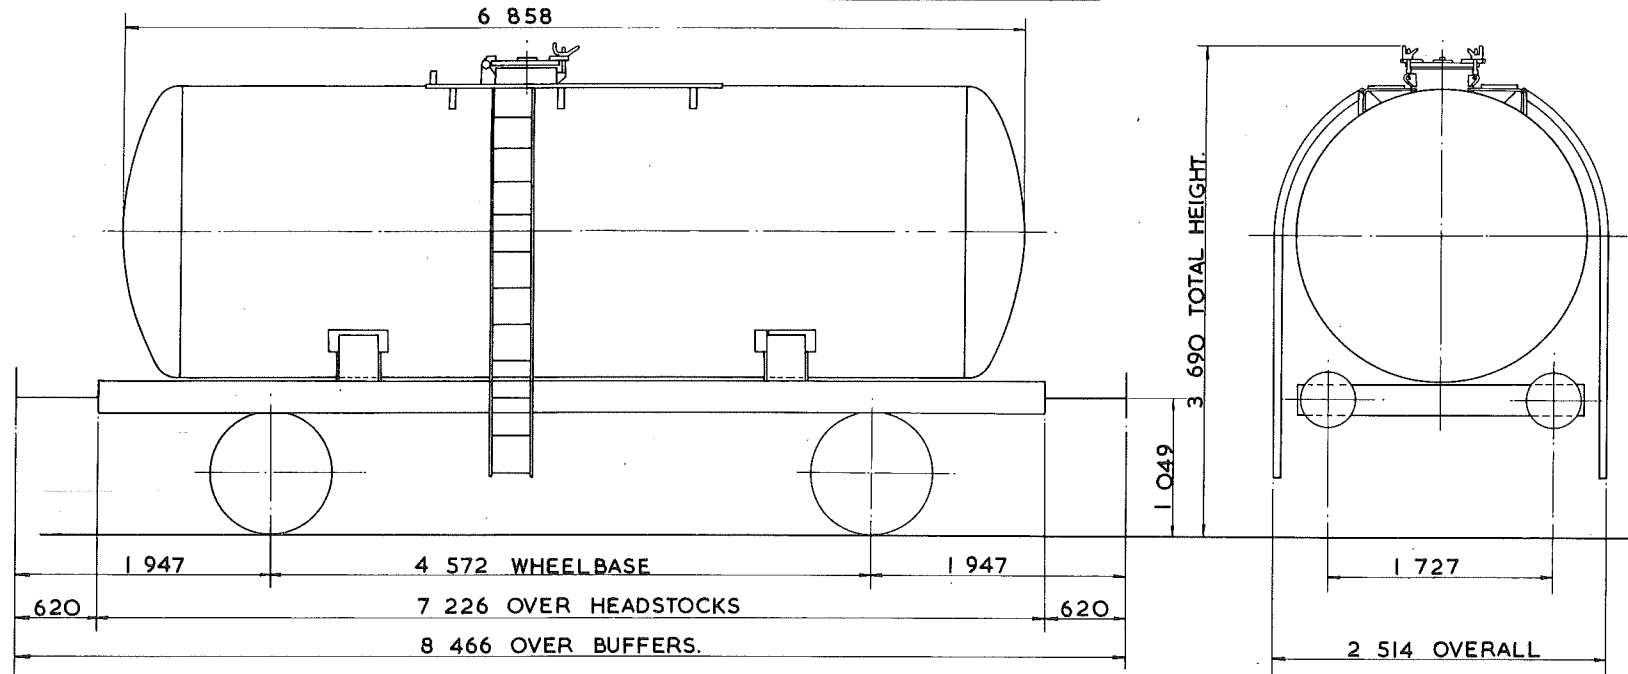

TARE - 12900kg 12,950kg
CARRYING CAPACITY - 20500kg 22,500kg
CAPACITY - 23 503 litres.
MAX. SPEED - 50 mile/h.
WHEELS - 939 DIA.
JOURNALS - 124 DIA. ROLLER BEARINGS.

BUFFERS - HYDRAULIC 406 DIA. HEADS.
COUPLINGS - B.R. SCREW.
MIN. CURVE - 31m.
GEN. ARRGT. DRG. No. -
BRAKE - VACUUM BLOCK & HAND LEVER.
SUSPENSION - SHOE EYEBOLT

BUILDER - POWELL DUFFRYN LTD.
OWNER - TEXACO.
REGISTERED BY - C.M. & E.E.(B.R.B.) DERBY.
YEAR BUILT - 1961.
REGISTRATION Nos. - 47858-47902 47813-47902 (RANGE)
OWNERS Nos. - 408-452 (RANGE)


EX. PO. DIAGRAM 6/20 (ALLOCATED)

TANK WAGON

T\$022B

EXCESS LENGTH	4	H	M	L	E
tonnes	34	34	13	13	
VB	15	15	7	7	
AB					
RA	4	4	1	1	
MAX. SPEED	50	50	50	50	

TOPS CODE									
CARKND		AARKND			OPERATING PANEL No.				
T	\$	V	T	\$	V	E	9	7	0

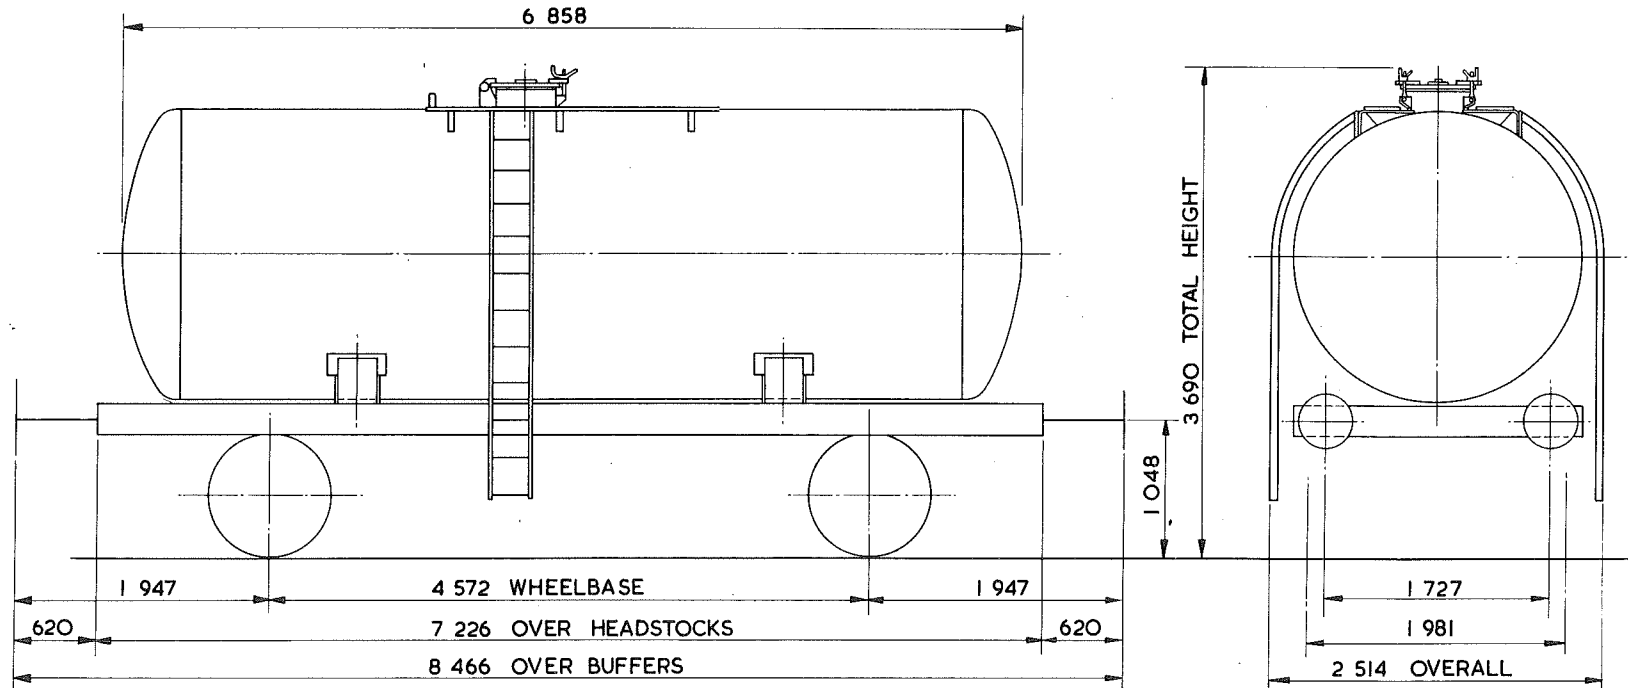

TARE -	12 900 kg 12,950 kg.
CARRYING CAPACITY -	21 500 kg 22,500 kg.
CAPACITY -	23 412 litres
MAX. SPEED -	50 mile/h
WHEELS -	939 DIA.
JOURNALS -	124 DIA. ROLLER BEARINGS

BUFFERS -	HYDRAULIC 406 DIA. HEADS.
COUPLINGS -	B.R. SCREW
MIN. CURVE -	31m
GEN. ARRGT. DRG. No. -	
BRAKE -	VACUUM BLOCK AND HAND LEVER
SUSPENSION -	SHOE EYEBOLT

BUILDER -	POWELL DUFFRYN LTD.
OWNER -	TEXACO
REGISTERED BY -	C.M.&E.E. (B.R.B.) DERBY
YEAR BUILT -	1960
REGISTRATION Nos. -	47853-47898 (RANGE)
OWNERS Nos. -	403-448 (RANGE)


EX. PO. DIAGRAM 6/19 (ALLOCATED)

TANK WAGON

T\$O25A

EXCESS LENGTH	3	H	M	L	E
tonnes	34	34	13	13	
VB	15	15	7	7	
AB					
RA	4	4	1	1	
MAX. SPEED	50	50	50	50	

TOPS CODE									
CARKND		AARKND			OPERATING PANEL No.				
T	\$	V	T	\$	V	E	9	6	8

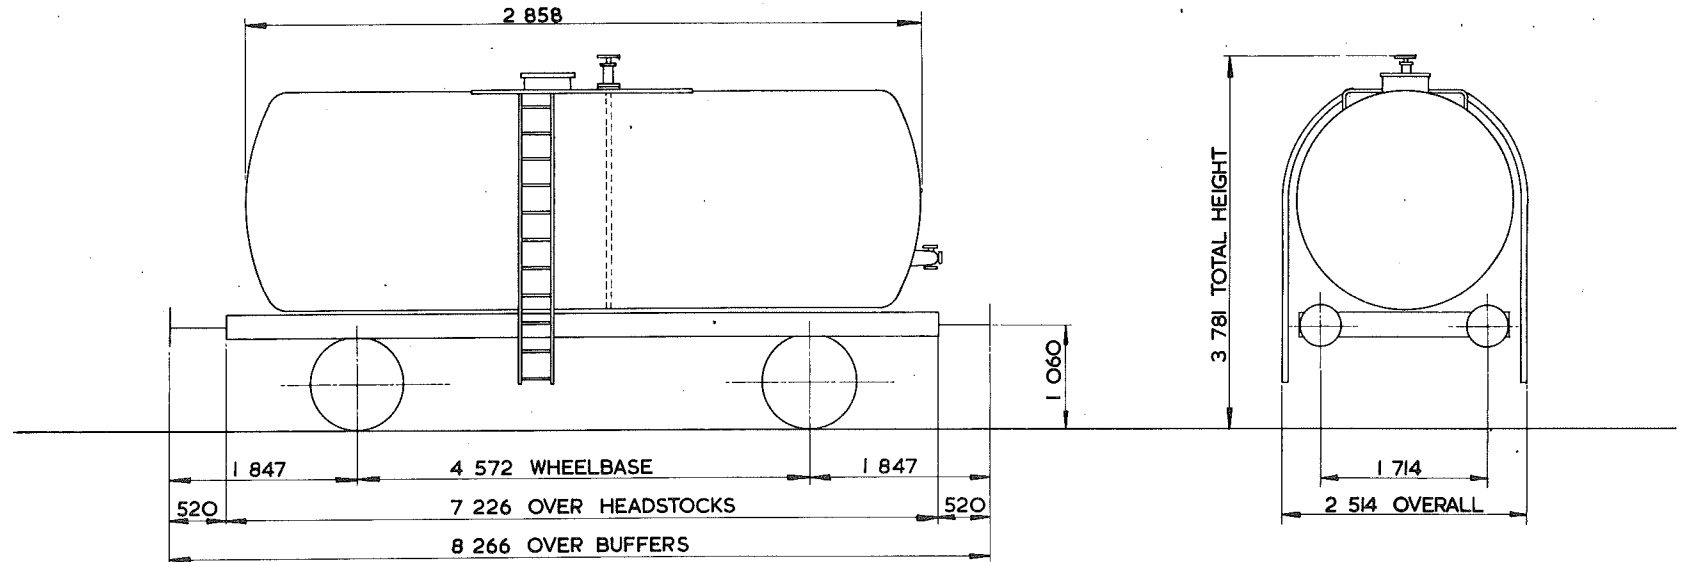

TARE - 13 ¹⁵⁰ kg
CARRYING CAPACITY - 22 ⁵⁰⁰ kg
CAPACITY - 24 ⁰⁴⁸ litres
MAX. SPEED - 50 mile/h
WHEELS - 952 DIA
JOURNALS - 124 DIA ROLLER BEARINGS


BUFFERS - HYDRAULIC 406 DIA HEADS
COUPLINGS - INSTANTER
MIN. CURVE - 31 m
GEN. ARRGT. DRG. No. -
BRAKE - VACUUM BLOCK HANDLEVER
SUSPENSION - EYEBOLT

BUILDER - CHARLES ROBERTS
OWNER - TEXACO
REGISTERED BY - CM. & EE.(B.R.B) DERBY
YEAR BUILT - 1960
REGISTRATION Nos. - 47761 TO 47845 (RANGE)
OWNERS Nos. - 311 TO 395 (RANGE)

EX. P.O. DIAGRAM 6/II (ALLOCATED)

TANK WAGON

T\$O26A

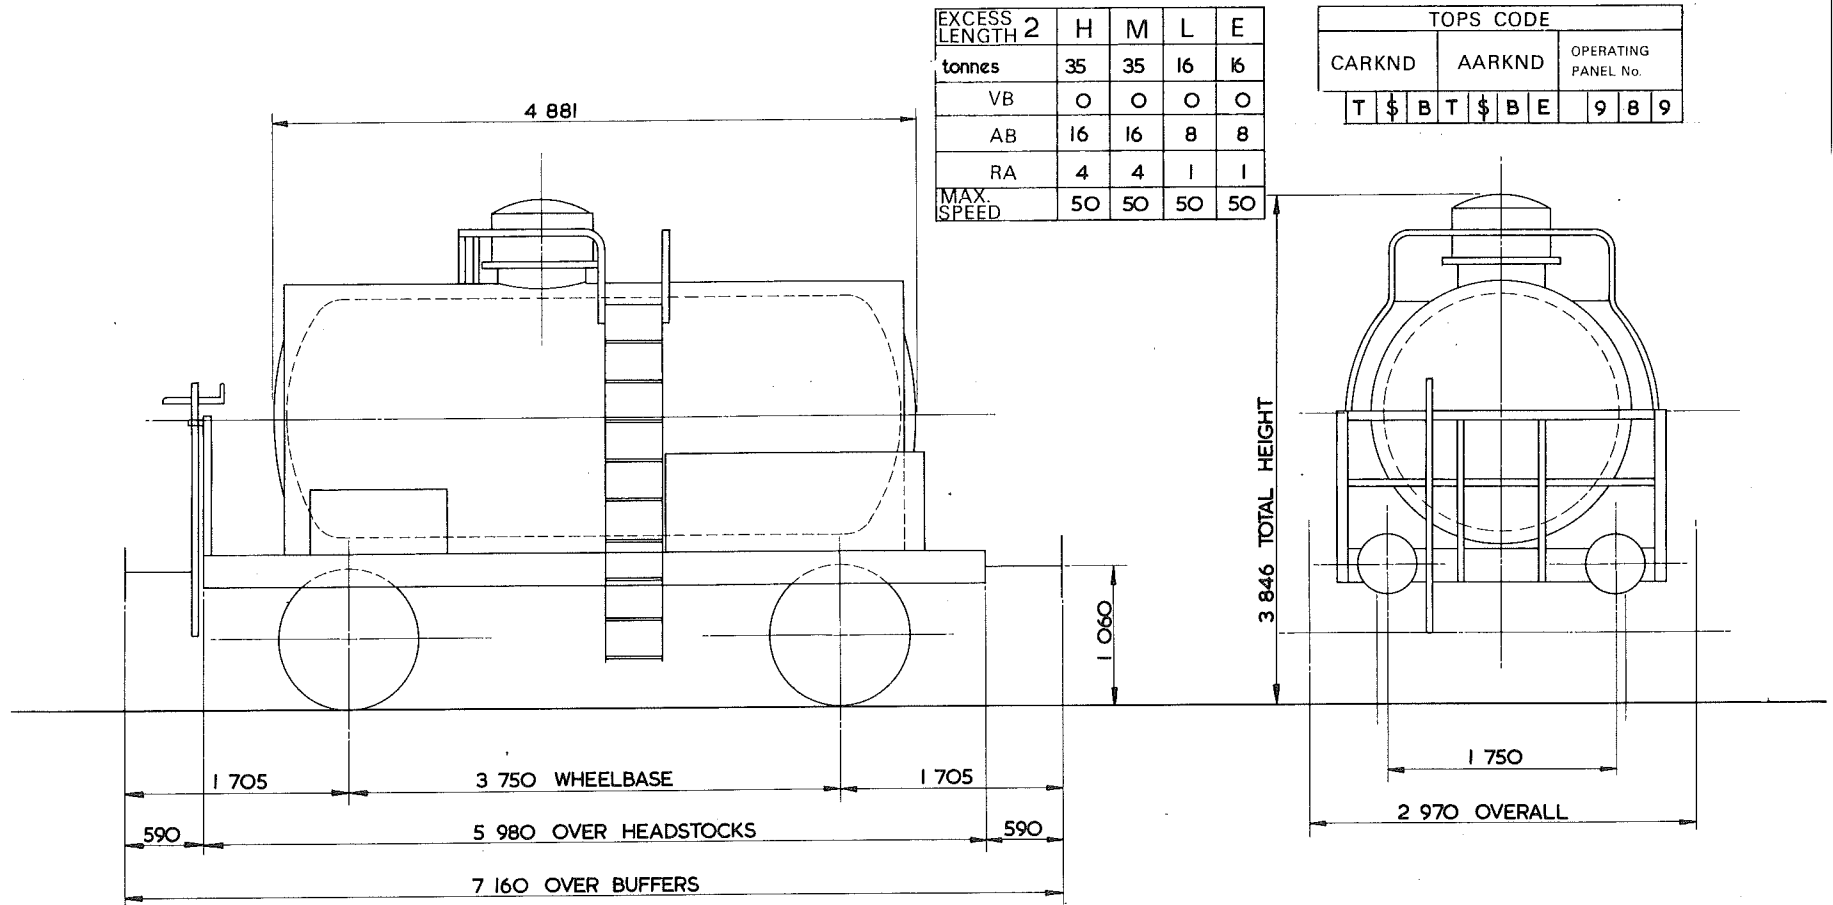

TARE - 15 ²⁵⁰ kg
CARRYING CAPACITY - 20 000 kg
CAPACITY - 10 500 litres
MAX. SPEED - 50 mile/h
WHEELS - 1050 DIA
JOURNALS - 250 x 130 PLAIN BEARINGS

BUFFERS - SELF CONTAINED 457 DIA HEADS
COUPLINGS - INTERNATIONAL SCREW
MIN. CURVE - 26 m
GEN. ARRGT. DRG. No. - 64515 (S.F.V.) 6090
BRAKE - AIR BLOCK & VACUUM PIPED & HAND SCREW
SUSPENSION - SINGLE LINK


BUILDER - FAUVET GIREL
OWNER - ASSOCIATED OCTEL COMPANY LTD.
REGISTERED BY - C.M. & E.E. (B.R.B) DERBY
YEAR BUILT - 1950
REGISTRATION Nos. - 47078-79, 47081-82
OWNERS Nos. - 252-3, 257-2, 262-2, 263-0

TANK WAGON

T\$O27A

EXCESS LENGTH	H	M	L	E
tonnes	35	35	12	12
VB	16	16	7	7
AB				
RA	4	4	1	1
MAX. SPEED	60	60	60	60

TOPS CODE		
CARKND	AARKND	OPERATING PANEL No.
T \$ V	T \$ V E	7 0 0

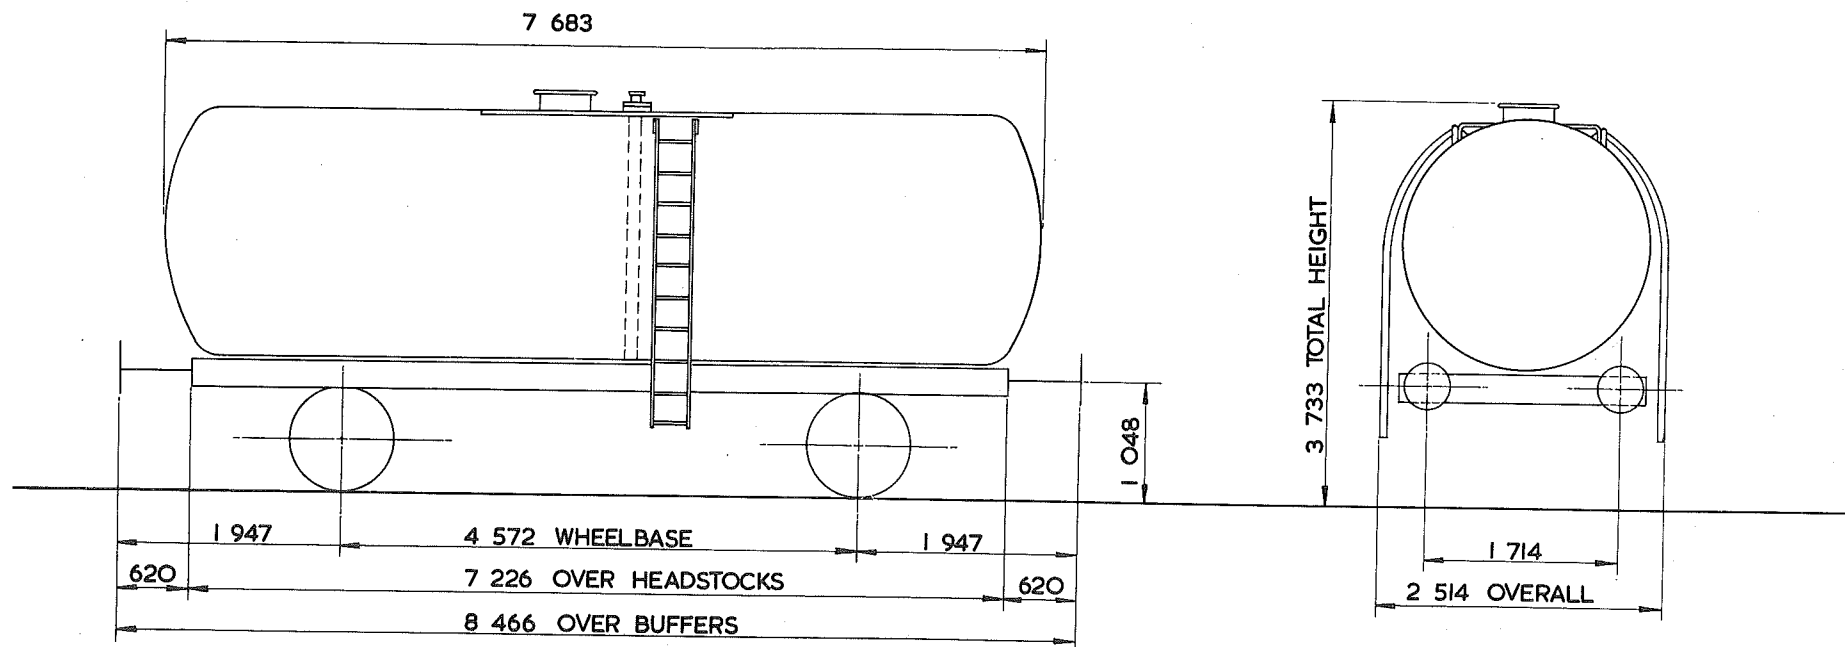

TARE -	11260 kg
CARRYING CAPACITY -	23800 kg 23500 kg
CAPACITY -	26954 litres
MAX. SPEED -	60 mile/h
WHEELS -	952 DIA
JOURNALS -	124 DIA ROLLER BEARINGS

BUFFERS -	HYDRAULIC 406 DIA HEADS
COUPLINGS -	INTERNATIONAL SCREW
MIN. CURVE -	31 m
GEN. ARRGT. DRG. No. -	
BRAKE -	VACUUM BLOCK & HAND LEVER
SUSPENSION -	SHOE

BUILDER -	CHARLES ROBERTS
OWNER -	ESSO
REGISTERED BY -	C.M. & E.E. (B.R.B.) DERBY.
YEAR BUILT -	1959
REGISTRATION Nos. -	44601 TO 44774 (RANGE).
OWNERS Nos. -	4601 TO 4774 (RANGE).


EX. PO. DIAGRAM 6/1.

TANK WAGON

T\$027B

EXCESS LENGTH	4	H	M	L	E
tonnes	35	35	12	12	
VB	16	16	7	7	
AB					
RA	4	4	1	1	
MAX. SPEED	60	60	60	60	

TOPS CODE										
CARKND		AARKND			OPERATING PANEL No					
T	\$	V	T	\$	V	E		7	0	0

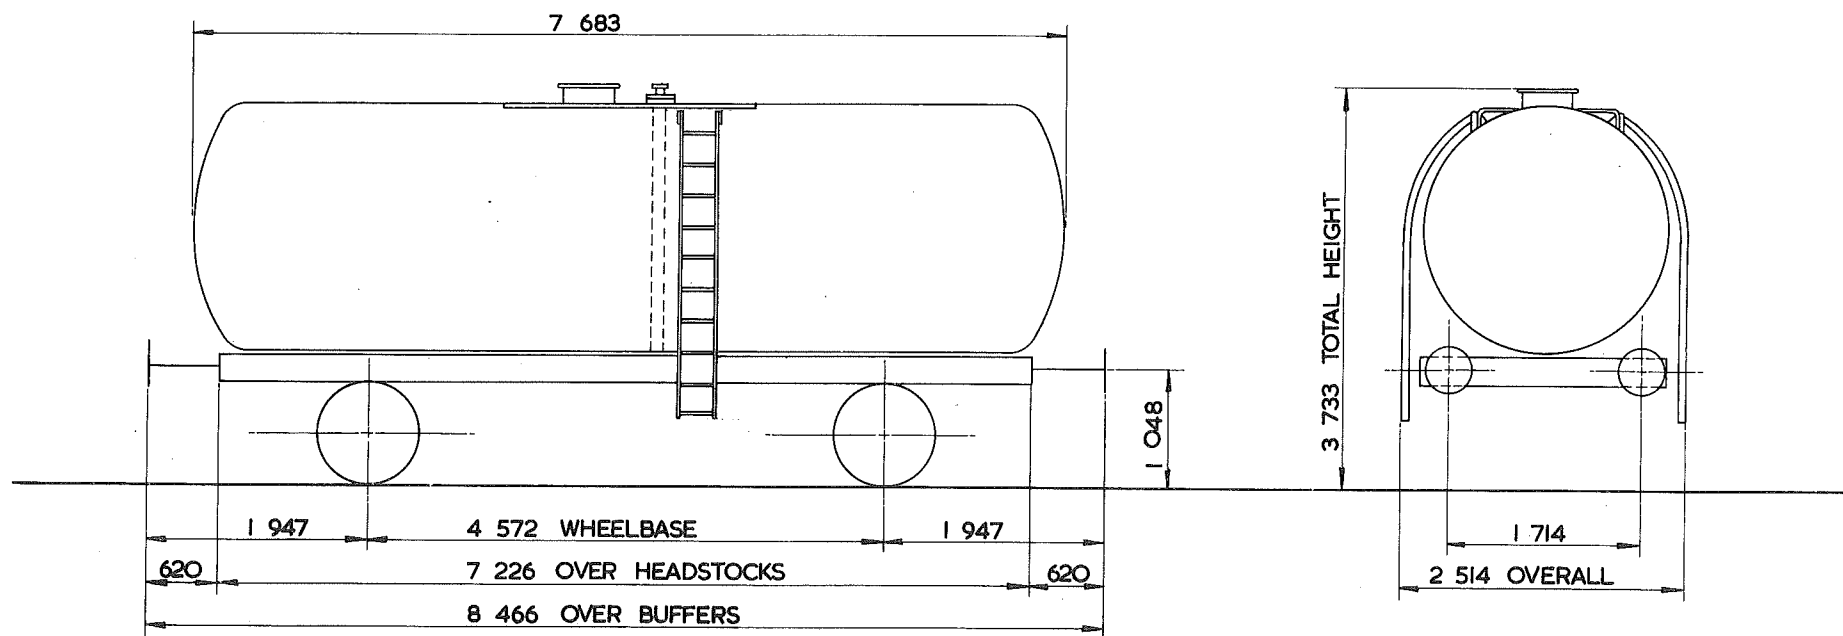

TARE -	11950 kg
CARRYING CAPACITY -	23500 kg
CAPACITY -	26000 litres <i>26,667 LITRES</i>
MAX. SPEED -	60 mile/h
WHEELS -	952 DIA
JOURNALS -	124 DIA ROLLER BEARINGS

BUFFERS -	HYDRAULIC 406 DIA HEADS
COUPLINGS -	INTERNATIONAL SCREW
MIN. CURVE -	31 m
GEN. ARRGT. DRG. No. -	
BRAKE -	VACUUM BLOCK & HAND LEVER
SUSPENSION -	SHOE

BUILDER -	CHARLES ROBERTS
OWNER -	ESSO
REGISTERED BY -	C.M. & E.E. (B.R.B.) DERBY
YEAR BUILT -	1958
REGISTRATION. Nos. -	44711
OWNERS Nos. -	3226


EX. RO. DIAGRAM 6/1.

35 tonnes G.L.W. TANK WAGON.

T\$ O27C.

EXCESS LENGTH 4	H	M	L	E
tonnes	35	35	13	13
VB	16	16	7	7
AB				
RA	4	4	1	1
MAX. SPEED	60	60	60	60

TOPS CODE									
CARKND		AARKND		OPERATING PANEL No.					
T	\$	V	T	\$	V	E	7	0	1

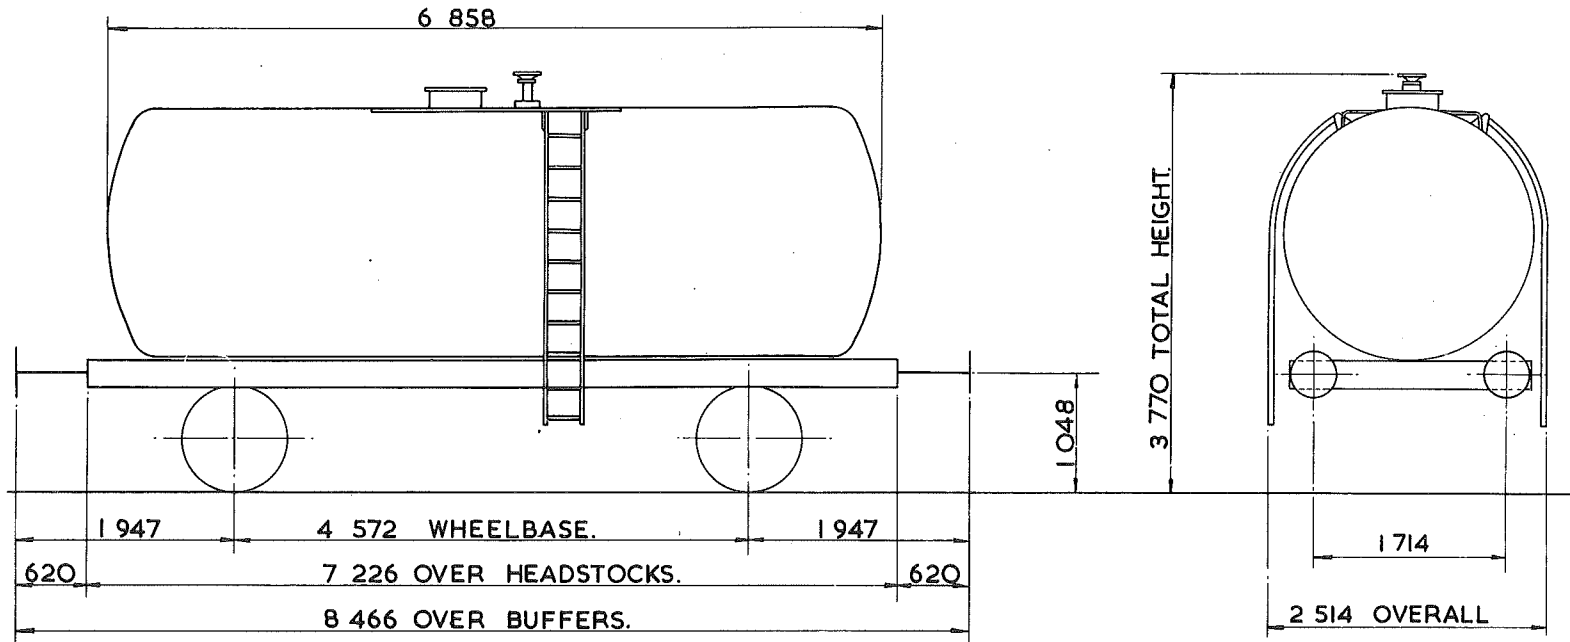

TARE - 12 700 kg.
CARRYING CAPACITY - 23 000 kg.
CAPACITY - 24 048 litres.
MAX. SPEED - 60 mile/h.
WHEELS - 939 DIA.
JOURNALS - 124 DIA. ROLLER BEARINGS.

BUFFERS - HYDRAULIC 406 DIA. HEADS.
COUPLINGS - INTERNATIONAL SCREW.
MIN. CURVE - 31 m.
GEN. ARRGT. DRG. No. -
BRAKE - VACUUM BLOCK & HAND LEVER.
SUSPENSION - SHOE

BUILDER - CHARLES ROBERTS.
OWNER - ESSO.
REGISTERED BY - C.M. & E.E. (B.R.B.) DERBY.
YEAR BUILT - 1958/59.
REGISTRATION Nos. - 43300 TO 43569 (RANGE).
OWNERS Nos. - 33000 TO 3569 (RANGE).


EX. PO. DIAGRAM 6/2

TANK WAGON

T\$O27D.

EXCESS LENGTH - 1/4	H	M	L	E
tonnes	35	35	13	13
VB	16	16	7	7
AB				
RA	4	4	1	1
MAX SPEED	60	60	60	60

TOPS CODE									
CARKND		AARKND		OPERATING PANEL No					
T	\$	V	T	\$	V	E	7	0	4

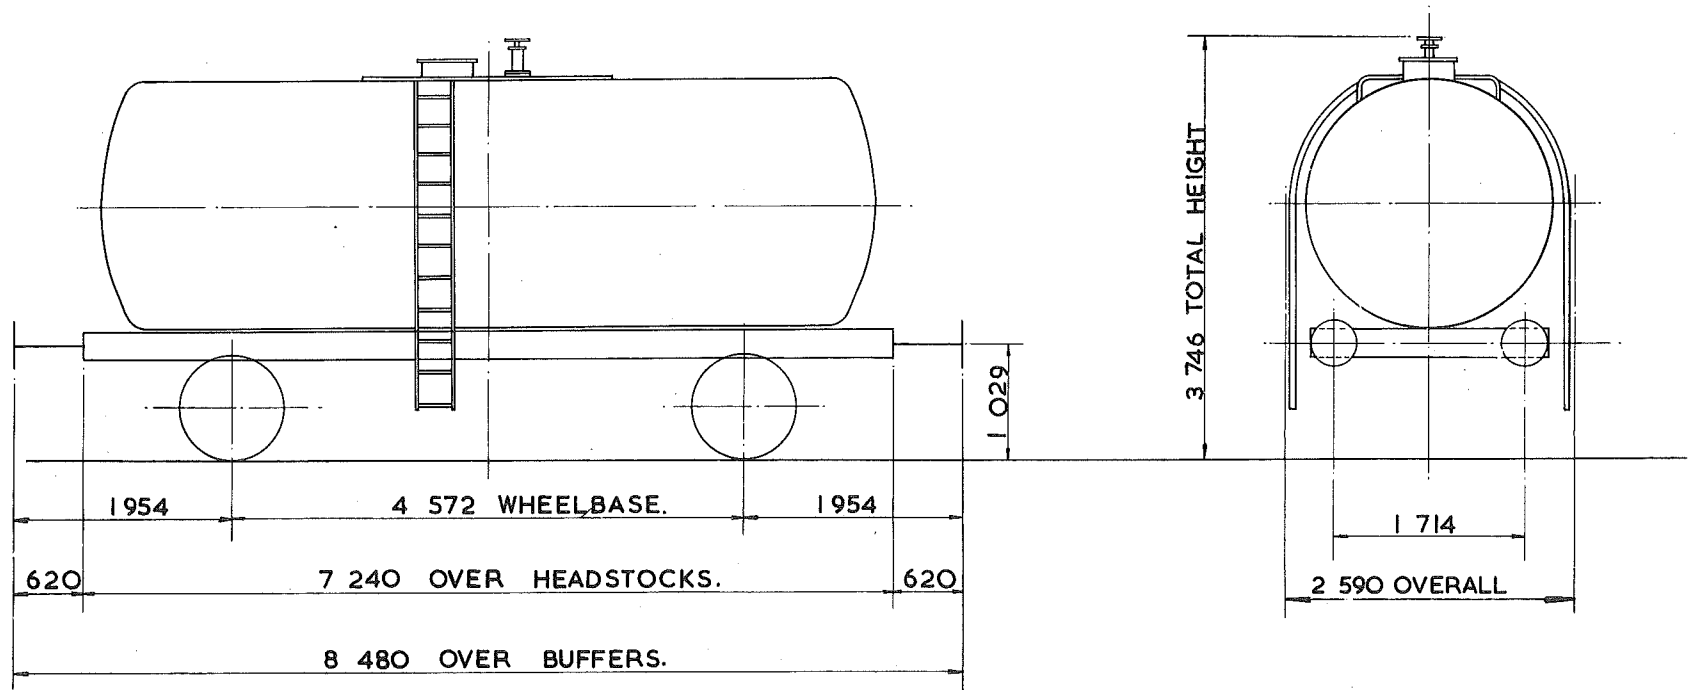

TARE - 12 ⁸⁵⁰ kg.
CARRYING CAPACITY - 22 ⁵⁰⁰ kg.
CAPACITY - 23 ²³⁰ litres
MAX. SPEED - 60 mile/h.
WHEELS - 952 DIA.
JOURNALS - 124 DIA. ROLLER BEARINGS.

BUFFERS - HYDRAULIC 406 DIA. HEADS.
COUPLINGS - INTERNATIONAL SCREW.
MIN. CURVE - 31m.
GEN. ARRG. DRG. No. -
BRAKE - VACUUM. BLOCK & HAND LEVER.
SUSPENSION - SHOE.


BUILDER - HURST NELSON.
OWNER - ESSO PETROLEUM.
REGISTERED BY - C.M. & E.E. (B.R.B.) DERBY.
YEAR BUILT - 1958.
REGISTRATION Nos. - ⁴³⁶⁰¹ 43570 TO 43789 (RANGE)
OWNERS Nos. - ³³¹ 3570 TO 3789 (RANGE)

35 tonnes G.L.W. TANK WAGON

T\$027E

EXCESS LENGTH	4	H	M	L	E
tonnes	35	35	13	13	
VB	16	16	7	7	
AB					
RA	4	4	1	1	
MAX. SPEED	60	60	60	60	

TOPS CODE					
CARKND	AARKND		OPERATING PANEL No.		
T	\$	V	T	\$	V E
					7 0 1

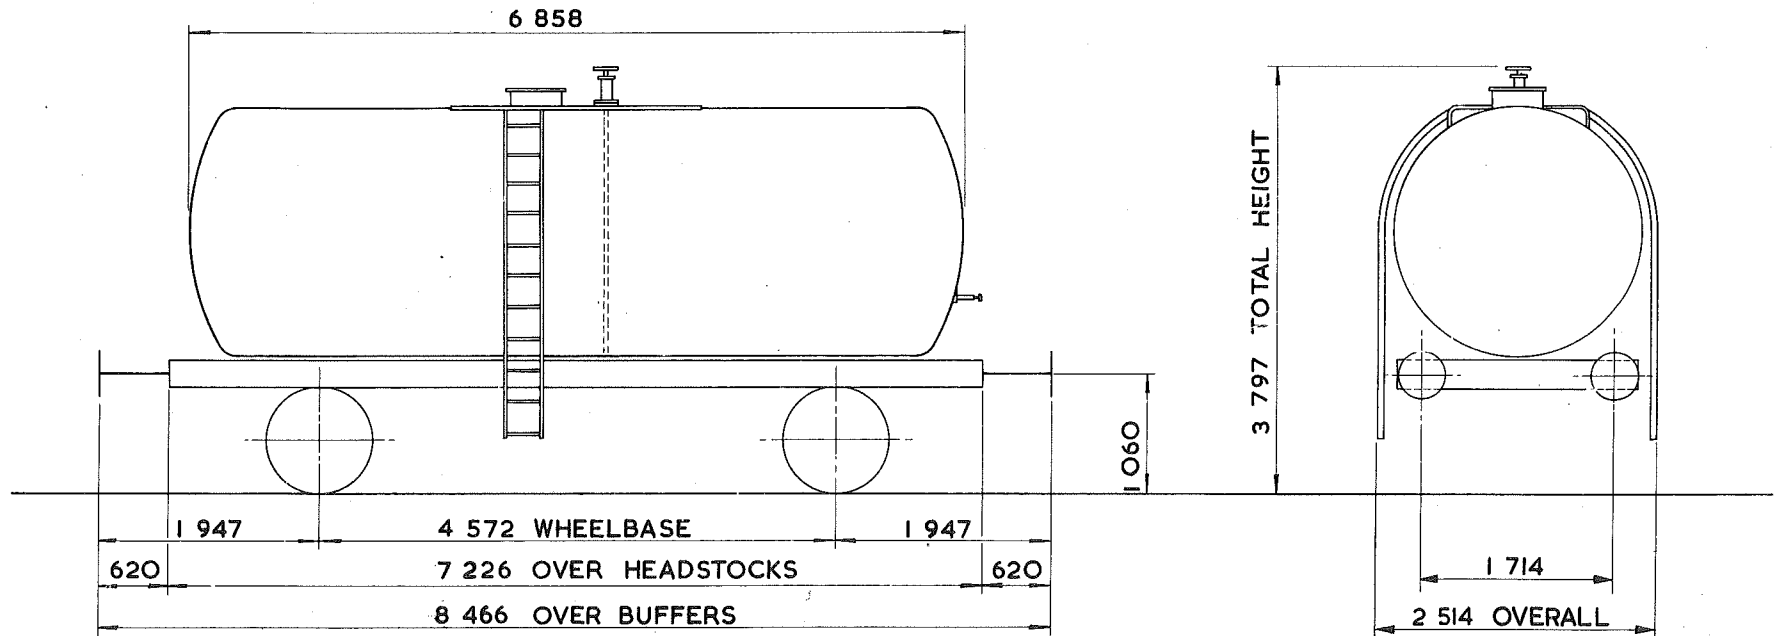

TARE - 12850 kg
CARRYING CAPACITY - 22500 kg
CAPACITY - 24048 litres
MAX. SPEED - 60 mile/h
WHEELS - 952 DIA
JOURNALS - 124 DIA. ROLLER BEARINGS

BUFFERS - HYDRAULIC 406 DIA. HEADS
COUPLINGS - INTERNATIONAL SCREW
MIN. CURVE - 31 m
GEN. ARRGT. DRG. No. -
BRAKE - VACUUM BLOCK & HAND LEVER
SUSPENSION - EYEBOLT


BUILDER - CHARLES ROBERTS
OWNER - ESSO
REGISTERED BY - C.M. & E.E. (B.R.B.) DERBY.
YEAR BUILT - 1961
REGISTRATION Nos. - 43964 TO 43999, 44189 TO 44202
OWNERS Nos. - 3964 TO 3999, 4189 TO 4202

35 tonnes G.L.W. TANK WAGON

T\$027F

EXCESS LENGTH	4	H	M	L	E
tonnes	35	35	13	13	
VB	16	16	7	7	
AB					
RA	4	4	1	1	
MAX. SPEED	60	60	60	60	

TOPS CODE									
CARKND		AARKND			OPERATING PANEL No.				
T	\$	V	T	\$	V	E	7	O	I

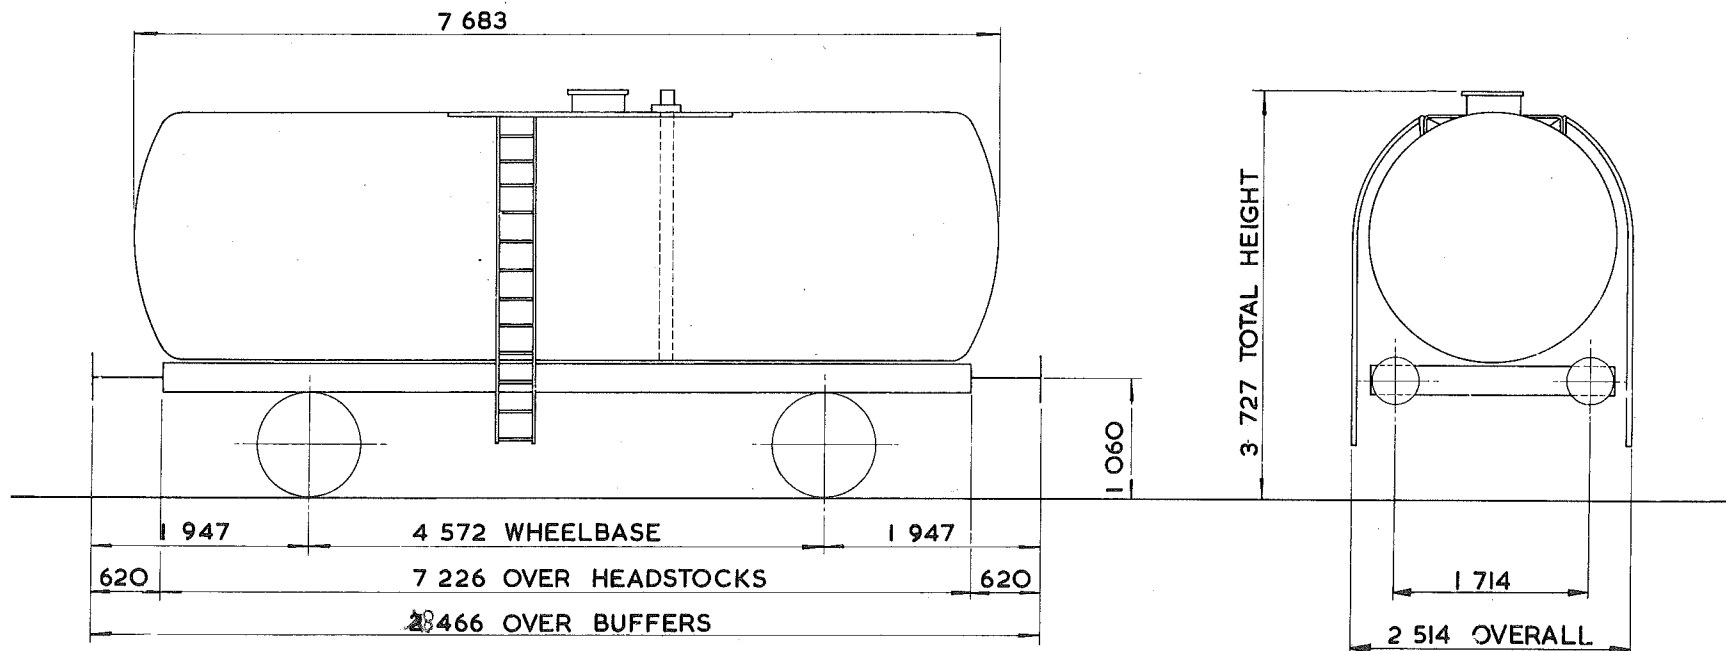


TARE - 12 450 kg
CARRYING CAPACITY - 22 500 kg 23,000 kg.
CAPACITY - 26 835 litres
MAX. SPEED - 60 mile/h
WHEELS - 952
JOURNALS - 124 DIA. ROLLER BEARINGS

BUFFERS - HYDRAULIC 406 DIA. HEADS
COUPLINGS - INTERNATIONAL SCREW
MIN. CURVE - 31 m
GEN. ARRGT. DRG. No. -
BRAKE - VACUUM BLOCK & HAND LEVER
SUSPENSION - EYEBOLT

BUILDER - CHARLES ROBERTS
OWNER - ESSO
REGISTERED BY - C.M. & E.E. (B.R.B.) DERBY
YEAR BUILT - 1961
REGISTRATION Nos. - 44139 TO 44188 (RANGE)
OWNERS Nos. - 4139 TO 4188 (RANGE)

EXCESS LENGTH	4	H	M	L	E
tonnes	35	35	13	13	
VB	16	16	7	7	
AB					
RA	4	4	1	1	
MAX. SPEED	60	60	60	60	

TOPS CODE									
CARKND			AARKND			OPERATING PANEL NO.			
T	\$	V	T	\$	V	E	7	0	1

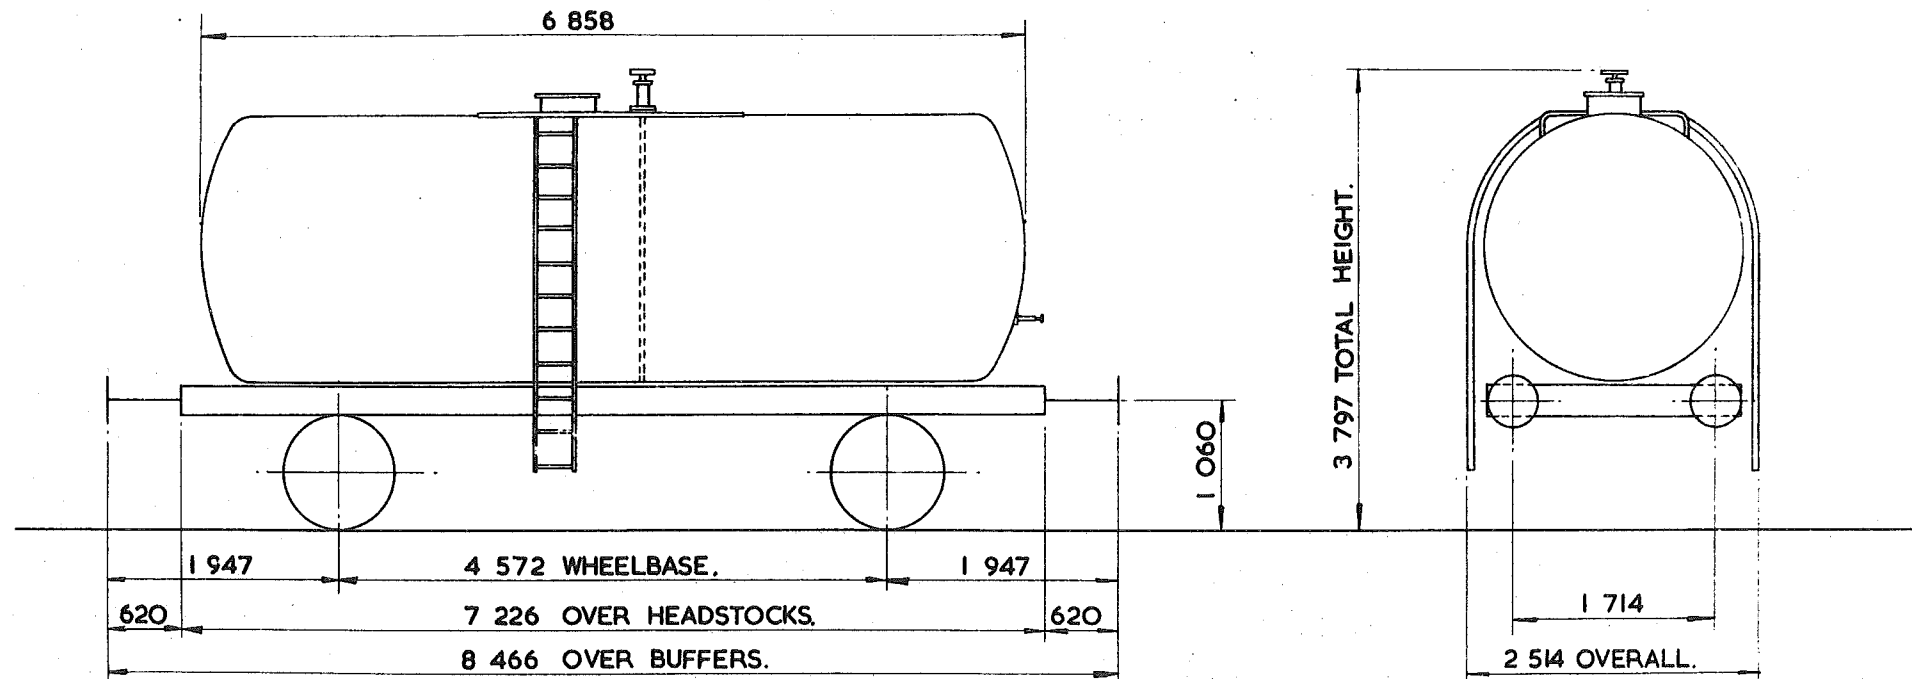

TARE	12 850kg.
CARRYING CAPACITY	22 ⁵⁰⁰ kg.
CAPACITY	24 048 litres.
MAX. SPEED	60 mile/h.
WHEELS	952 DIA.
JO JRNALS	124 DIA. ROLLER BEARINGS.

BUFFERS	HYDRAULIC 406 DIA. HEADS.
COUPLINGS	INTERNATIONAL SCREW.
MIN. CURVE	31m.
GEN. ARRGT. DRG. No.	
BRAKE	VACUUM BLOCK & HAND LEVER.
SUSPENSION	EYEBOLT


BUILDER	CHARLES ROBERTS.
OWNER	ESSO.
REGISTERED BY	C.M. & E.E. (B.R.B.) DERBY
YEAR BUILT	1961
REGISTRATION Nos	44189 - 44202.
OWNERS Nos.	

35 tonnes G. L.W. TANK - WAGON

T\$O28A

EXCESS LENGTH 4	H	M	L	E
tonnes	35	35	15	15
VB	16	16	8	8
AB				
RA	4	4	1	1
MAX. SPEED	60	60	60	60

TOPS CODE					
CARKND		AARKND		OPERATING PANEL No	
T	\$	V	T	\$	V
E					
7	0	5			

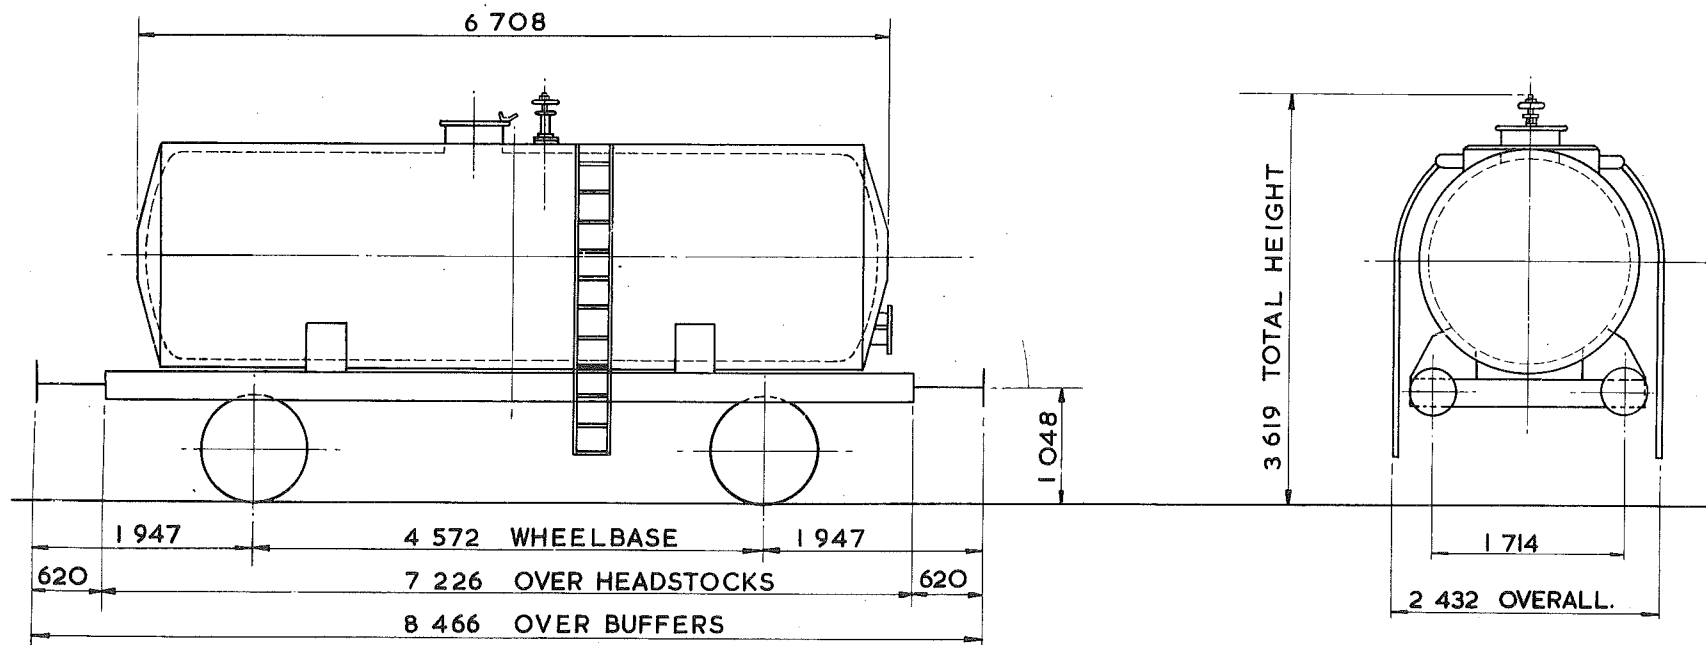

TARE - 13 500 kg
CARRYING CAPACITY - 21 500 kg 22,000 kg
CAPACITY - 16365 litres
MAX. SPEED - 60 mile/h
WHEELS - 939 DIA.
JOURNALS - 124 DIA. ROLLER BEARINGS

BUFFERS - HYDRAULIC 406 DIA. HEADS
COUPLINGS - INTERNATIONAL SCREW
MIN. CURVE - 31 m
GEN. ARRGT. DRG. No. -
BRAKE - VACUUM BLOCK & HAND LEVER
SUSPENSION - SHOE



BUILDER - CHARLES ROBERTS & Co LTD.
OWNER - FISIONS LTD.
REGISTERED BY - C.M. & E.E. (B.R.B.) DERBY
YEAR BUILT - 1958
REGISTRATION Nos. - 47351 TO 47395
OWNERS Nos. - M12/1 TO M12/45

TANK WAGON

T\$O29A

EXCESS LENGTH	4	H	M	L	E
tonnes	35	35	13	13	
VB	16	16	7	7	
AB					
RA	4	4	1	1	
MAX. SPEED	60	60	60	60	

TOPS CODE					
CARKND	AARKND		OPERATING PANEL No		
T	\$	V	T	\$	V E
					7 0 1

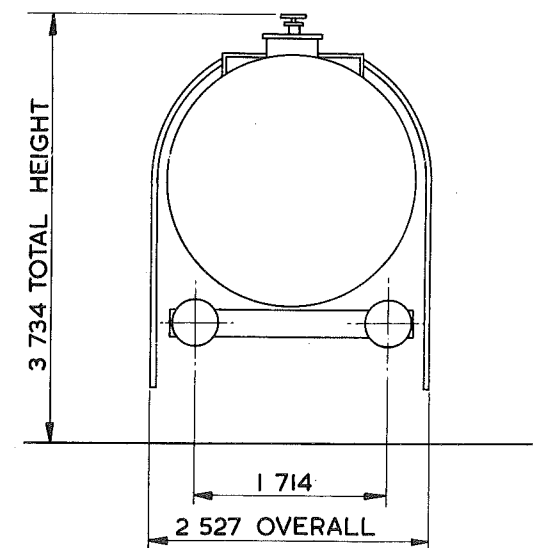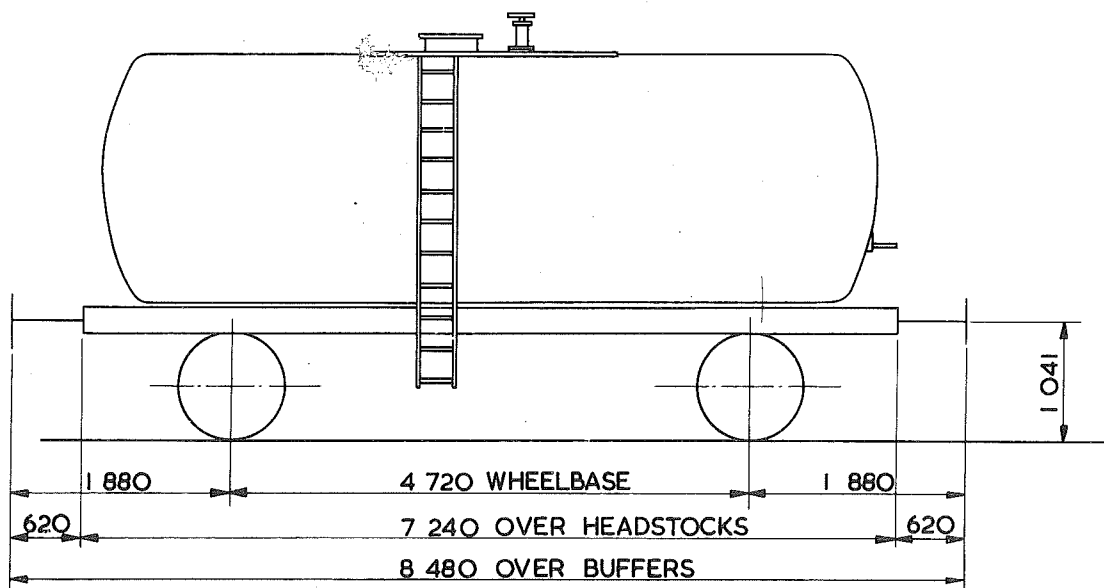

TARE - 12950 kg
CARRYING CAPACITY - 22500kg
CAPACITY - 24 412 litres
MAX. SPEED - 60 mile/h
WHEELS - 952 DIA.
JOURNALS - 124 DIA. ROLLER BEARINGS

BUFFERS - HYDRAULIC 406 DIA. HEADS
COUPLINGS - B.R. SCREW
MIN. CURVE - 31m
GEN. ARRGT. DRG. No. -
BRAKE - VACUUM BLOCK & HAND LEVER
SUSPENSION - SHOE


BUILDER - CHARLES ROBERTS
OWNER - TANK RENTALS TIGERRAILCAR LEASING LTD
REGISTERED BY - C.M. & E.E. (B.R.B.) DERBY
YEAR BUILT - 1958
REGISTRATION Nos. - 47993 - 48001
OWNERS Nos. - A1 - A9

TANK WAGON

T\$029B

EXCESS LENGTH	4	H	M	L	E
tonnes	35	35	13	13	
VB	16	16	7	7	
AB					
RA	4	4	1	1	
MAX. SPEED	60	60	60	60	

TOPS CODE					
CARKND		AARKND		OPERATING PANEL No.	
T	\$	V	T	\$	V E
					7 0 1

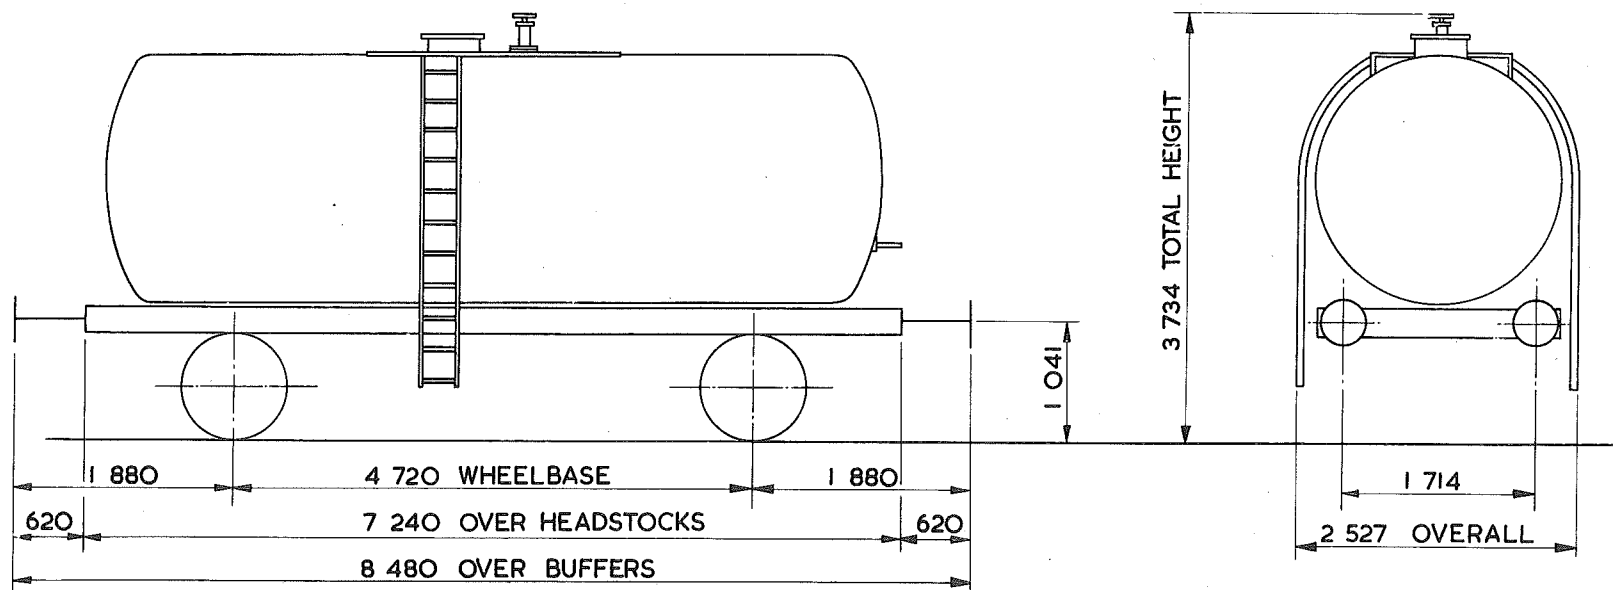

TARE - 12 950 kg
CARRYING CAPACITY - 22 500 kg
CAPACITY - 24 412 litres
MAX. SPEED - 60 mile/h
WHEELS - 952 DIA.
JOURNALS - 124 DIA. ROLLER BEARINGS

BUFFERS - HYDRAULIC 406 DIA. HEADS
COUPLINGS - SCREW
MIN. CURVE - 31 m
GEN. ARRGT. DRG. No. -
BRAKE - VACUUM BLOCK & HAND LEVER
SUSPENSION - SHOE


BUILDER - CHARLES ROBERTS
OWNER - TANK RENTALS Tiger Barrowmoremrg Ltd
REGISTERED BY - C.M. & E.E. (B.R.B) DERBY
YEAR BUILT - 1958
REGISTRATION Nos. - 48002-48007, 48009, 48011-48013, 48015
OWNERS Nos. - A20 - A25, A27, A29 - A31, A33

TANK WAGON

T\$029C

EXCESS LENGTH	3	H	M	L	E
tonnes	35	35	13	13	
VB	16	16	7	7	
AB					
RA	4	4	1	1	
MAX. SPEED	60	60	60	60	

TOPS CODE									
CARKND			AARKND			OPERATING PANEL No.			
T	\$	V	T	\$	V	E	7	0	2

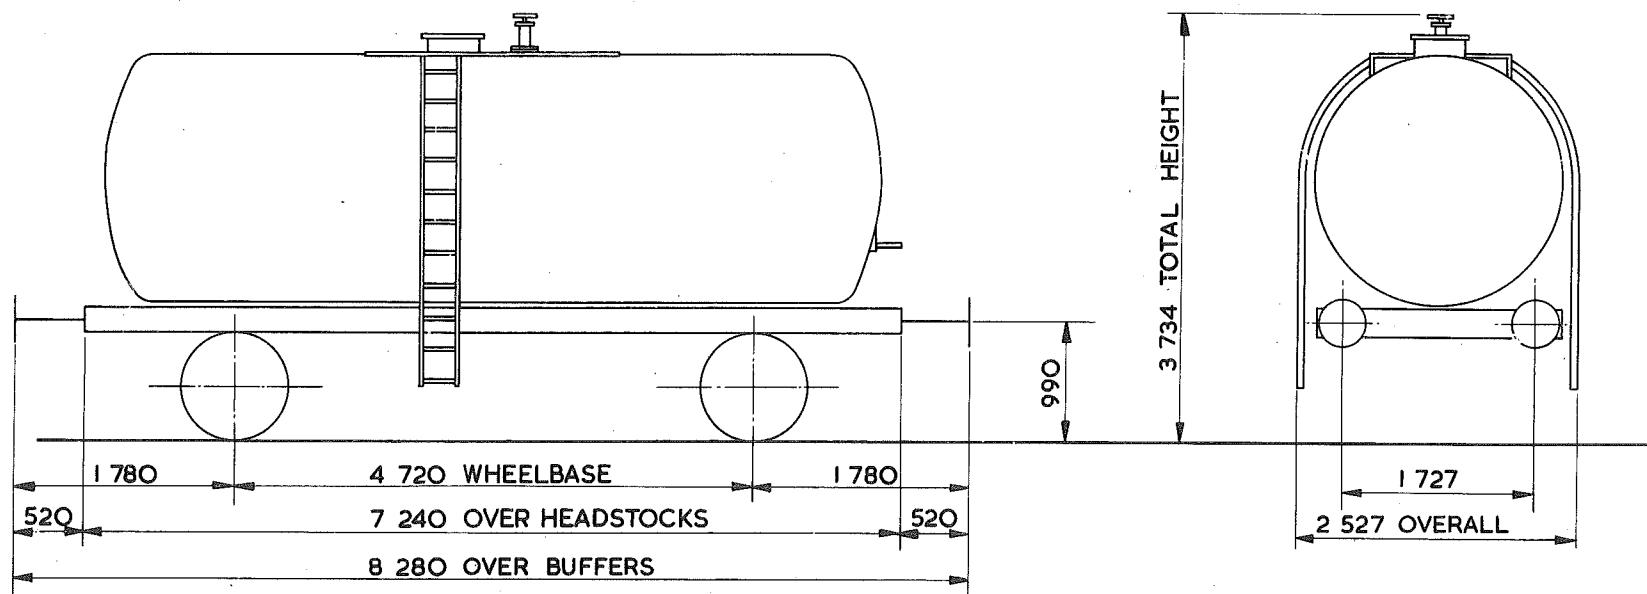

TARE - 12500 kg
CARRYING CAPACITY - 22500 kg
CAPACITY - 24412 litres
MAX. SPEED - 60 mile/h
WHEELS - 952 DIA.
JOURNALS - 124 DIA. ROLLER BEARINGS

BUFFERS - HYDRAULIC 406 DIA. HEADS
COUPLINGS - INSTANTER
MIN. CURVE - 31m
GEN. ARRGT. DRG. No. -
BRAKE - VACUUM BLOCK & HAND LEVER
SUSPENSION - SHOE


BUILDER - CHARLES ROBERTS
OWNER - TANK RENTALS TIGER RAILCAR LEASING LTD
REGISTERED BY - C.M.&E.E. (B.R.B.) DERBY
YEAR BUILT - 1959
REGISTRATION Nos. - 48008, 48010, 48014, 48016 - 48031
OWNERS Nos. - A26, A28, A32, A34 - A49

35 tonnes G.L.W. TANK WAGON.

T\$O29D

EXCESS LENGTH	3	H	M	L	E
tonnes	35	35	13	13	
VB	16	16	7	7	
AB					
RA	4	4	1	1	
MAX. SPEED	60	60	60	60	

TOPS CODE									
CARKND			AARKND			OPERATING PANEL No.			
T	\$	V	T	\$	V	E	7	0	2

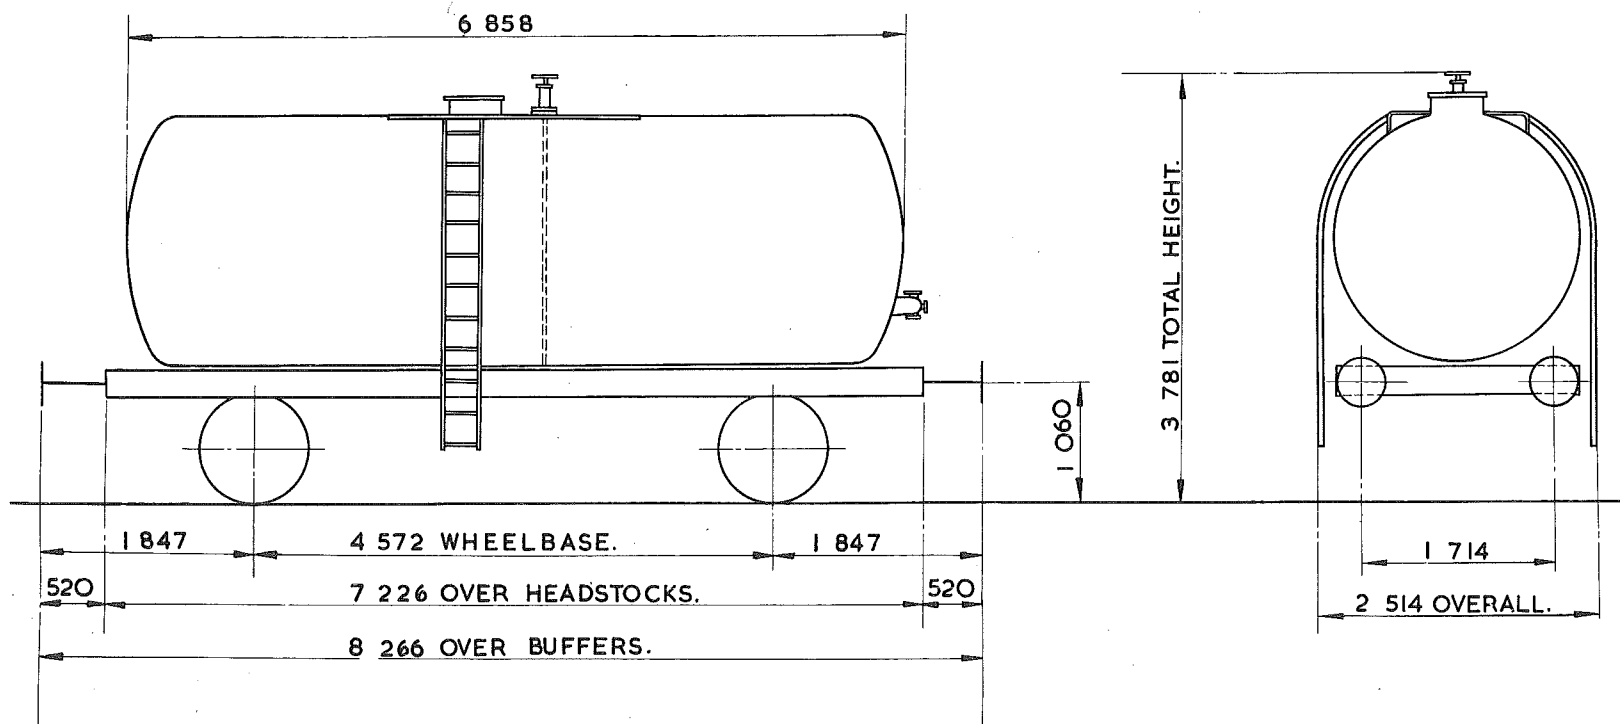

TARE-	12 950 kg
CARRING CAPACITY-	22 500 kg
CAPACITY-	24 048 litres
MAX. SPEED-	60 mile/h
WHEELS-	952 DIA.
JOURNALS-	124 DIA. ROLLER BEARINGS.

BUFFERS-	HYDRAULIC 406 DIA. HEADS
COUPLINGS-	B. R. SCREW.
MIN. CURVE-	31 m
GEN. ARRGT. DRG. No.-	
BRAKE-	VACUUM BLOCK & HAND LEVER
SUSPENSION-	EYEBOLT.


BUILDER-	CHARLES ROBERTS & Co. LTD.
OWNER-	TIGER RAILWAY LEASING LTD. TANK RENTALS.
REGISTERED BY-	C.M. & E.E. (B.R.B.) DERBY
YEAR BUILT-	1961
REGISTRATION Nos.-	48032 TO 48051
OWNERS Nos.-	50 TO 69

35 tonnes G.L.W. TANK WAGON

T\$029E

EXCESS LENGTH	4	H	M	L	E
tonnes	35	35	13	13	
VB	16	16	7	7	
AB					
RA	4	4	1	1	
MAX. SPEED	60	60	60	60	

TOPS CODE									
CARKND		AARKND			OPERATING PANEL No				
T	\$	V	T	\$	V	E	7	0	1

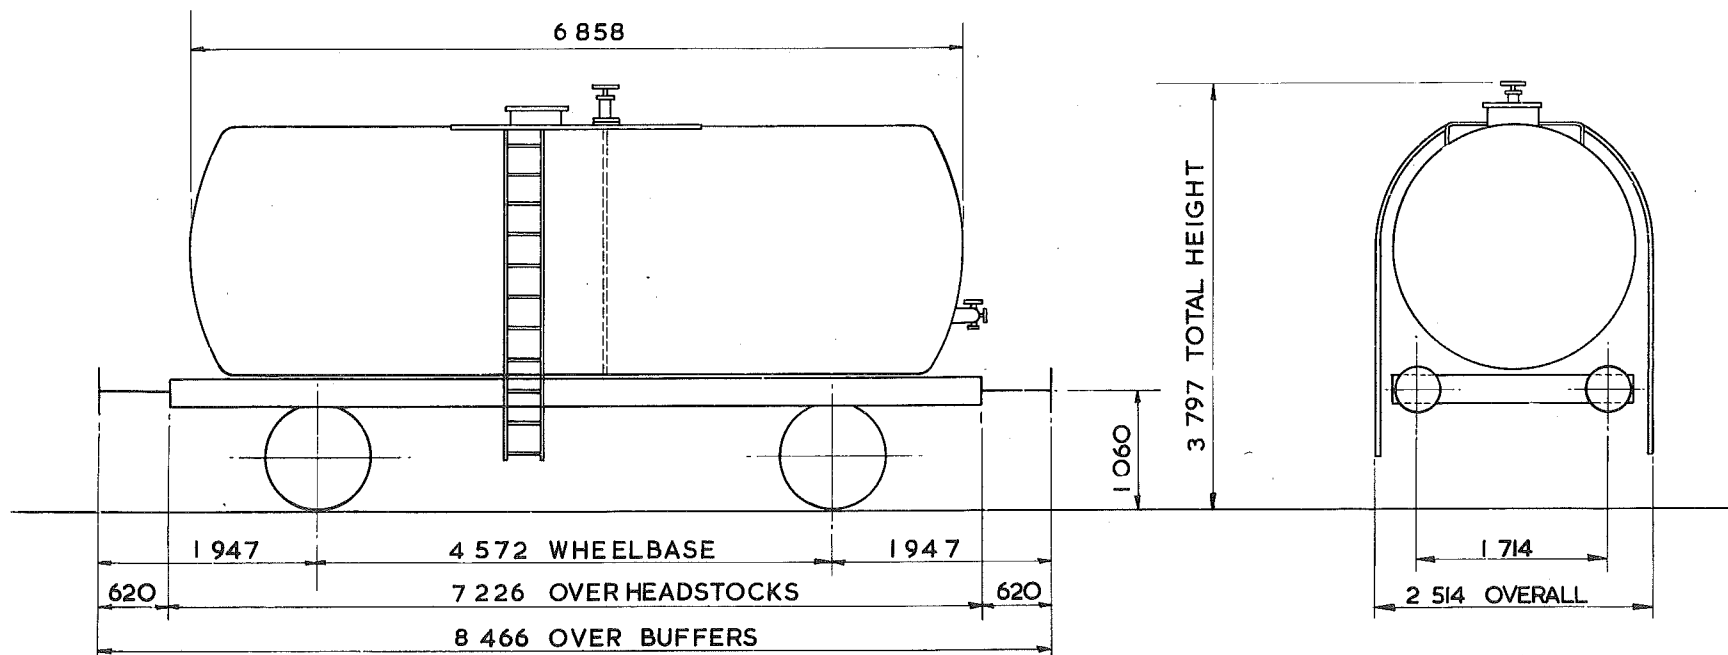

TARE - 12 900 kg
CARRYING CAPACITY - 22 500 kg
CAPACITY - 24,048 litres
MAX. SPEED - 60 mile/h
WHEELS - 952 DIA.
JOURNALS - 124 DIA. ROLLER BEARINGS

BUFFERS - HYDRAULIC 406 DIA. HEADS
COUPLINGS - INTERNATIONAL SCREW
MIN. CURVE - 31m
GEN. ARRGT. DRG. No. -
BRAKE - VACUUM BLOCK & HAND LEVER
SUSPENSION - EYEBOLT.


BUILDER - CHARLES ROBERTS & Co. LTD
OWNER - TANK RENTALS TIGER BALCON LEASING LTD
REGISTERED BY - C.M. & E.E. (B.R.B.) DERBY
YEAR BUILT - 1962
REGISTRATION Nos. - 48052 TO 48057
OWNERS Nos. - A 252 TO 257

TANK WAGON - BITUMEN

T\$O30A

EXCESS LENGTH	4	H	M	L	E
tonnes	35	35	13	13	
VB	16	16	7	7	
AB					
RA	4	4	1	1	
MAX SPEED	60	60	60	60	

TOPS CODE					
CARKND	AARKND	OPERATING PANEL No			
T	\$	V	T	\$	V E
					7 0 4

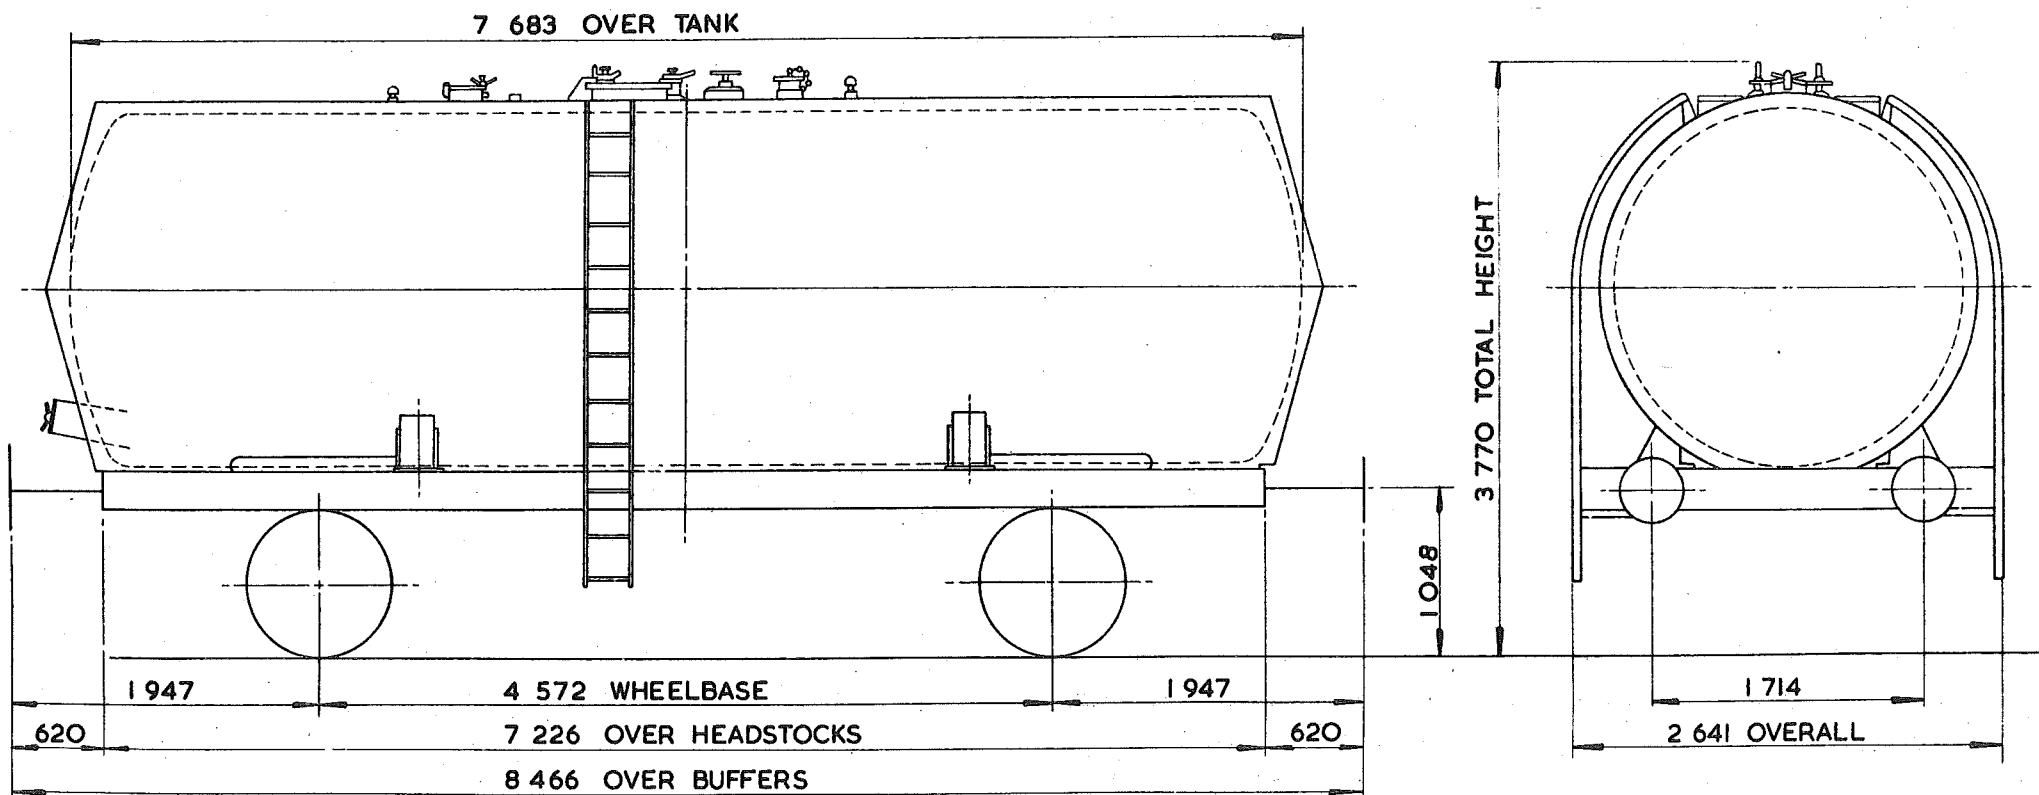

TARE--	12450kg
CARRYING CAPACITY	23000 kg
CAPACITY	26 821 litres
MAX. SPEED--	60 mile/h
WHEELS--	952 DIA.
JOURNALS--	124 DIA. ROLLER BEARINGS

BUFFERS--	HYDRAULIC 406 DIA. HEADS
COUPLINGS--	INTERNATIONAL SCREW
MIN. CURVE--	31m
GEN. ARRG. DRG. No.--	
BRAKE--	VACUUM BLOCK & HAND LEVER
SUSPENSION--	EYEBOLT


BUILDER--	CHARLES ROBERTS
OWNER--	SUKO & BPO
REGISTERED BY--	C.M. & E.E. (B.R.B.) DERBY
YEAR BUILT--	1963
REGISTRATION Nos.--	SUKO-47720,47757,47758&47759
OWNERS Nos.--	BPO-48460 & 48461

35 tonnes G.L.W. TANK WAGON - CLASS.B.

T\$030E

EXCESS LENGTH	4	H	M	L	E
tonnes	35	35	13	13	
VB	16	16	7	7	
AB					
RA	4	4	1	1	
MAX. SPEED	60	60	60	60	

TOPS CODE					
CARKND	AARKND	OPERATING PANEL No.			
T \$	V T	\$ V E	7	0	4

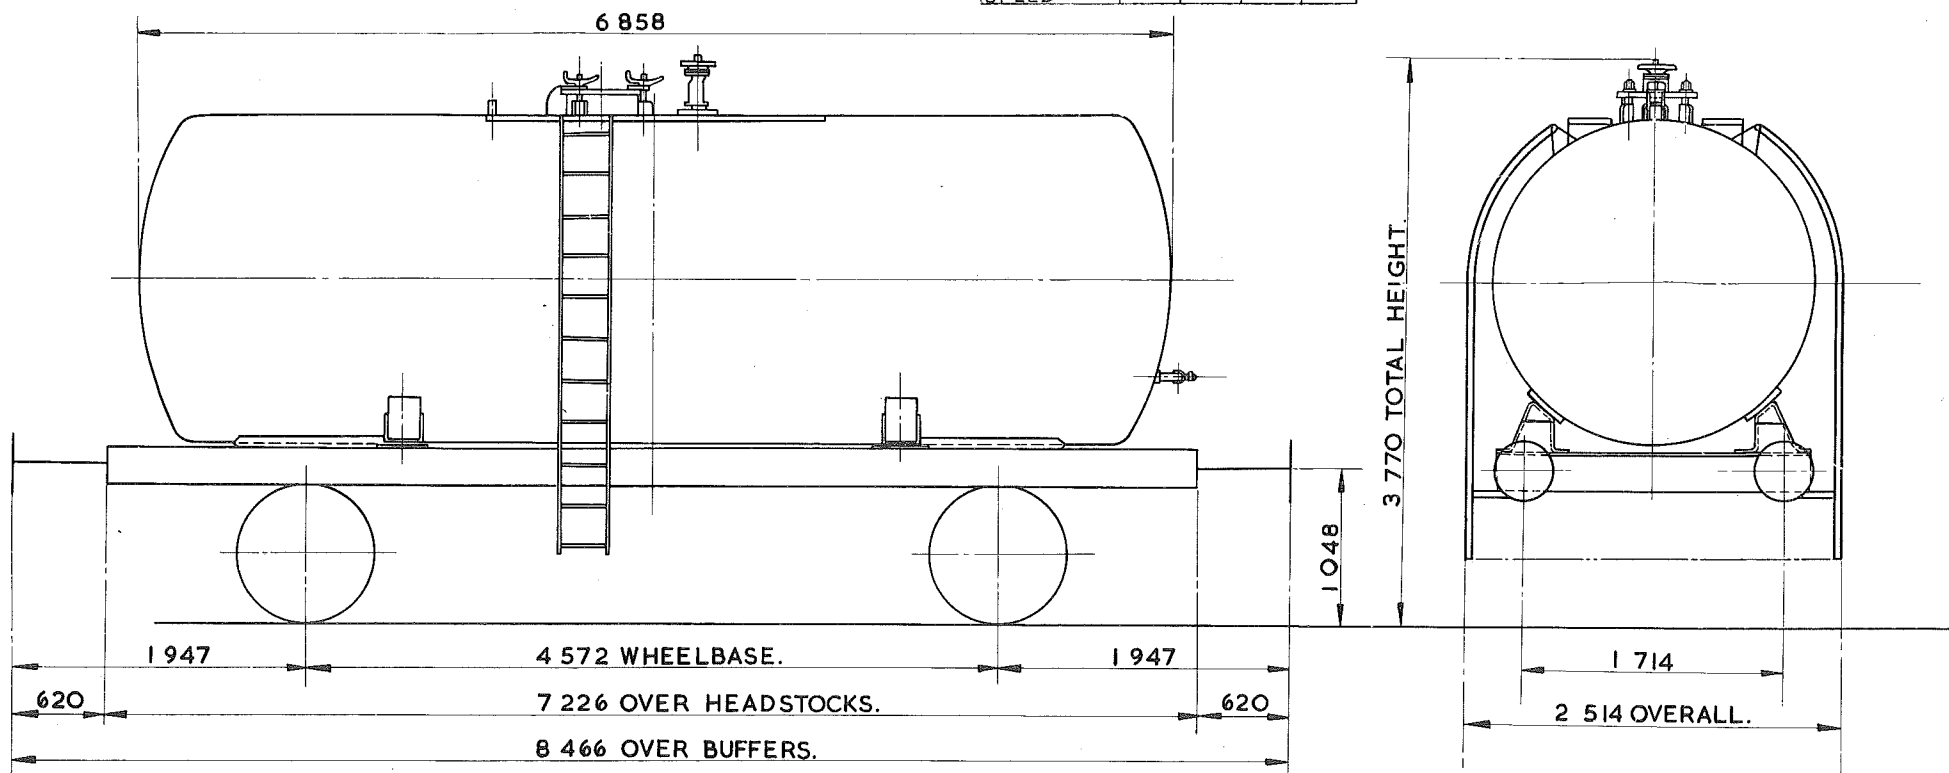

TARE	12850kg
CARRYING CAPACITY	22500kg
CAPACITY	24276 litres
MAX. SPEED	60 mile/h
WHEELS	952 DIA.
JOURNALS	124 DIA. ROLLER BEARINGS.


BUFFERS	HYDRAULIC 40% DIA. HEADS
COUPLINGS	INTERNATIONAL SCREW.
MIN. CURVE	31m
GEN. ARRGT. DRG. No.	
BRAKE	VACUUM BLOCK & HAND LEVER
SUSPENSION	EYEBOLT.

BUILDER	POWELL DUFFRYN.
OWNER	ESSO.
REGISTERED BY	C.M.&E.E.(BRB) DERBY
YEAR BUILT	1958 AND 1962.
REGISTRATION Nos.	43840 TO 44252. (RANGE)
OWNERS Nos.	3840 TO 4252. (RANGE)

35 tonnes GLW TANK WAGON - CLASS B

EXCESS LENGTH	4	H	M	L	E
tonnes	35	35	13	13	
VB	16	16	7	7	
AB					
RA	4	4	1	1	
MAX. SPEED	60	60	60	60	

TOPS CODE									
CARKND			AARKND			OPERATING PANEL No			
T	S	V	T	S	V	E	7	0	4

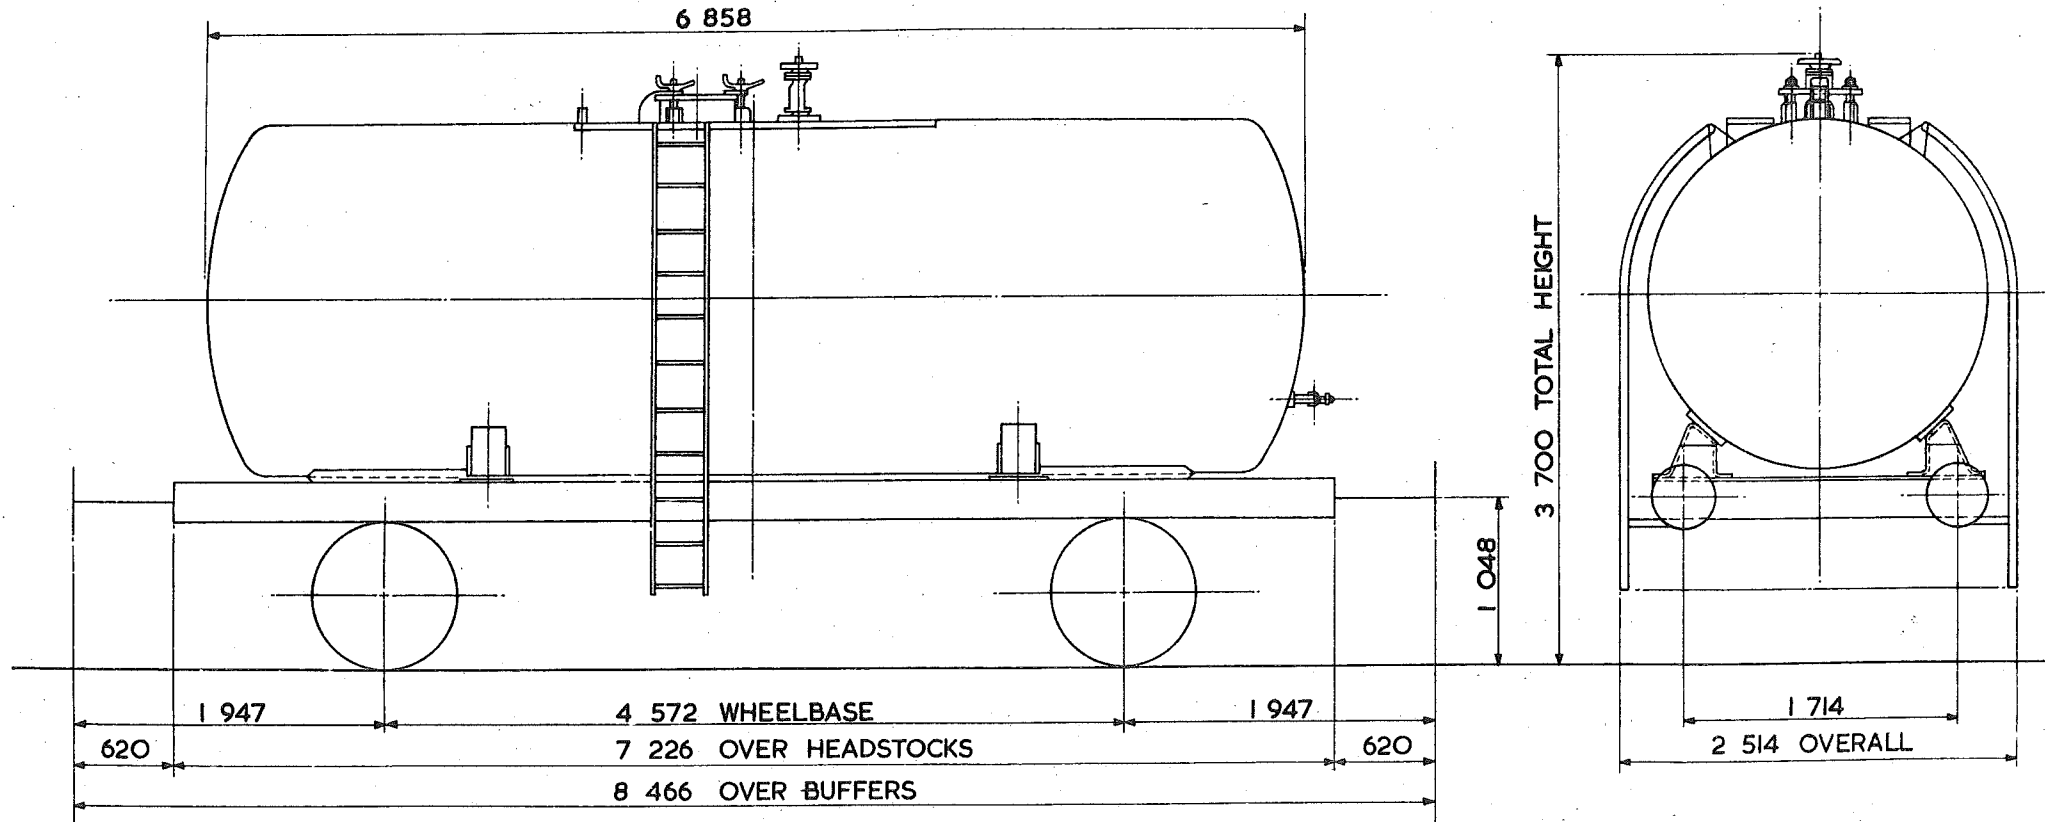

TARE-	12850 kg
CARRYING CAPACITY-	22500 kg
CAPACITY-	24276 litres
MAX. SPEED-	60 mile/h
WHEELS-	952 DIA.
JOURNALS-	124 DIA. ROLLER BEARINGS

BUFFERS-	HYDRAULIC 406 DIA. HEADS
COUPLINGS-	INTERNATIONAL SCREW
MIN. CURVE-	31 m
GEN. ARRGT. DRG. No.-	
BRAKE-	VACUUM BLOCK & HAND LEVER
SUSPENSION-	EYEBOLT


BUILDER-	POWEL DUFFRYN
OWNER-	ESSO
REGISTERED BY-	C.M. & E.E. (B.R.B.) DERBY
YEAR BUILT-	1958 AND 1962
REGISTRATION Nos.-	44203 - 44251
OWNERS Nos.-	

35 tonnes G.L.W. TANK WAGON -CLASS B

T\$030J

EXCESS LENGTH	4	H	M	L	E
tonnes	35	35	13	13	
VB	16	16	7	7	
AB					
RA	4	4	1	1	
MAX. SPEED	60	60	60	60	

TOPS CODE					
CARKND	AARKND		OPERATING PANEL No		
T \$	V	T \$	V	E	7 0 4

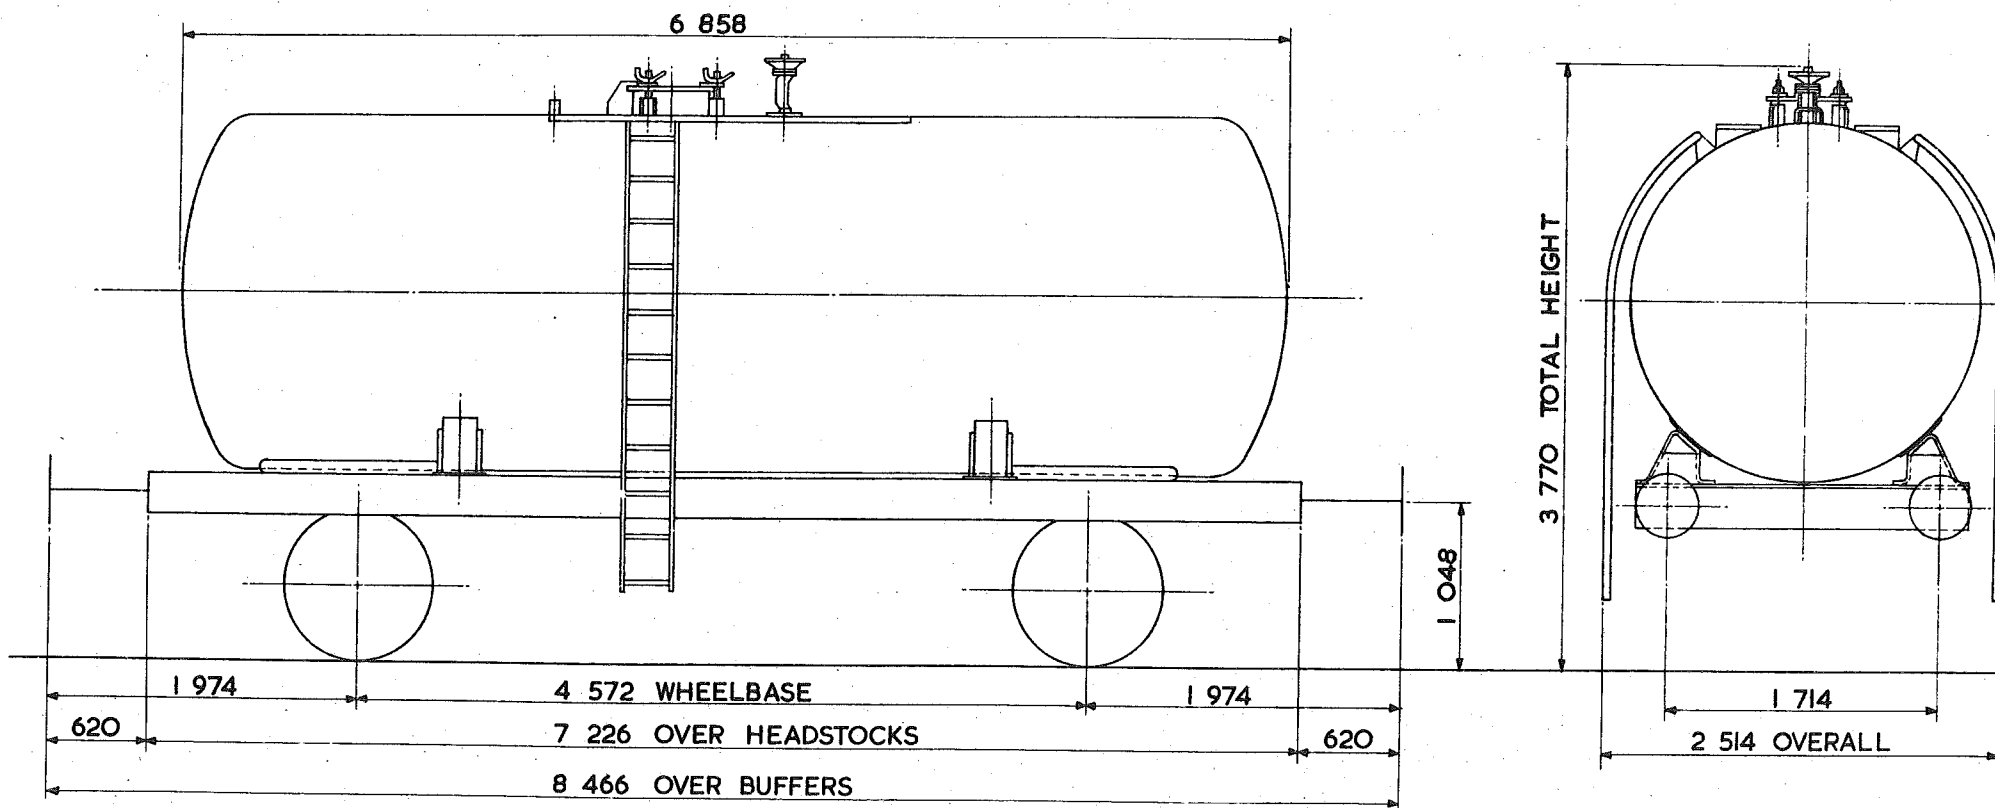



TARE-	12850 kg
CARRYING CAPACITY-	22500 kg
CAPACITY-	24276 litres
MAX. SPEED-	60 mile/h
WHEELS-	952 DIA.
JOURNALS-	124 DIA. ROLLER BEARINGS

BUFFERS-	HYDRAULIC 406 DIA. HEADS
COUPLINGS-	INTERNATIONAL SCREW
MIN. CURVE-	31 m
GEN. ARRGT. DRG. No.-	
BRAKE-	VACUUM BLOCK & HAND LEVER
SUSPENSION-	SINGLE LINK

BUILDER-	POWELL DUFFRYN
OWNER-	CHIPMAN CHEMICALS.
REGISTERED BY-	C.M. & E.E.(B.R.B) DERBY
YEAR BUILT-	1977
REGISTRATION Nos.-	48443 & 48444
OWNERS Nos.-	

EXCESS LENGTH	4	H	M	L	E
tonnes	35	35	13	13	
VB	16	16	7	7	
AB					
RA	4	4	1	1	
MAX. SPEED	60	60	60	60	

TOPS CODE					
CARKND	AARKND		OPERATING PANEL No		
T	\$	V	T	\$	V E
					7 0 1

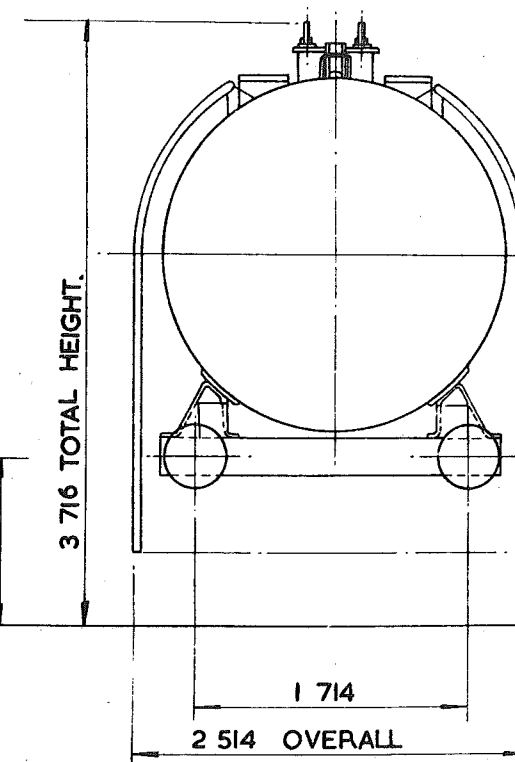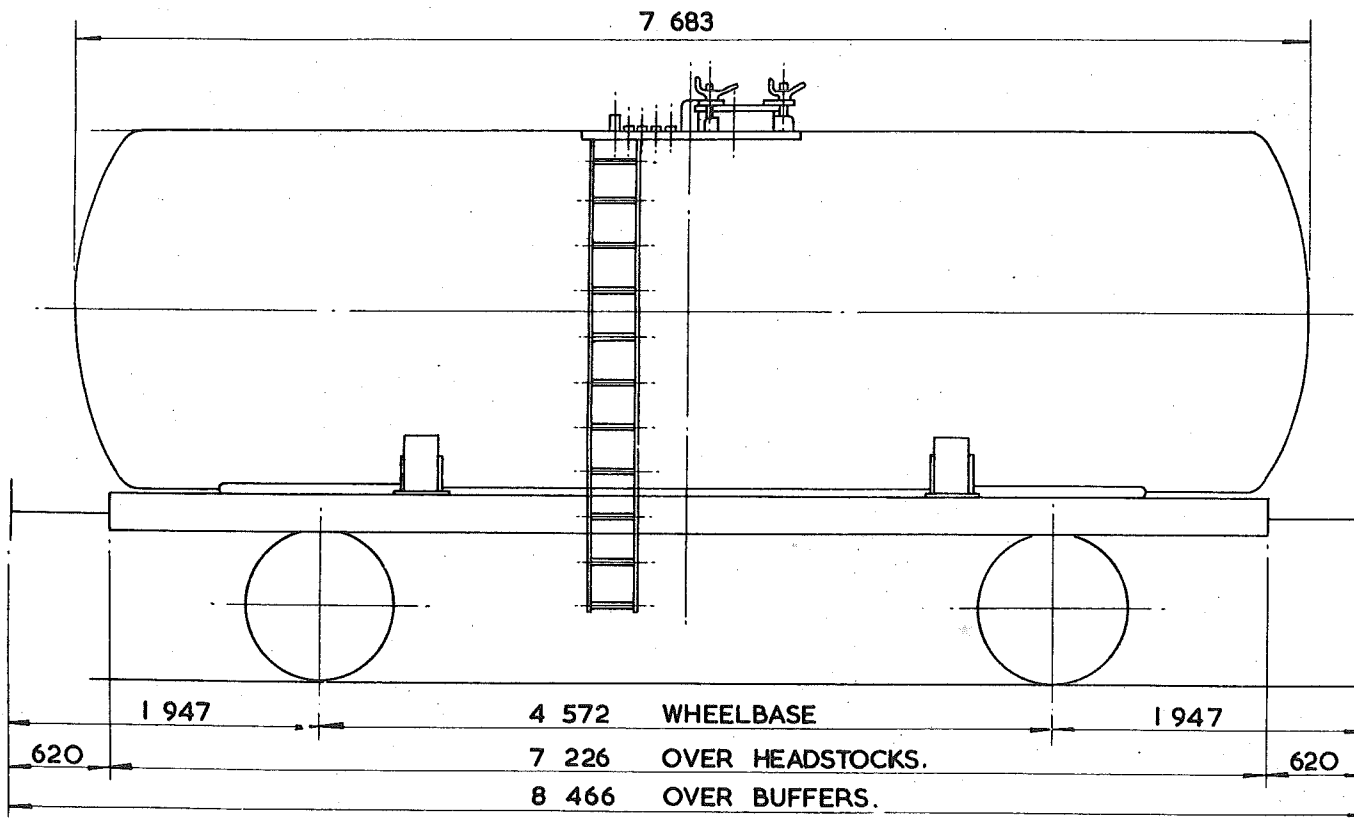

TARE—	12 ⁵⁵⁰ kg.
CARRYING CAPACITY	23 ⁰⁰⁰ kg.
CAPACITY	27.953 litres.
MAX. SPEED—	60 mile/h.
WHEELS—	952 DIA.
JOURNALS—	124 DIA. ROLLER BEARINGS.

BUFFERS—	HYDRAULIC 406 DIA. HEADS.
COUPLINGS—	INTERNATIONAL SCREW.
MIN. CURVE—	31 m.
GEN. ARRGT. DRG. No.—	
BRAKE—	VACUUM BLOCK & HAND LEVER.
SUSPENSION—	EYEBOLT.


BUILDER—	POWELL DUFFRYN.
OWNER—	CHIPMAN CHEMICALS.
REGISTERED BY—	C.M.&E.E.(B.R.B) DERBY.
YEAR BUILT—	1959 / 60/61.
REGISTRATION Nos.—	48115 - 48117, 48119 & 48120.
OWNERS Nos.—	5483 TO 5651 (RANGE).

TANK WAGON

T\$034A

EXCESS LENGTH	4	H	M	L	E
tonnes	35	35	15	15	
VB	16	16	8	8	
AB					
RA	4	4	1	1	
MAX. SPEED	60	60	60	60	

TOPS CODE									
CARKND			AARKND			OPERATING PANEL No.			
T	\$	V	T	\$	V	E	7	0	5

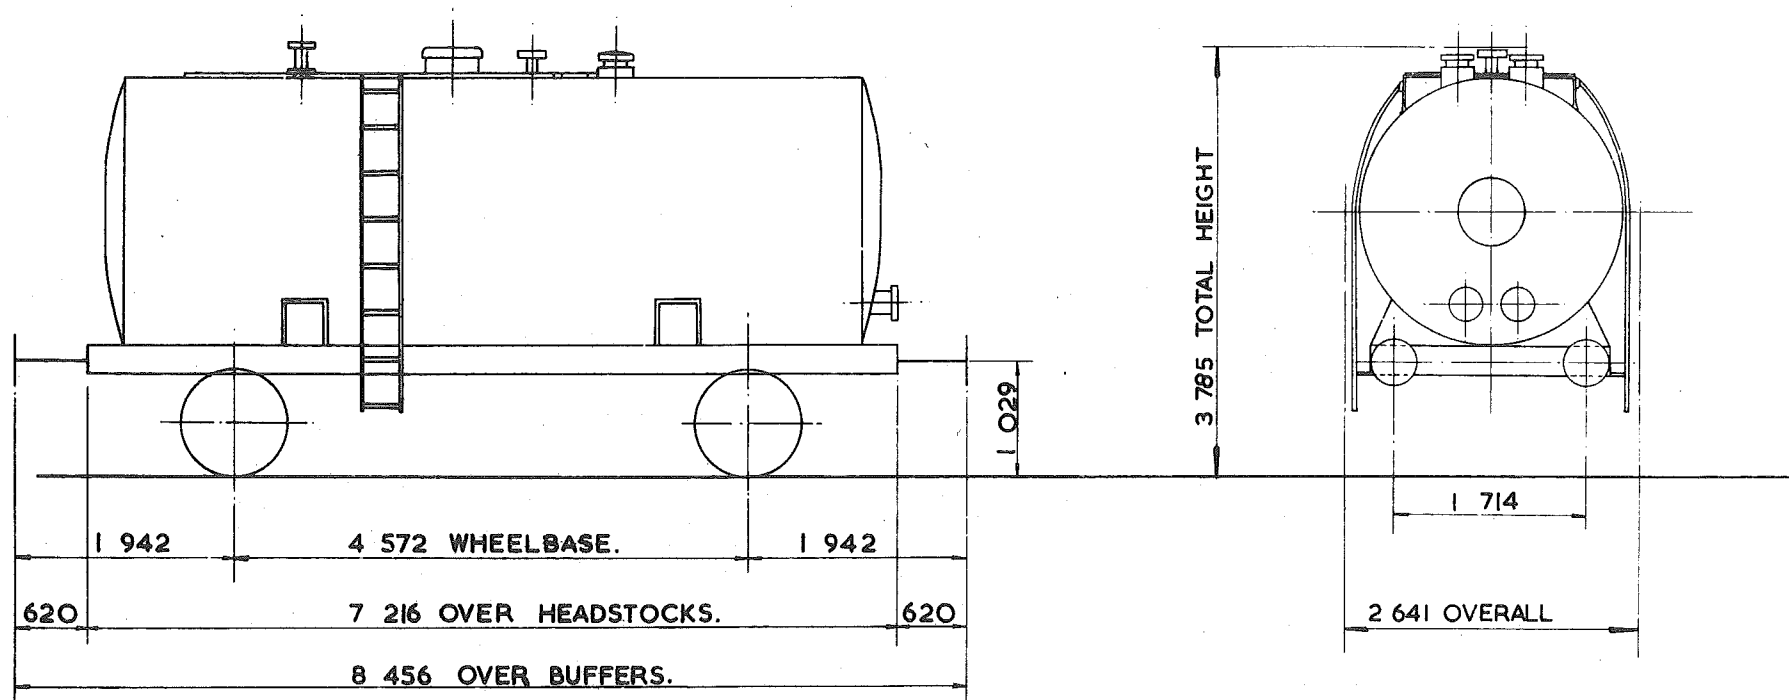

TARE - 14,900kg.
CARRYING CAPACITY - 20 ⁵⁰⁰ kg.
CAPACITY - 20 ³⁵² litres
MAX. SPEED - 60 mile/h.
WHEELS - 952 DIA.
JOURNALS - 124 DIA. ROLLER BEARINGS.

BUFFERS - HYDRAULIC 406 DIA. HEADS
COUPLINGS - INTERNATIONAL SCREW.
MIN. CURVE - 31m.
GEN. ARRGT. DRG. No. -
BRAKE - VACUUM BLOCK & HAND LEVER
SUSPENSION - SHOE.

BUILDER CHARLES ROBERTS.
OWNER ESSO PETROLEUM.
REGISTERED BY - C.M. & E.E.(B.R.B.) DERBY.
YEAR BUILT 1958
REGISTRATION Nos. 43146 TO 43189
OWNERS Nos. 3146 TO 3189.


EX. P.O. DIAGRAM 6/667 (ALLOCATED)

35 tonnes G.L.W. TANK WAGON - CLASS A

T\$035A

EXCESS LENGTH 4	H	M	L	E
tonnes	35	35	13	13
VB	16	16	7	7
AB				
RA	4	4	1	1
MAX. SPEED	60	60	60	60

TOPS CODE									
CARKND		AARKND			OPERATING PANEL No				
T	\$	V	T	\$	V	E	7	0	4

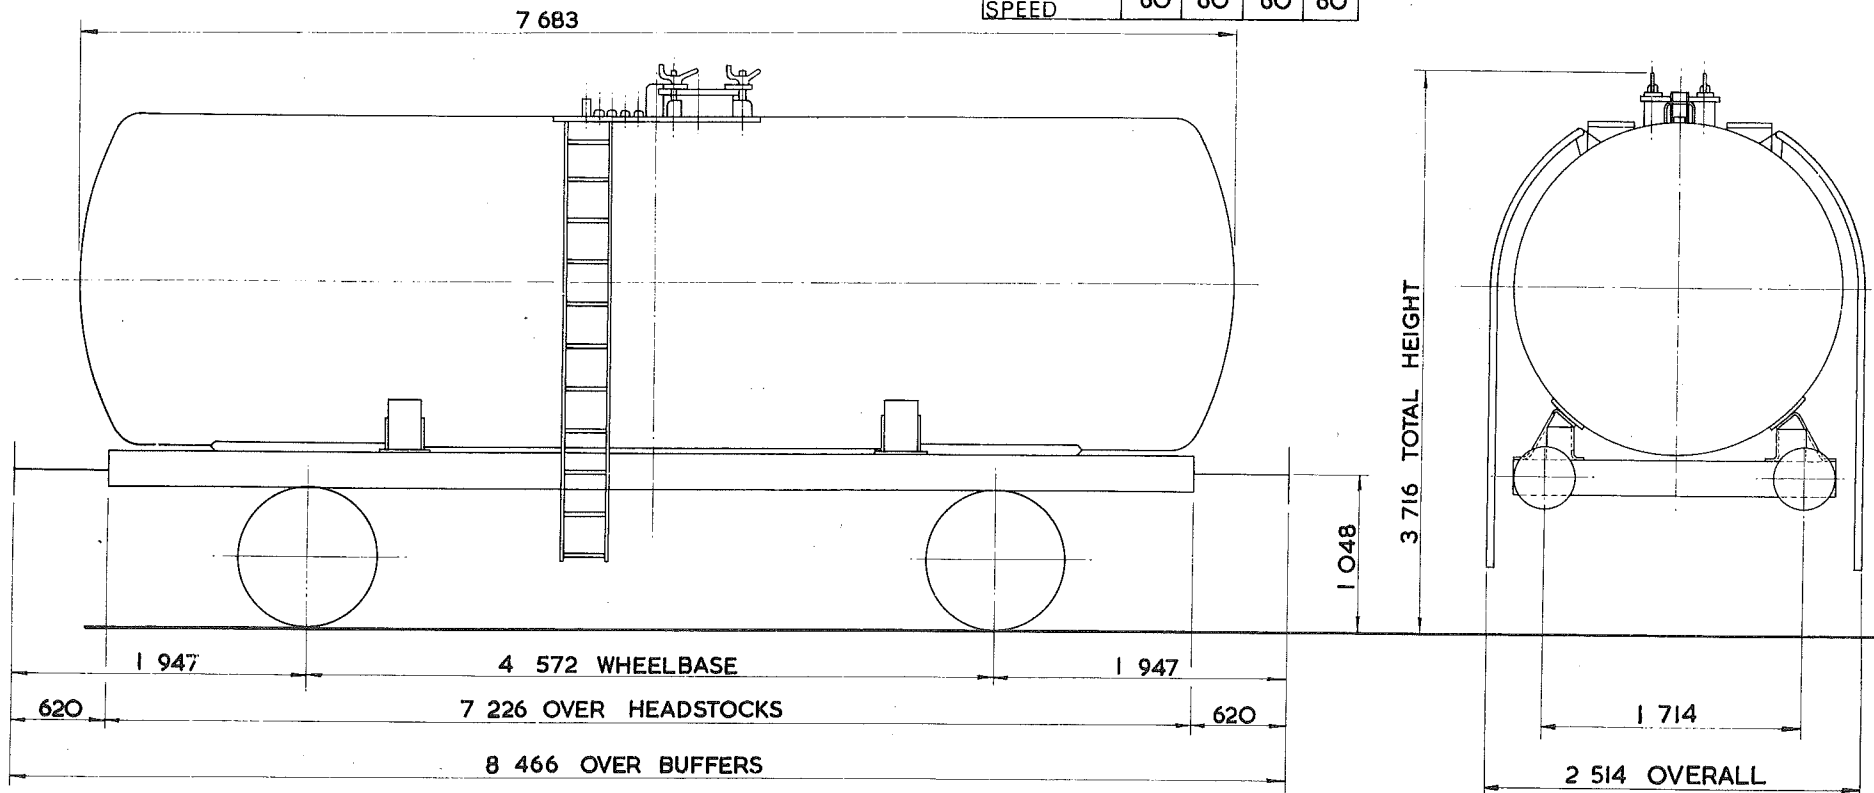

TARE - 12 350 kg
CARRYING CAPACITY - 23 000 kg
CAPACITY - 26.667 litres
MAX. SPEED - 60 mile/h
WHEELS - 952 DIA.
JOURNALS - 124 DIA. ROLLER BEARINGS

BUFFERS - HYDRAULIC 406 DIA. HEADS
COUPLINGS - INTERNATIONAL SCREW
MIN. CURVE - 31 m
GEN. ARRGT. DRG. No. -
BRAKE - VACUUM BLOCK & HAND LEVER
SUSPENSION - EYEBOLT


BUILDER - POWELL DUFFRYN
OWNER - ESSO
REGISTERED BY - C.M. & E.E. (B.R.B.) DERBY
YEAR BUILT - 1961
REGISTRATION Nos. - 44087 TO 44138 (RANGE)
OWNERS Nos. - 4087 TO 4138 (RANGE)

36
35.5 tonnes G.L.W. TANK WAGON - CLASS.A.

T\$036A

EXCESS LENGTH	4	H	M	L	E
tonnes	35	35	13	13	
VB	16	16	7	7	
AB					
RA	4	4	1	1	
MAX. SPEED	60	60	60	60	

TOPS CODE									
CARKND		AARKND			OPERATING PANEL No.				
T	\$	V	T	\$	V	E	7	0	1

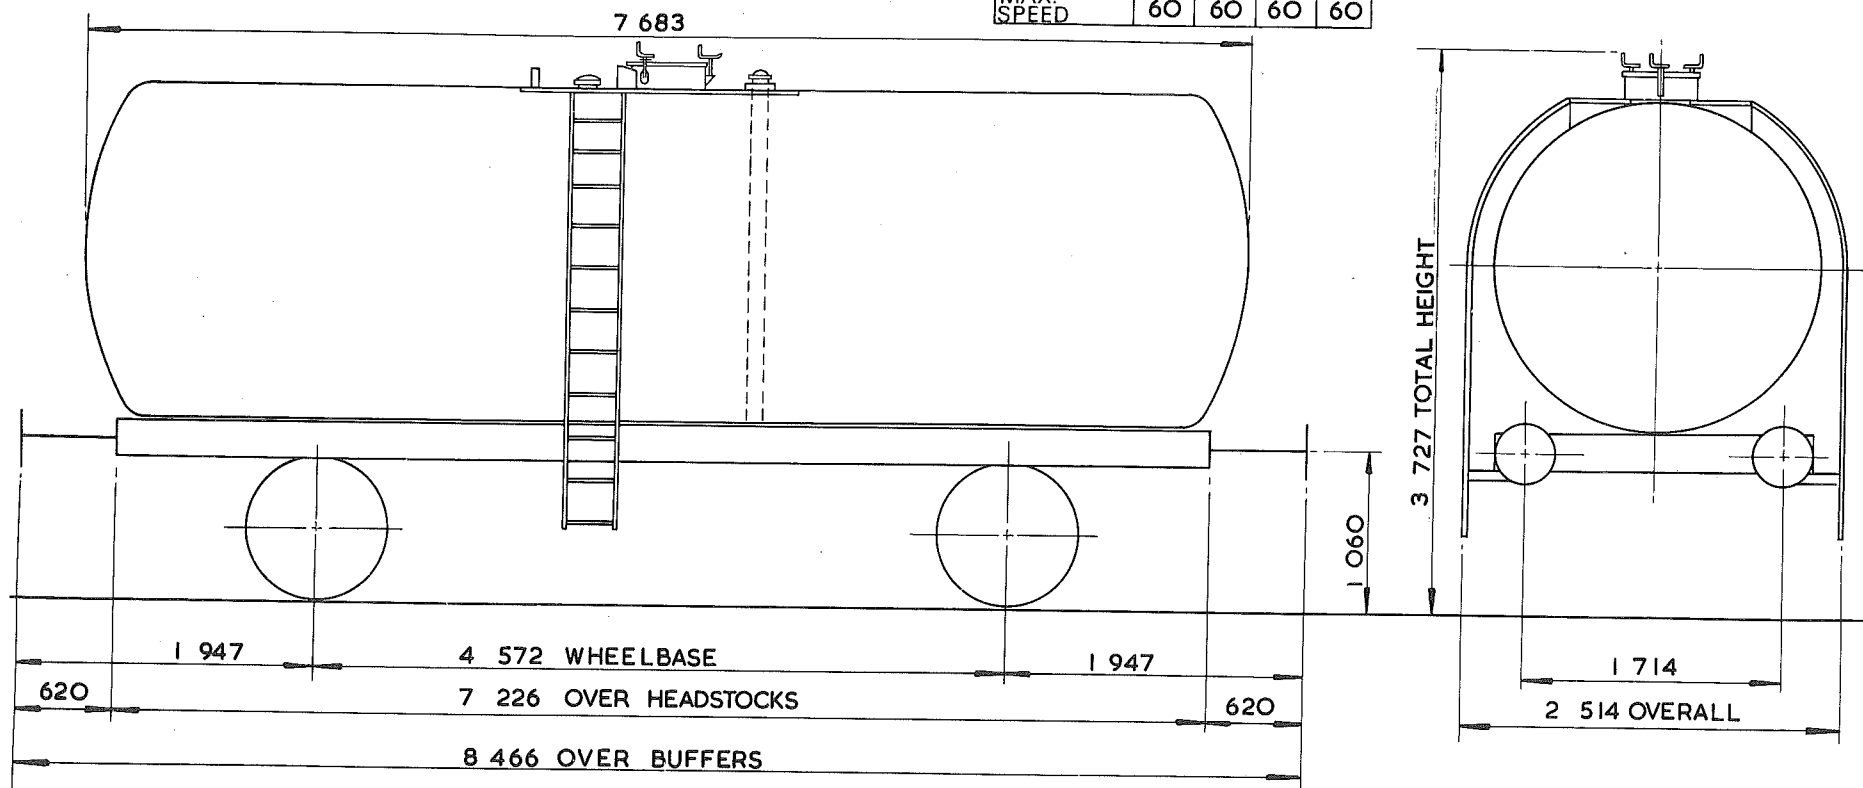

TARE -	12 550 kg
CARRYING CAPACITY	22 500 kg
CAPACITY	27 953 litres
MAX. SPEED -	60 mile/h
WHEELS -	952 DIA
JOURNALS -	124 DIA ROLLER BEARINGS.

BUFFERS -	HYDRAULIC 406 DIA. HEADS.
COUPLINGS -	INTERNATIONAL SCREW
MIN. CURVE -	31 m
GEN. ARRGT. DRG. No. -	
BRAKE -	VACUUM BLOCK & HAND LEVER.
SUSPENSION -	PRIMARY COIL - PEDESTAL


BUILDER -	METRO + CAMELL
OWNER -	ESSO
REGISTERED BY -	C.M. & E.E. (B.R.B.) DERBY.
YEAR BUILT -	1963
REGISTRATION Nos. -	44 302
OWNERS Nos. -	4302

36
~~35.5~~ tonnes G.L.W. TANK WAGON — CLASS A

T\$O36B

EXCESS LENGTH	4	H	M	L	E
tonnes	35	35	13	13	
VB	16	16	7	7	
AB					
RA	4	4	1	1	
MAX. SPEED	60	60	60	60	

TOPS CODE					
CARKND	AARKND		OPERATING PANEL No.		
T	\$	V	T	\$	V E 7 0 1

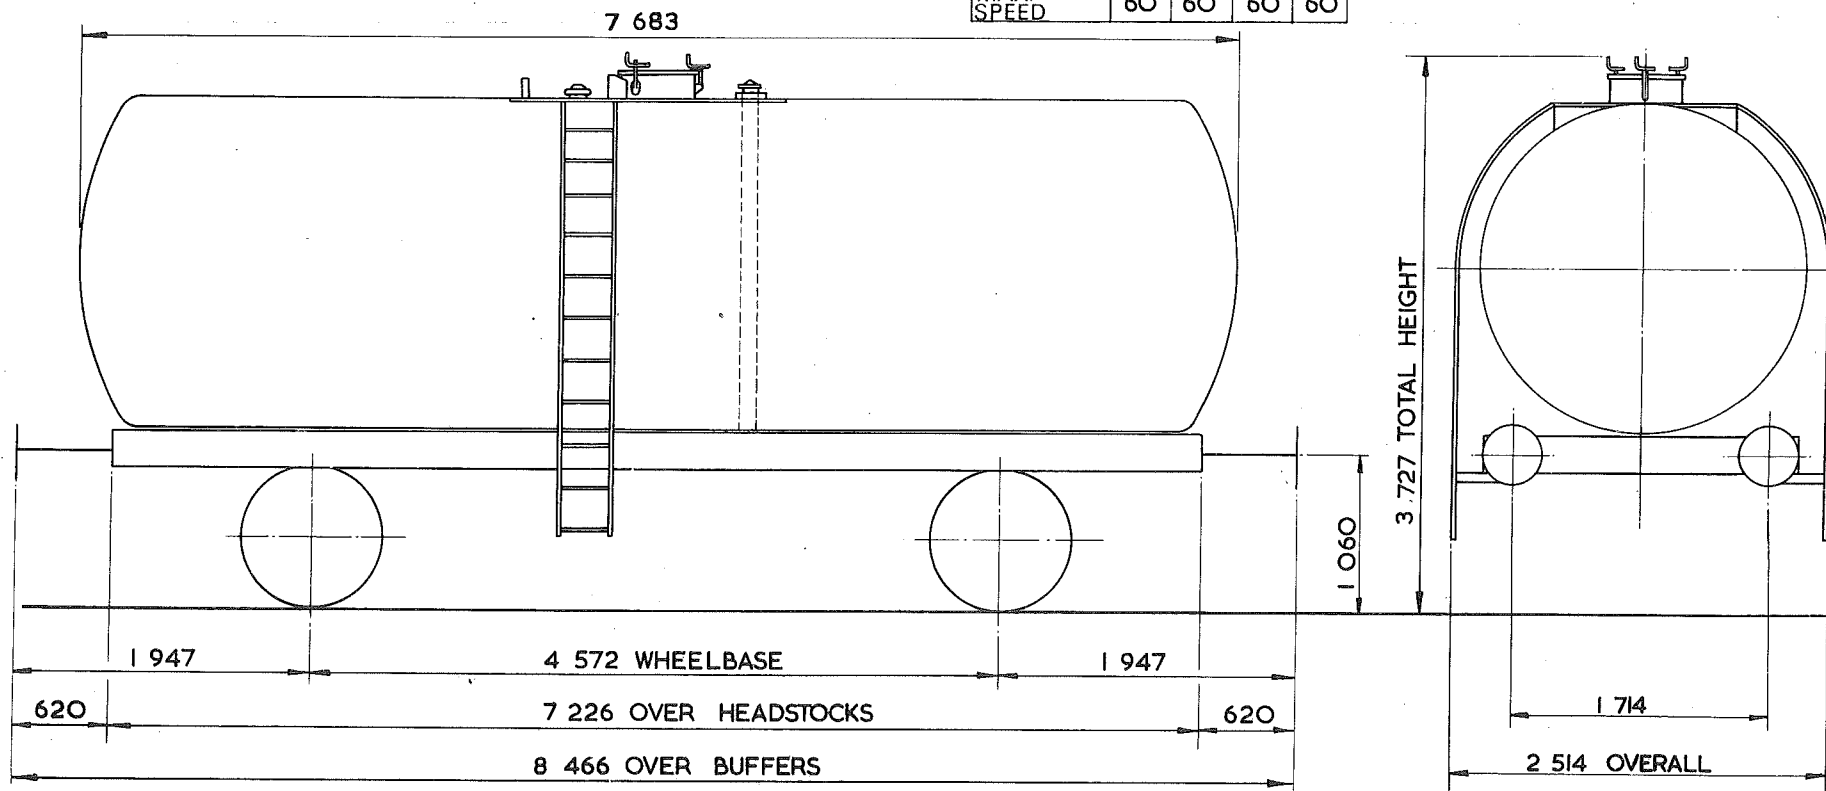

TARE — 12 550 kg
CARRYING CAPACITY — 22 500 kg
CAPACITY — 27 953 litres
MAX. SPEED — 60 mile/h
WHEELS — 952 DIA.
JOURNALS — 124 DIA. ROLLER BEARINGS

BUFFERS — HYDRAULIC 406 DIA. HEADS
COUPLINGS — INTERNATIONAL SCREW
MIN. CURVE — 31 m
GEN. ARRGT. DRG. No. —
BRAKE — VACUUM BLOCK & HAND LEVER
SUSPENSION — EYEBOLT


BUILDER — METRO - CAMELL
OWNER — ESSO
REGISTERED BY — C.M. & E.E. (B.R.B.) DERBY
YEAR BUILT — 1963
REGISTRATION Nos. — 44282 TO 44323 (RANGE)
OWNERS Nos. — 4282 TO 4323 (RANGE)

TANK WAGON

T\$036C

EXCESS LENGTH	4	H	M	L	E
tonnes	35	35	35	13	
VB	16	16	7	7	
AB					
RA	4	4	1	1	
MAX. SPEED	60	60	60	60	

TOPS CODE									
CARKND			AARKND			OPERATING PANEL No.			
T	\$	V	T	\$	V	E	7	0	1

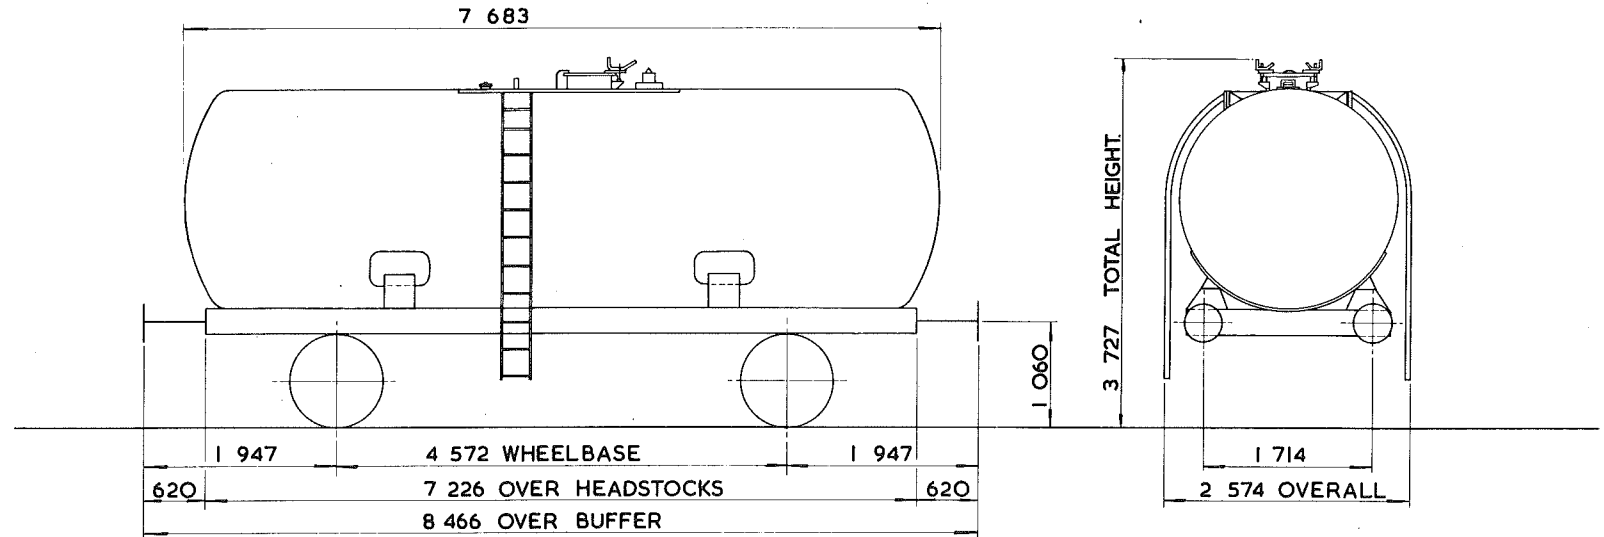

TARE - 12 400 Kg
CARRYING CAPACITY - 23 500 kg.
CAPACITY - 26 821 litres.
MAX. SPEED - 60 mile/h.
WHEELS - 952 DIA.
JOURNALS - 124 DIA. ROLLER BEARINGS

BUFFERS - PNEUMATIC 406 DIA. HEADS.
COUPLINGS - INTERNATIONAL SCREW
MIN. CURVE - 31 m.
GEN. ARRGT. DRG. No. -
BRAKE - VACUUM BLOCK & HAND LEVER.
SUSPENSION - EYEBOLT


BUILDER - CHARLES ROBERTS
OWNER - ESSO
REGISTERED BY - C.M. & E.E.(B.R.B.) DERBY
YEAR BUILT - 1962
REGISTRATION Nos. - 44329 TO 44363 (RANGE)
OWNERS Nos. - 4329 TO 4363 (RANGE)

TANK WAGON

T\$038A

EXCESS LENGTH	2	H	M	L	E
tonnes	35	32	15	15	
VB					
AB					
RA	4	3	1	1	
MAX. SPEED	45	45	45	45	

TOPS CODE					
CARKND	AARKND	OPERATING PANEL No.			
T	\$	Ø	T	\$	Ø
			E		
				9	2
					9

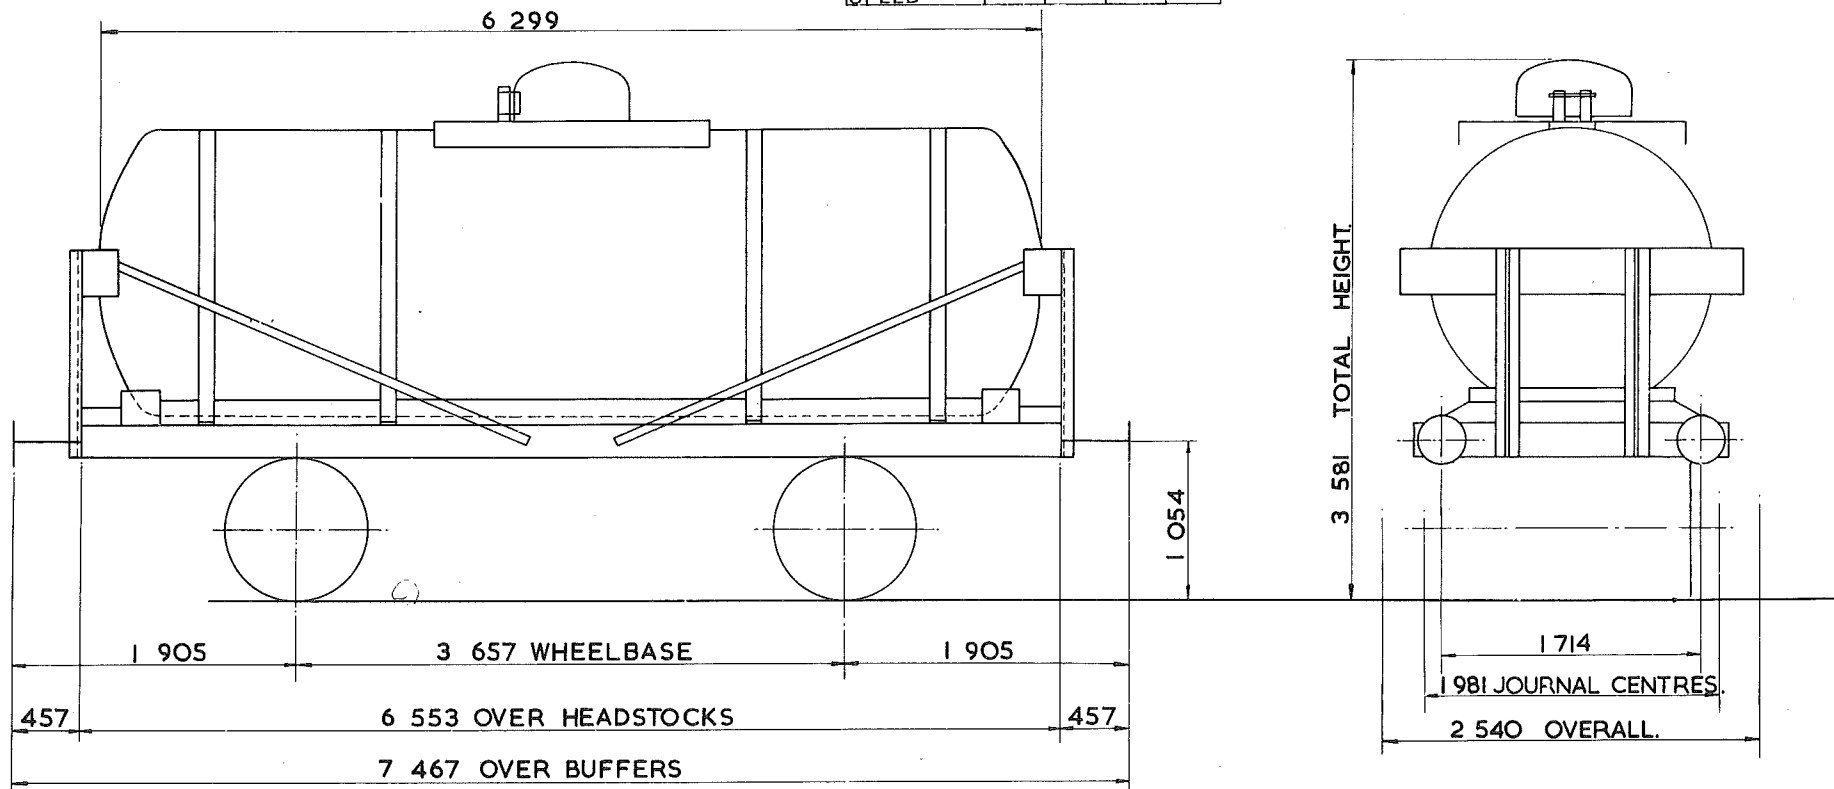

TARE - 15 240kg.
CARRYING CAPACITY - 20 500kg.
CAPACITY - 16 366 litres.
MAX. SPEED - 45 mile/h.
WHEELS - 952 DIA.
JOURNALS - 254 x 127 PLAIN BEARINGS.

BUFFERS - SELF CONTAINED 330 DIA. HEADS.
COUPLINGS - INSTANTER.
MIN. CURVE - 26m.
GEN. ARRGT. DRG. No. -
BRAKE - HAND LEVER.
SUSPENSION - SHOE.


BUILDER - R.Y. PICKERING LTD.
OWNER - I.C.I. MOND DIVISION.
REGISTERED BY - C.M. & E.E. (B.R.B.) DERBY.
YEAR BUILT - 1955
REGISTRATION Nos. - 47403-47414 (RANGE.)
OWNERS Nos. - 700-742 (RANGE.)

TANK WAGON

T\$O39A

EXCESS LENGTH	2	H	M	L	E
tonnes	35	35	15	15	
VB					
AB					
RA	4	4	1	1	
MAX. SPEED	45	45	45	45	

TOPS CODE									
CARKND		AARKND			OPERATING PANEL No.				
T	\$	Ø	T	\$	Ø	E	I	I	Ø

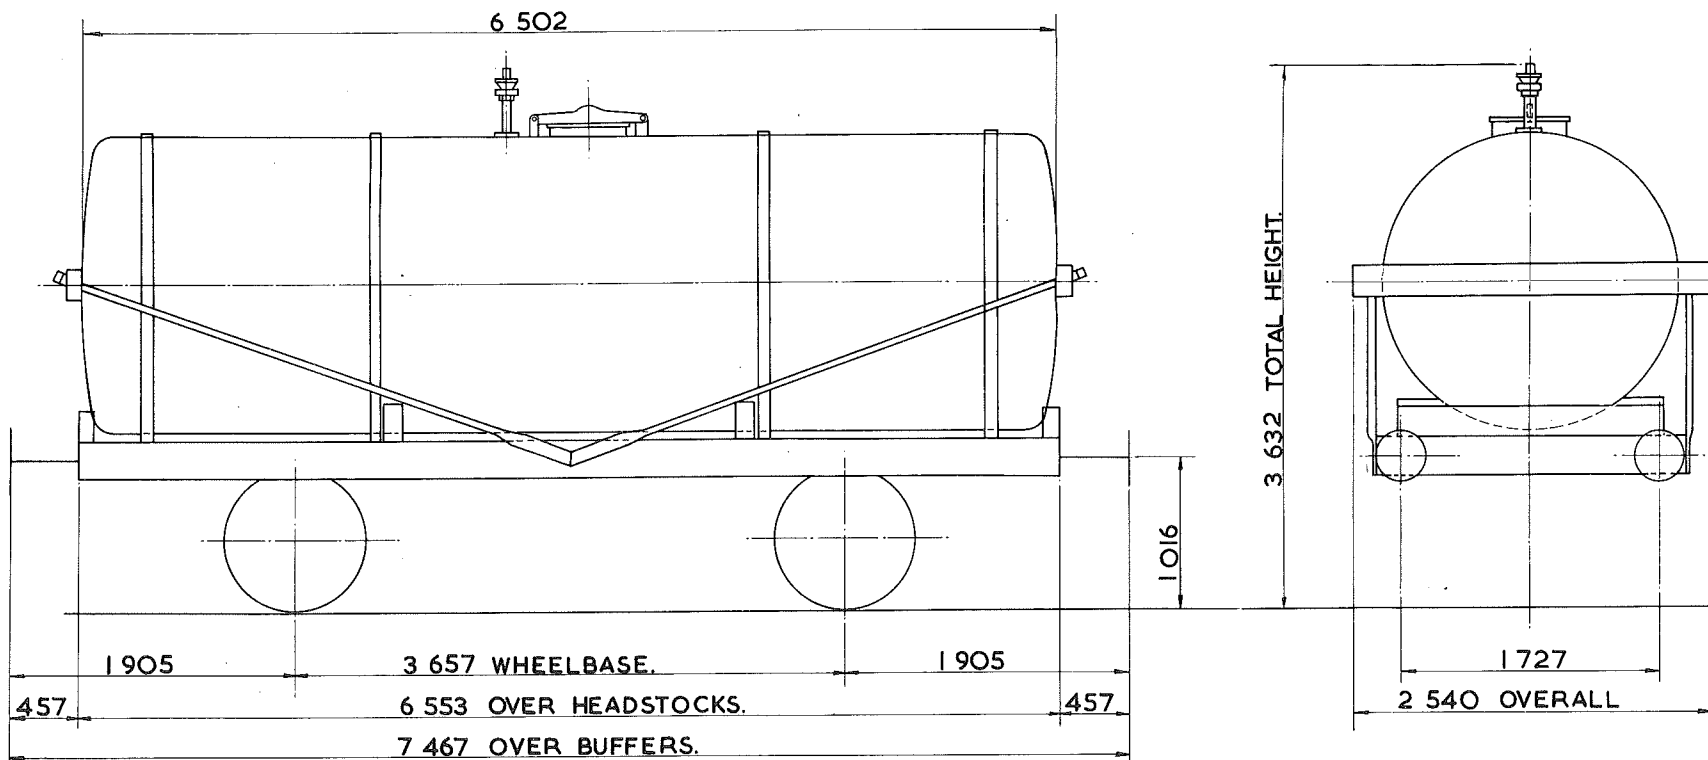

TARE - 13200kg.
CARRYING CAPACITY - 22500kg
CAPACITY - 17366 litres.
MAX. SPEED - 45 mile/h.
WHEELS - 952 DIA.
JOURNALS - 254 x 127 PLAIN BEARINGS

BUFFERS - SPINDLE 330 DIA. HEADS
COUPLINGS - INSTANTER.
MIN. CURVE - 26m.
GEN. ARRGT. DRG. No. -
BRAKE - HAND LEVER
SUSPENSION - SHOE.


BUILDER - CAMBRIAN WAGON WORKS, CARDIFF.
OWNER - N.C.B. SOUTH WALES.
REGISTERED BY - C.M. & E.E. (B.R.B.) DERBY.
YEAR BUILT - 1939 & 1940.
REGISTRATION Nos. - 48300-48345.
OWNERS Nos. - 7300-7345.

TANK WAGON.

T\$O 40A

EXCESS LENGTH	2	H	M	L	E
tonnes	35	35	15	15	
VB					
AB					
RA	4	4	1	1	
MAX. SPEED	45	45	45	45	

TOPS CODE									
CARKND		AARKND		OPERATING PANEL No.					
T	\$	Ø	T	\$	Ø	E	I	I	8

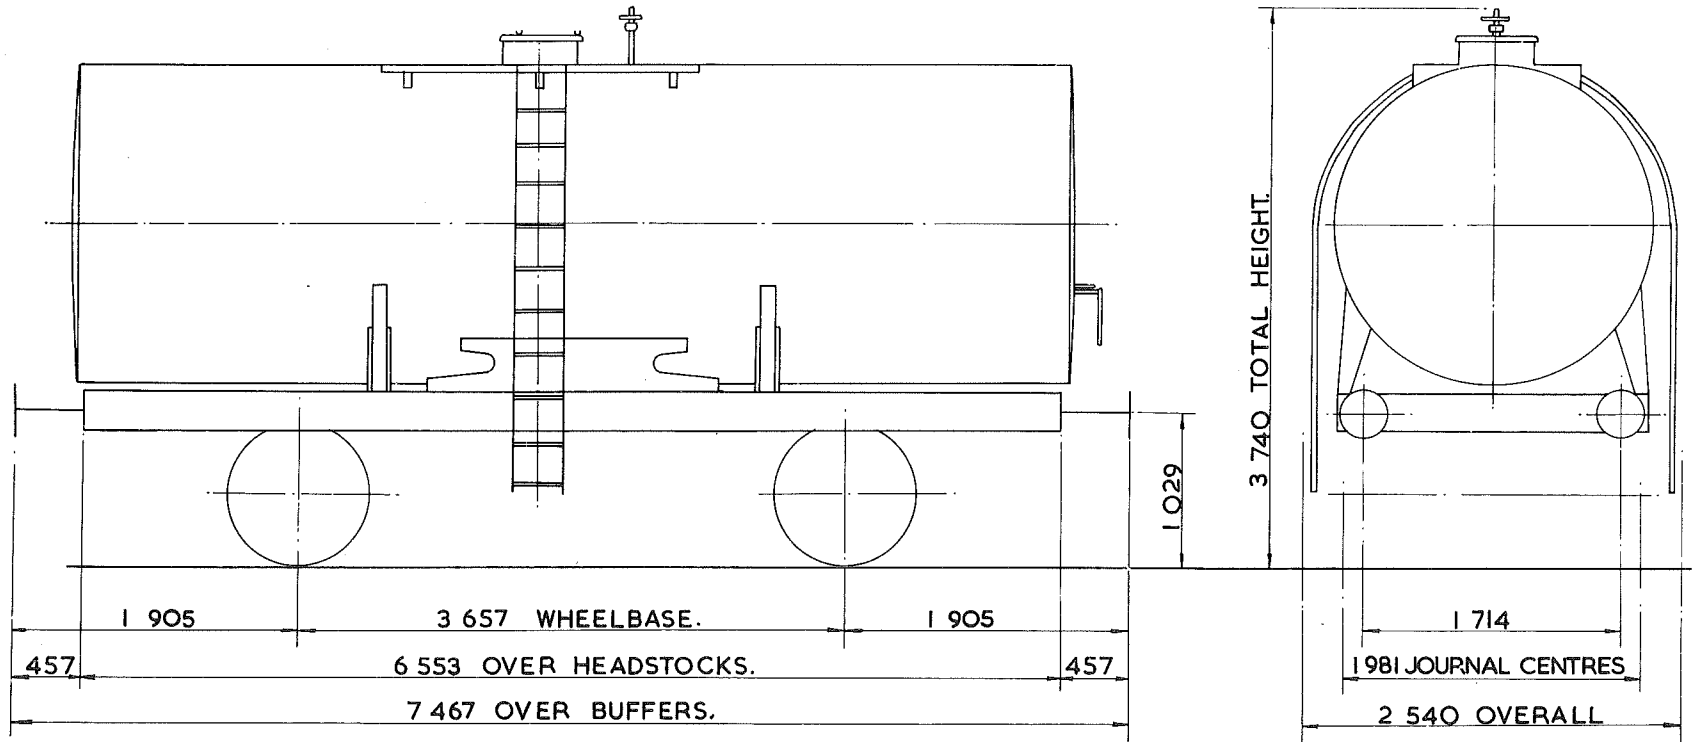

TARE - 16100 kg.
CARRYING CAPACITY - 19000 kg.
CAPACITY - 17366 litres.
MAX. SPEED - 45 mile/h
WHEELS - 952 DIA.
JOURNALS - 254 x 127 PLAIN BEARINGS.

BUFFERS - SPINDLE 330 DIA. HEADS.
COUPLINGS - INSTANTER.
MIN. CURVE - 26 m.
GEN. ARRGT. DRG. No. -
BRAKE - HAND LEVER.
SUSPENSION - SHOE.

BUILDER - CAMBRIAN WAGON WORKS
OWNER - N. C. B.
REGISTERED BY - C. M. & E. E. (B. R. B.) DERBY.
YEAR BUILT - 1953
REGISTRATION Nos. - 48354 - 48383.
OWNERS Nos. - 7354 TO 7383


³⁶
~~35.5~~ tonnes G.L.W. TANK WAGON - BUTANE

T\$043A

EXCESS LENGTH	5	H	M	L	E
tonnes	36	36	17	17	
VB	16	16	10	10	
AB					
RA	5	5	1	1	
MAX. SPEED	60	60	45 60	45 60	

TOPS CODE					
CARKND	AARKND		OPERATING PANEL No		
T	\$	V	T	\$	V E
					708

1217

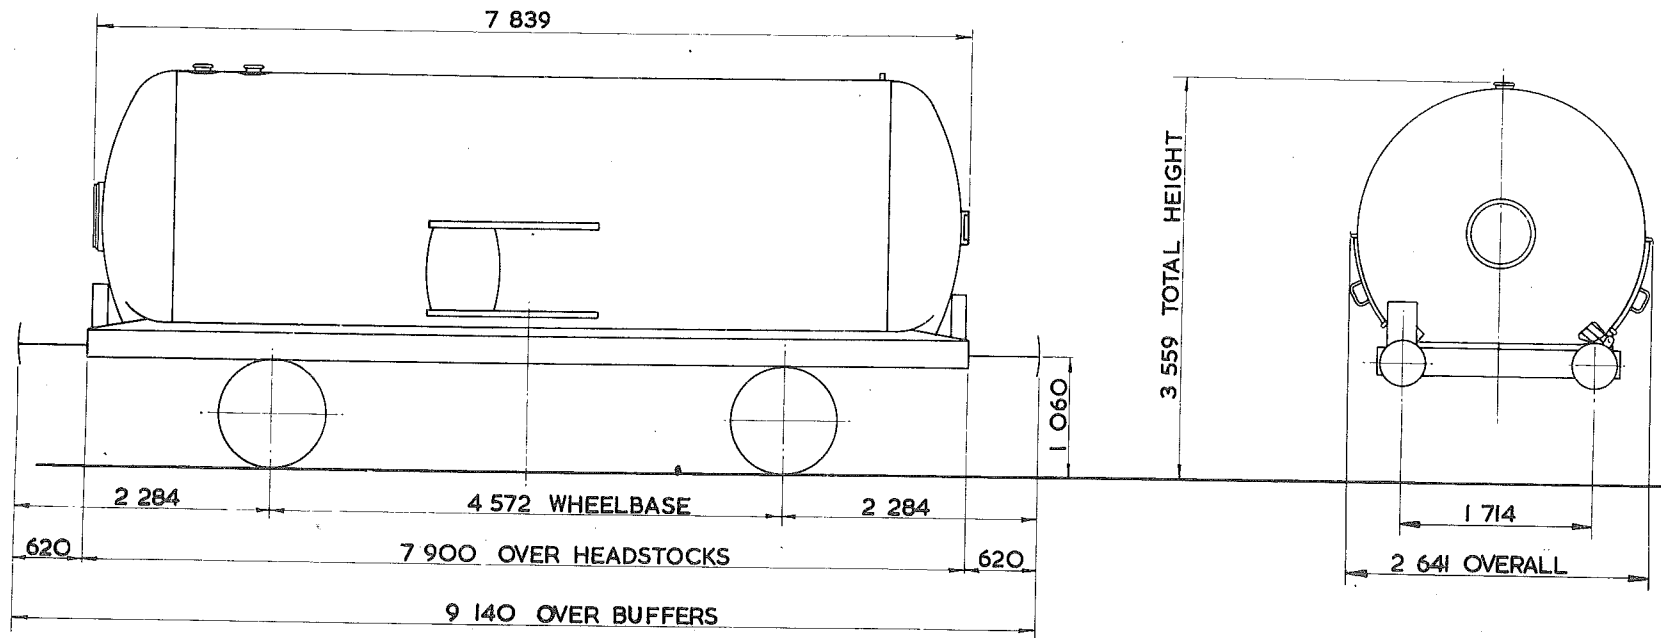

TARE - 16 500 kg
CARRYING CAPACITY - 19 500 kg
CAPACITY - 35 500 litres
MAX. SPEED - 60 mile/h
WHEELS - 952 DIA.
JOURNALS - 124 DIA. ROLLER BEARINGS

BUFFERS - HYDRAULIC 406 DIA. HEADS
COUPLINGS - INTERNATIONAL SCREW
MIN. CURVE - 31 m
GEN. ARRGT. DRG. No. -
BRAKE - VACUUM BLOCK & HAND LEVER
SUSPENSION - EYEBOLT


BUILDER - POWELL DUFFRYN
OWNER - ESSO
REGISTERED BY - C.M. & E.E. (B.R.B.) DERBY
YEAR BUILT - 1963
REGISTRATION Nos. - ⁴³¹⁰² 4310 TO 43120
OWNERS Nos. - 1 TO 20

³⁶
~~35.5~~ tonnes G.L.W. TANK WAGON

T\$O44A

EXCESS LENGTH	5	H	M	L	E
tonnes		36	36	17	17
VB		16	16	10	10
AB					
RA		5	5	1	1
MAX SPEED		60	60	30	30

TOPS CODE		
CARKND	AARKND	OPERATING PAN:
T	V	TVE
		1009
		1217

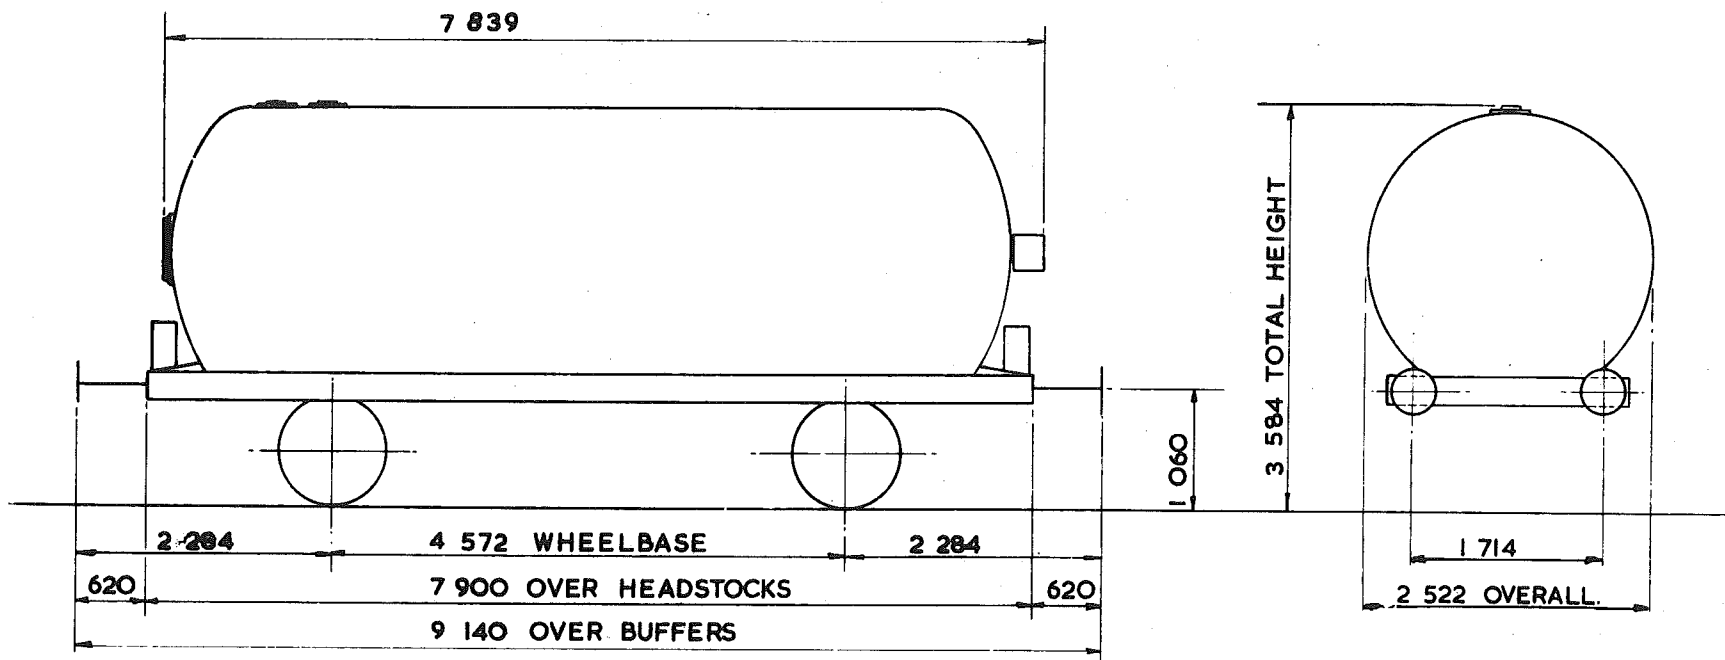

TARE -- 16750 kg
CARRYING CAPACITY -- 19500 kg.
CAPACITY -- 35 240 litres
MAX SPEED -- 60 mile/h
WHEELS -- 952 DIA
JOURNALS -- 124 DIA. ROLLER BEARINGS

BUFFERS -- HYDRAULIC 406 DIA. HEADS
COUPLINGS -- INTERNATIONAL SCREW
MIN. CURVE -- 31m
GEN. ARRGT. DRG. No. --
BRAKE -- VACUUM BLOCK & HAND LEVER
SUSPENSION -- EYE BOLT

BUILDER CHARLES ROBERTS
OWNER -- ESSO
REGISTERED BY C.M. & E.E. (B.R.B.) DERBY
YEAR BUILT 1963
REGISTRATION Nos. 43121-43140
OWNERS Nos. 21 TO 40


EX. P.O. DIAGRAM 6/45

~~35.5~~ tonnes G.L.W. TANK WAGON - CLASS A

T\$O45A

EXCESS LENGTH	4	H	M	L	E
tonnes.	36	36	13	13	
VB	16	16	7	7	
AB					
RA	5	5	1	1	
MAX SPEED	60	60	60	60	

TOPS CODE									
CARKND			AARKND			OPERATING PANEL No			
T	\$	V	T	\$	V	E	7	1	1

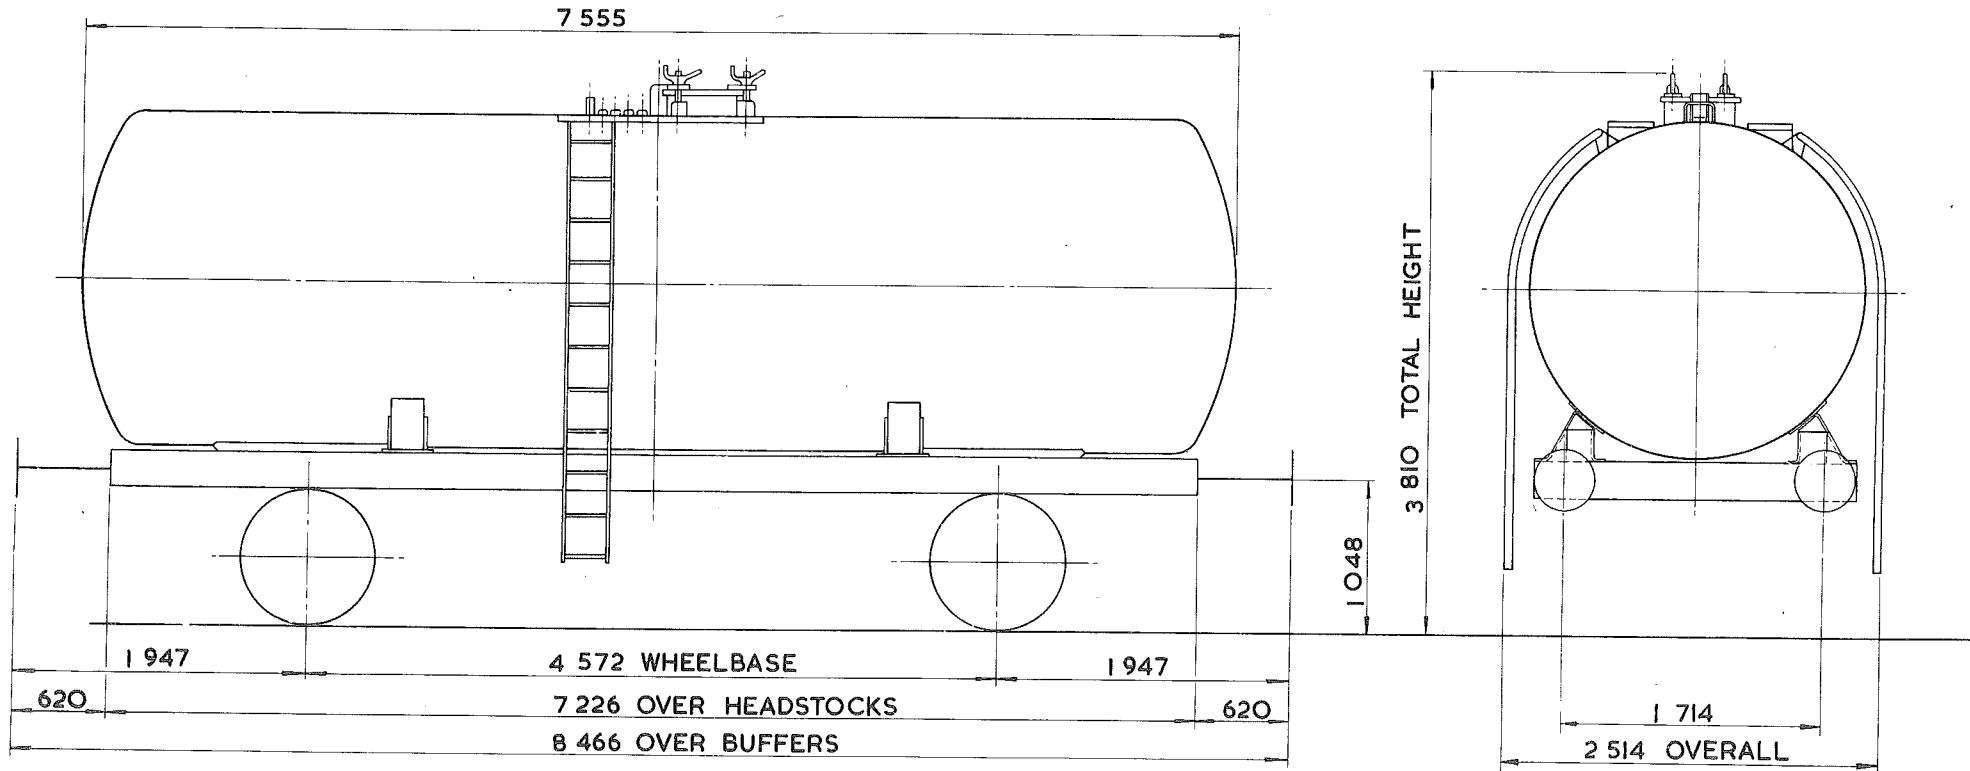

TARE - 12550kg.
CARRYING CAPACITY - 23500kg.
CAPACITY - 3167 litres.
MAX. SPEED - 60 mile/h.
WHEELS - 952 DIA.
JOURNALS - 124 DIA. ROLLER BEARINGS

BUFFERS - HYDRAULIC 406 DIA. HEADS.
COUPLING - INTERNATIONAL SCREW
MIN. CURVE - 31m.
GEN. ARRGT. DRG. No. -
BRAKE - VACUUM BLOCK & HAND LEVER.
SUSPENSION - EYEBOLT


BUILDER - POWELL DUFFRYN
OWNER - ESSO
REGISTERED BY - C.M. & E.E. (B.R.B.) DERBY
YEAR BUILT - 1962
REGISTRATION Nos. - 43289 TO 43299, 44253 TO 44281
OWNERS Nos. - 3289 TO 3299, 4253 TO 4281

36
35.5 tonnes G.L.W. TANK WAGON

T\$O46A.

EXCESS LENGTH	4	H	M	L	E
tonnes	36	36	13	13	
VB	16	16	7	7	
AB					
RA	5	5	1	1	
MAX. SPEED	60	60	60	60	

TOPS CODE					
CARKND	AARKND		OPERATING PANEL No.		
T	\$	V	T	\$	V E
					7 1 2

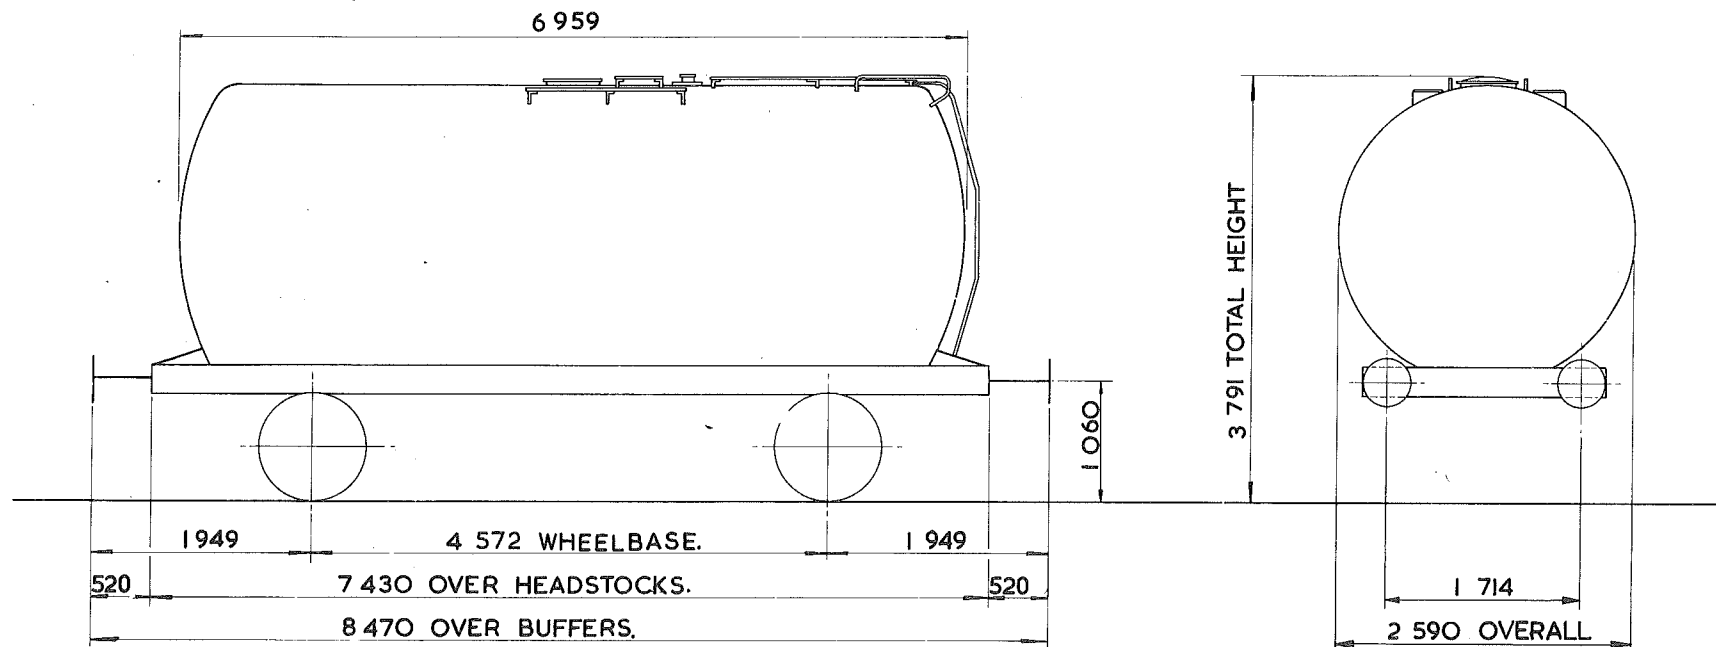

TARE - 11 850 kg
CARRYING CAPACITY - 24 000 kg
CAPACITY - 32 731 litres.
MAX. SPEED - 60 mile/h.
WHEELS - 952 DIA.
JOURNALS - 124 DIA. ROLLER BEARINGS

BUFFERS - HYDRAULIC 406 DIA. HEADS.
COUPLINGS - B.R. SCREW
MIN. CURVE - 31m.
GEN. ARRGT. DRG. No. -
BRAKE - VACUUM BLOCK & HAND LEVER.
SUSPENSION - EYEBOLT

BUILDER - CHARLES ROBERTS
OWNER - ESSO
REGISTERED BY - C.M. & E.E.(B.R.B.) DERBY
YEAR BUILT - 1963
REGISTRATION Nos. - 44365 TO 44424 (RANGE)
OWNERS Nos. - 4365 TO 4424 (RANGE)


EX PO. DIAGRAM 6/47

³⁶
~~35.5~~ tonnes G. L.W. TANK WAGON

T\$O47A

EXCESS LENGTH	5	H	M	L	E
tonnes.	36	36	16	16	
VB	16	16	10	10	
AB					
RA	5	5	1	1	
MAX. SPEED	60	60	60	60	

TOPS CODE									
CARKND		AARKND			OPERATING PANEL No.				
T	\$	V	T	\$	V	E	7	1	4

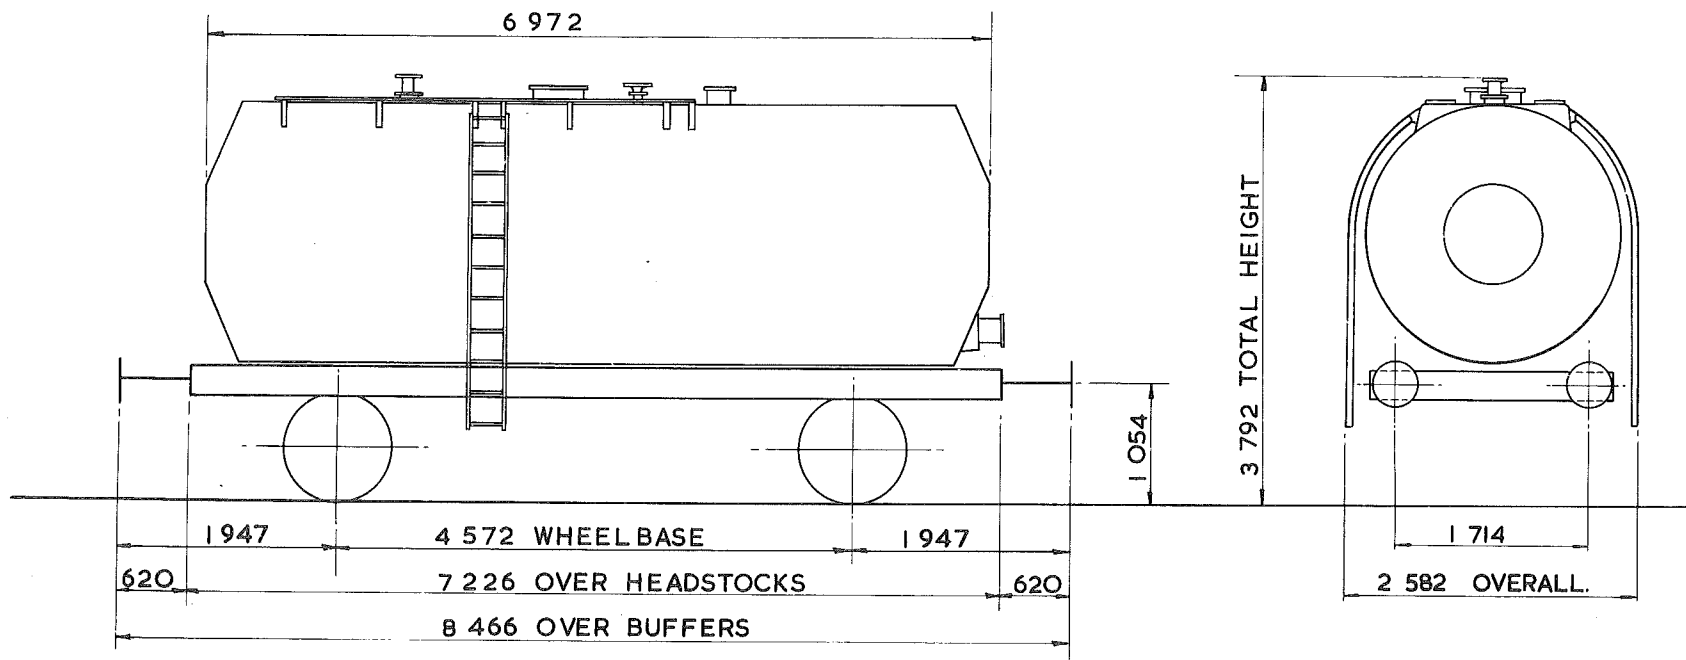

TARE - 15750kg.
CARRYING CAPACITY - 20 ⁵⁰⁰ kg.
CAPACITY - 23 ³¹² litres.
MAX. SPEED - 60 mile/h.
WHEELS - 952 DIA.
JOURNALS - 124 DIA. ROLLER BEARINGS

BUFFERS - HYDRAULIC 406 DIA. HEADS.
COUPLINGS - INTERNATIONAL SCREW.
MIN. CURVE - 31m.
GEN. ARRGT. DRG. No. -
BRAKE - VACUUM BLOCK & HAND LEVER.
SUSPENSION - EYE BOLT


BUILDER - CHARLES ROBERTS
OWNER - ESSO
REGISTERED BY - C.M. & E.E. (B.R.B.) DERBY.
YEAR BUILT - 1963
REGISTRATION Nos. 43190 TO 43199. 44425 TO 44444
OWNERS Nos. - 3190 TO 3199 - 4425 TO 4444

³⁶
~~35.5~~ tonnes G.L.W. TANK WAGON - BITUMEN

T\$O48A

EXCESS LENGTH	4	H	M	L	E
tonnes		36	36	13	13
VB		16	16	7	7
AB					
RA		5	5	1	1
MAX. SPEED		60	60	60	60

TOPS CODE										
CARKND		AARKND			OPERATING PANEL No					
T	\$	V	T	\$	V	E	7	1	1	1

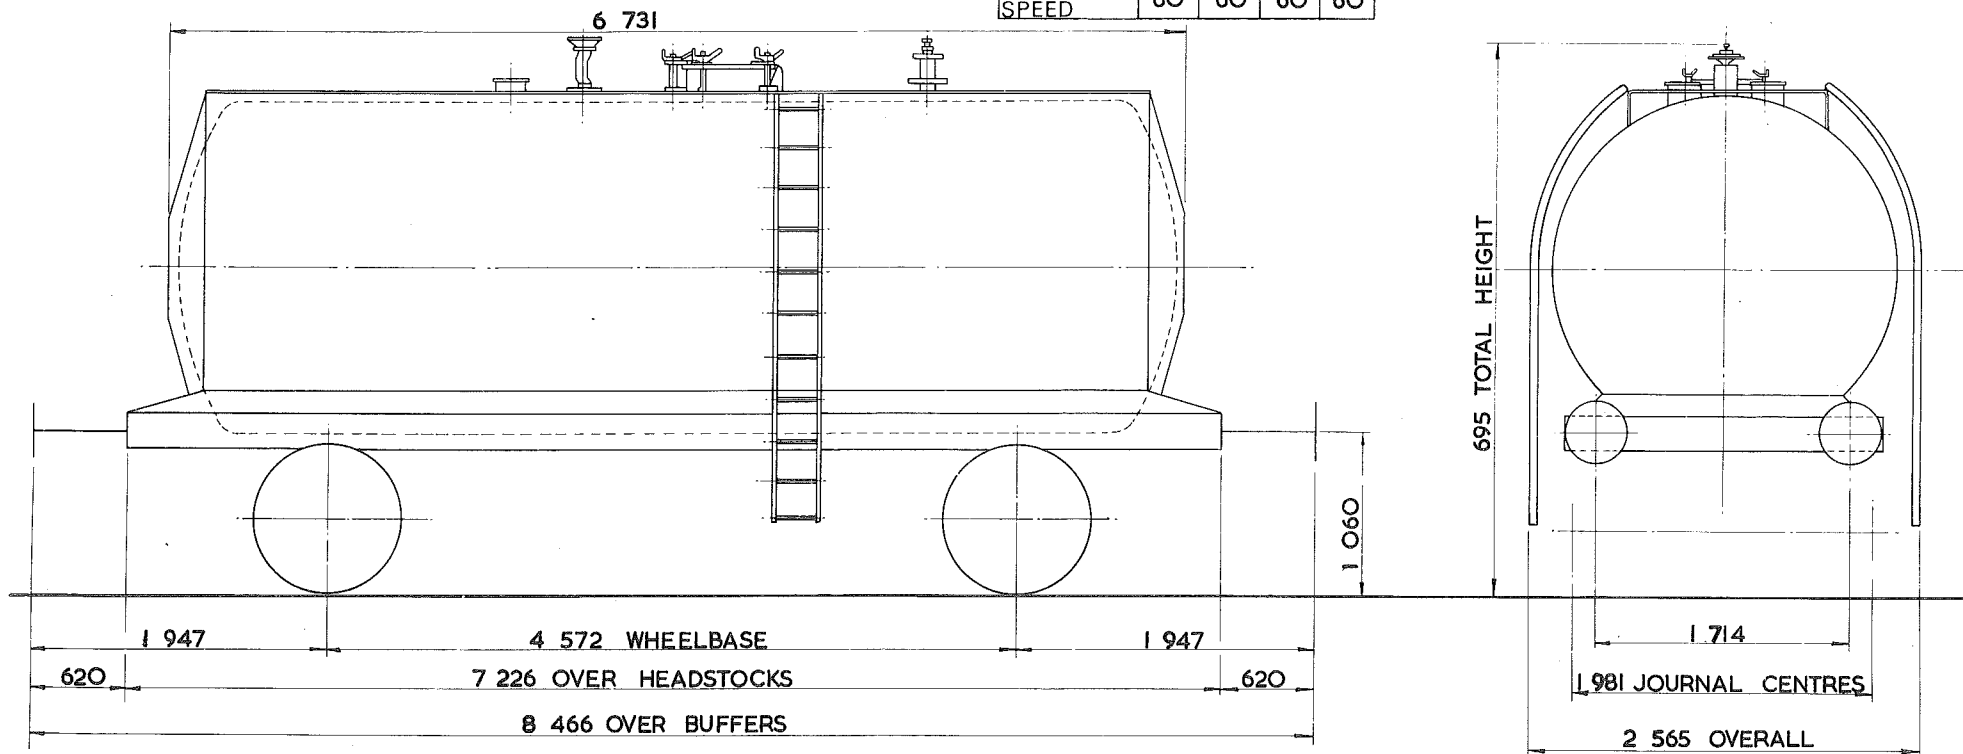

TARE - 13 250 kg
CARRYING CAPACITY - 23 000 kg
CAPACITY - 24 730 litres
MAX. SPEED - 60 mile/h
WHEELS - 952 DIA
JOURNALS - 124 DIA. ROLLER BEARINGS

BUFFERS - HYDRAULIC 406 DIA. HEADS
COUPLINGS - INTERNATIONAL SCREW
MIN. CURVE - 31 m
GEN. ARRGT. DRG. No. -
BRAKE - VACUUM BLOCK & HAND LEVER
SUSPENSION - EYEBOLT


BUILDER - POWELL DUFFRYN
OWNER - ESSO
REGISTERED BY - C.M. & E.E. (B.R.B.) DERBY
YEAR BUILT - 1963
REGISTRATION Nos. - 44445 TO 44494
OWNERS Nos. - 4445 TO 4494

36
~~35.5~~ tonnes G.L.W TANK WAGON - CLASS A

T\$O49A

EXCESS LENGTH 4	H	M	L	E
tonnes	36	36	12	12
VB	16	16	7	7
AB				
RA	5	5	1	1
MAX. SPEED	60	60	60	60

TOPS CODE									
CARKND		AARKND		OPERATING PANEL No					
T	\$	V	T	\$	V	E	7	1	0

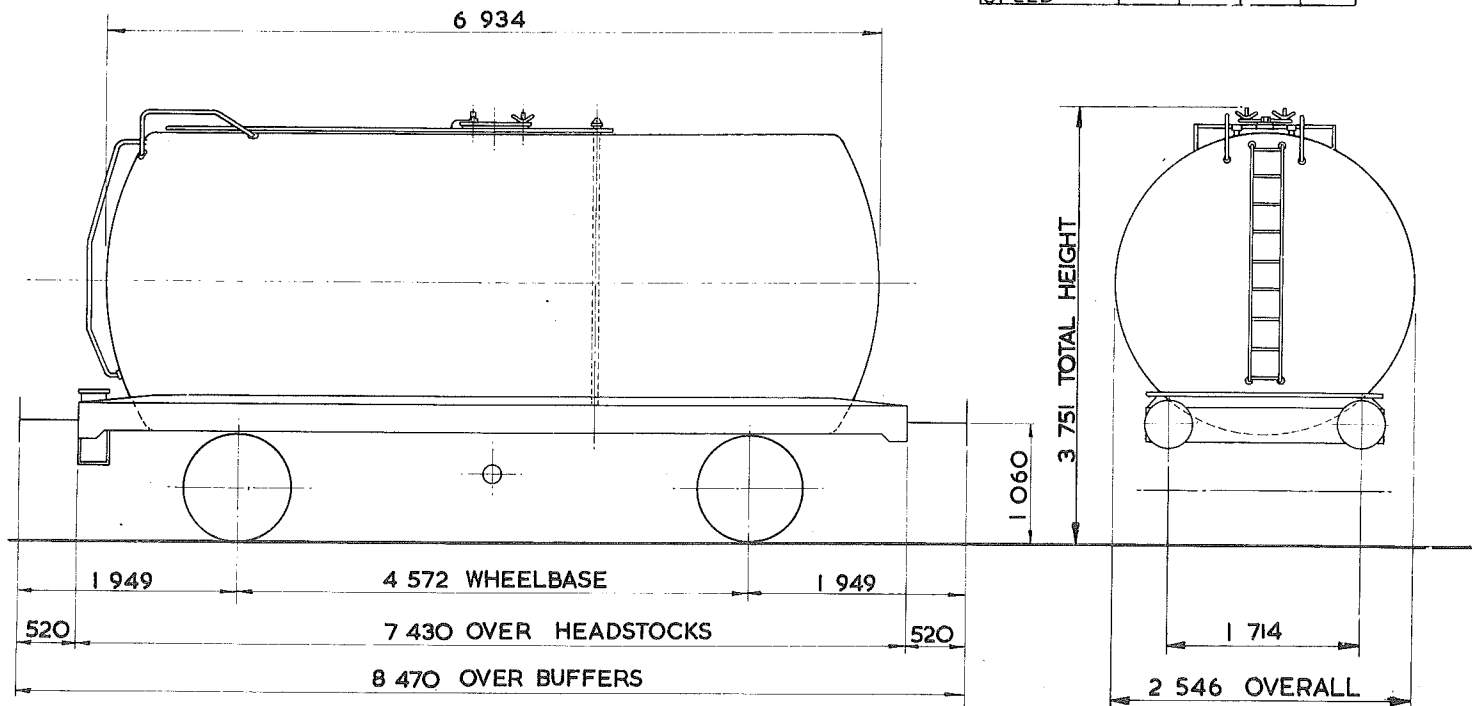

TARE - 11 350 kg
CARRYING CAPACITY - 24 500 kg
CAPACITY - 32 376 litres
MAX. SPEED - 60 mile/h
WHEELS - 952 DIA
JOURNALS - 124 DIA. ROLLER BEARINGS

BUFFERS - HYDRAULIC 406 DIA. HEADS
COUPLINGS - INSTANTER
MIN. CURVE - 31m
GEN. ARRGT. DRG. No. -
BRAKE - VACUUM BLOCK & HAND LEVER
SUSPENSION - EYEBOLT


BUILDER - POWELL DUFFRYN
OWNER - ESSO
REGISTERED BY - C.M. & E.E. (B.R.B) DERBY
YEAR BUILT - 1963
REGISTRATION Nos. - 45001 TO 45100 (RANGE)
OWNERS Nos. - 5001 TO 5100 (RANGE)

³⁶
~~35.5~~ tonnes G.L.W. TANK WAGON - CLASS. A.

T\$050A.

EXCESS LENGTH	4	H	M	L	E
tonnes	36	36	13	13	
VB	16	16	7	7	
AB					
RA	5	5	1	1	
MAX. SPEED	60	60	60	60	

TOPS CODE					
CARKND	AARKND		OPERATING PANEL No.		
T	\$	V	T	\$	V E
					7 1 2

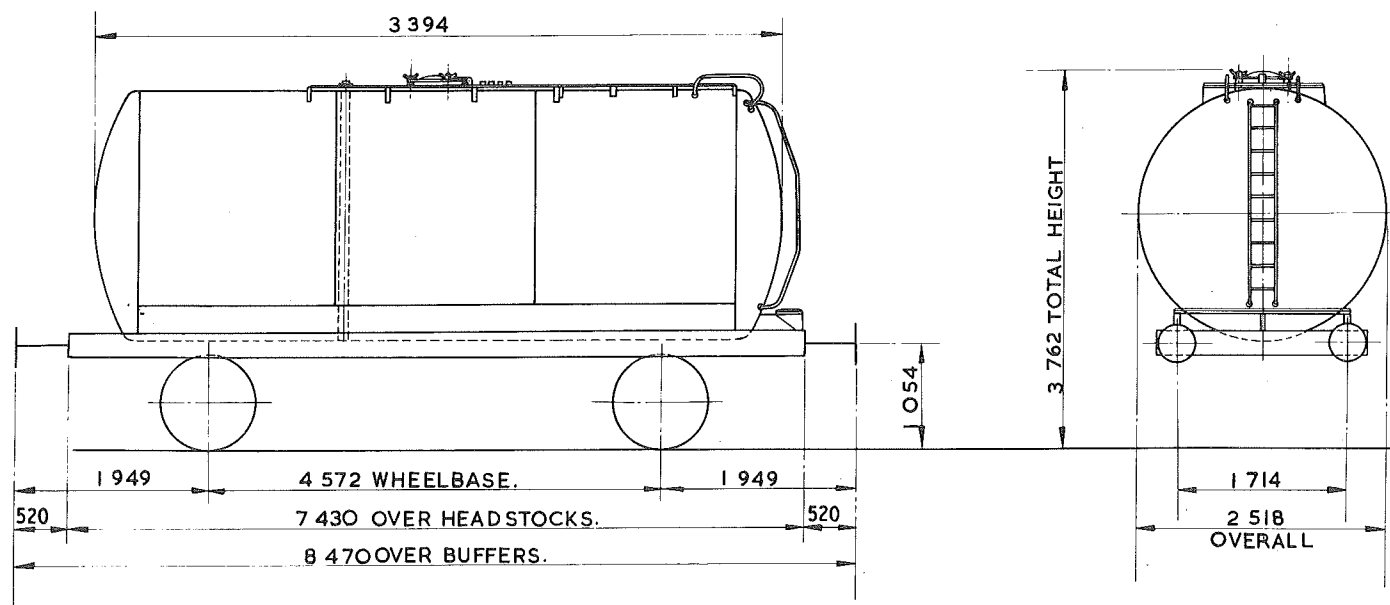

TARE -	11450kg.
CARRYING CAPACITY -	24500kg.
CAPACITY -	30458 litres.
MAX. SPEED -	60 mile/h.
WHEELS -	952 DIA.
JOURNALS -	124 DIA. ROLLER BEARINGS.

BUFFERS -	HYDRAULIC 406 DIA. HEADS.
COUPLINGS -	INSTANTER.
MIN. CURVE -	31m.
GEN. ARRGT. DRG. No. -	
BRAKE -	VACUUM BLOCK & HAND LEVER.
SUSPENSION -	EYEBOLT.


BUILDER -	NORBRIT PICKERING LTD.
OWNER -	ESSO.
REGISTERED BY -	C.M. & E.E. (B.R.B.) DERBY
YEAR BUILT -	1964.
REGISTRATION Nos. -	45101 TO 45300. (RANGE.)
OWNERS Nos. -	5200 TO 5300. (RANGE.)

36 tonnes G.L.W. TANK WAGON - CLASS A

T\$050B

EXCESS LENGTH	4	H	M	L	E
tonnes	36	36	13	13	
VB	16	16	7	7	
AB					
RA	5	1	1	1	
MAX. SPEED	60	60	60	60	

TOPS CODE									
CARKND			AARKND				OPERATING PANEL No.		
T	S	V	T	S	V	E	7	1	2

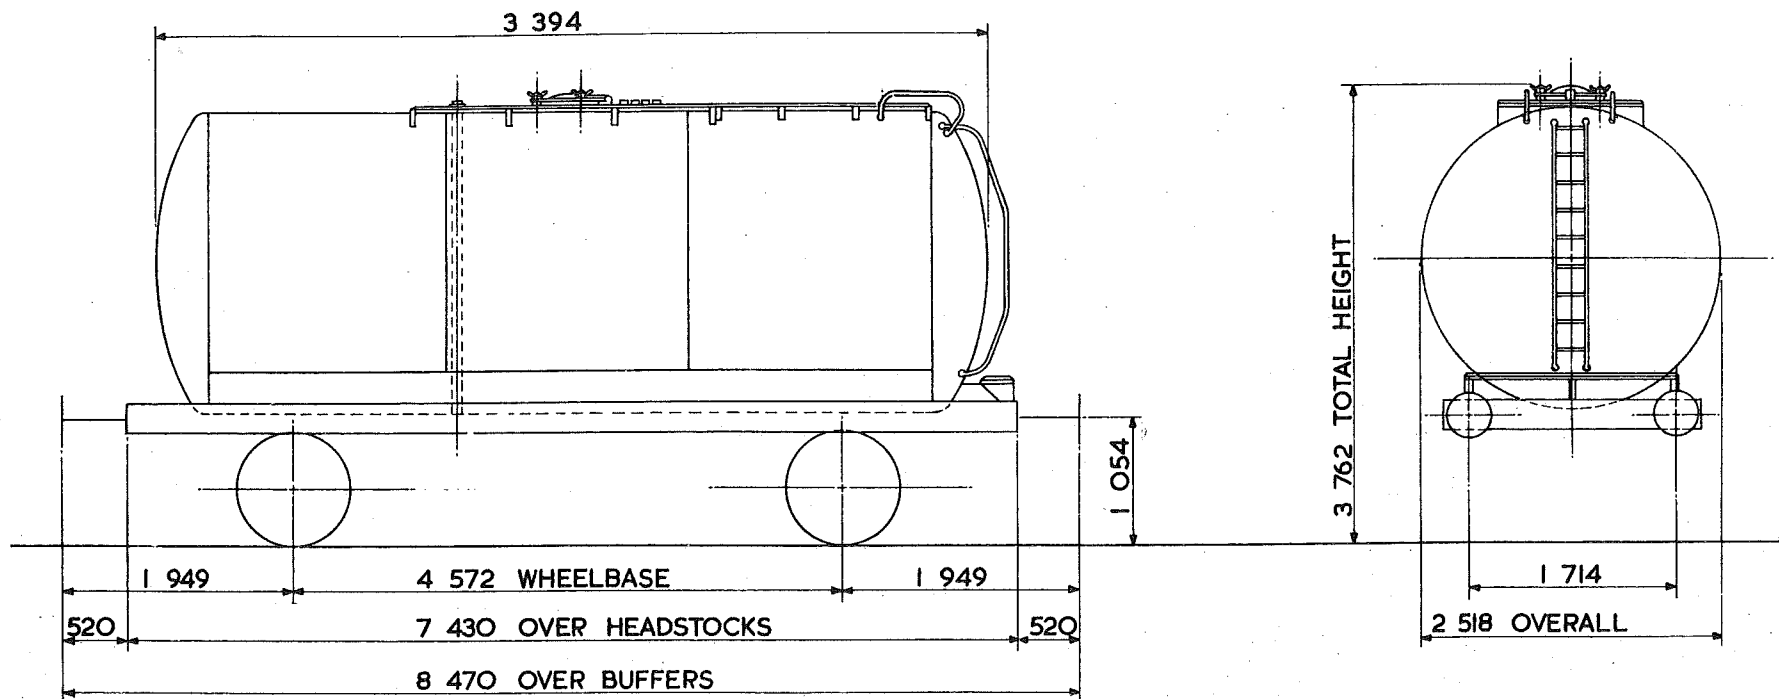

TARE-	11450 kg
CARRYING CAPACITY-	24500 kg
CAPACITY -	30458 litres
MAX. SPEED-	60 mile/h
WHEELS-	952 DIA.
JOURNALS-	124 DIA. ROLLER BEARINGS

BUFFERS-	HYDRAULIC 406 DIA. HEADS
COUPLINGS-	INSTANTER
MIN. CURVE-	31 m
GEN. ARRGT. DRG. No.-	
BRAKE-	VACUUM BLOCK & HAND LEVER
SUSPENSION-	EYEBOLT


BUILDER-	NORBRIT PICKERING LTD.
OWNER-	ESSO
REGISTERED BY-	C.M. & E.E. (B.R.B.) DERBY
YEAR BUILT-	1964
REGISTRATION Nos.-	45101 - 45199
OWNERS Nos.-	

~~35.5~~ tonnes G.L.W. TANK WAGON

T\$051A

EXCESS LENGTH	4	H	M	L	E
tonnes	36	36	13	13	
VB	16	16	7	7	
AB					
RA	5	5	1	1	
MAX. SPEED	60	60	60	60	

TOPS CODE					
CARKND	AARKND		OPERATING PANEL No		
T	\$	V	T	\$	V E
					7 1 2

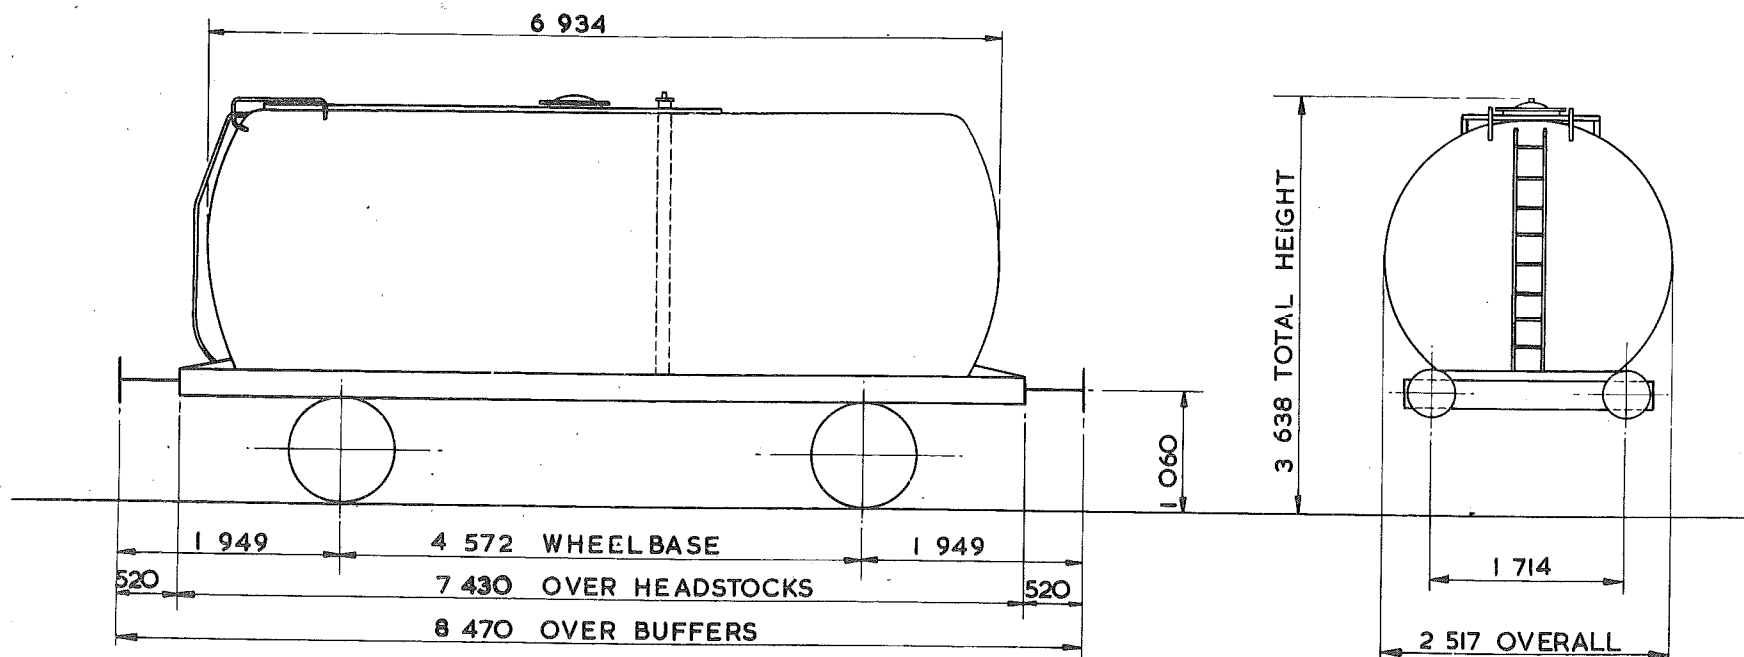

TARE - 11700 kg
CARRYING CAPACITY - 24500 kg.
CAPACITY - 31017 litres
MAX. SPEED - 60 mile/h
WHEELS - 952 DIA
JOURNALS - 124 DIA. ROLLER BEARINGS

BUFFERS - HYDRAULIC 406 DIA. HEADS
COUPLINGS - BR SCREW
MIN. CURVE - 31 m
GEN. ARRGT. DRG. No. -
BRAKE - VACUUM BLOCK & HAND LEVER
SUSPENSION - EYE BOLT

BUILDER - CHARLES ROBERTS
OWNER - ESSO
REGISTERED BY - C.M. & E.E. (B.R.B.) DERBY
YEAR BUILT - 1964
REGISTRATION Nos. - 45 301 - 45 350
OWNERS Nos. - 5301 TO 5350